


- General Notes
1. New work shown shaded
 2. Demolition shown dotted
 3. W: Wardrobe
Cpbd: Cupboard
RLA: Roof lantern above
RL: Roof light/lantern below
 4. All dimensions are indicative and in mm
 5. If shown levels indicated in red dotted

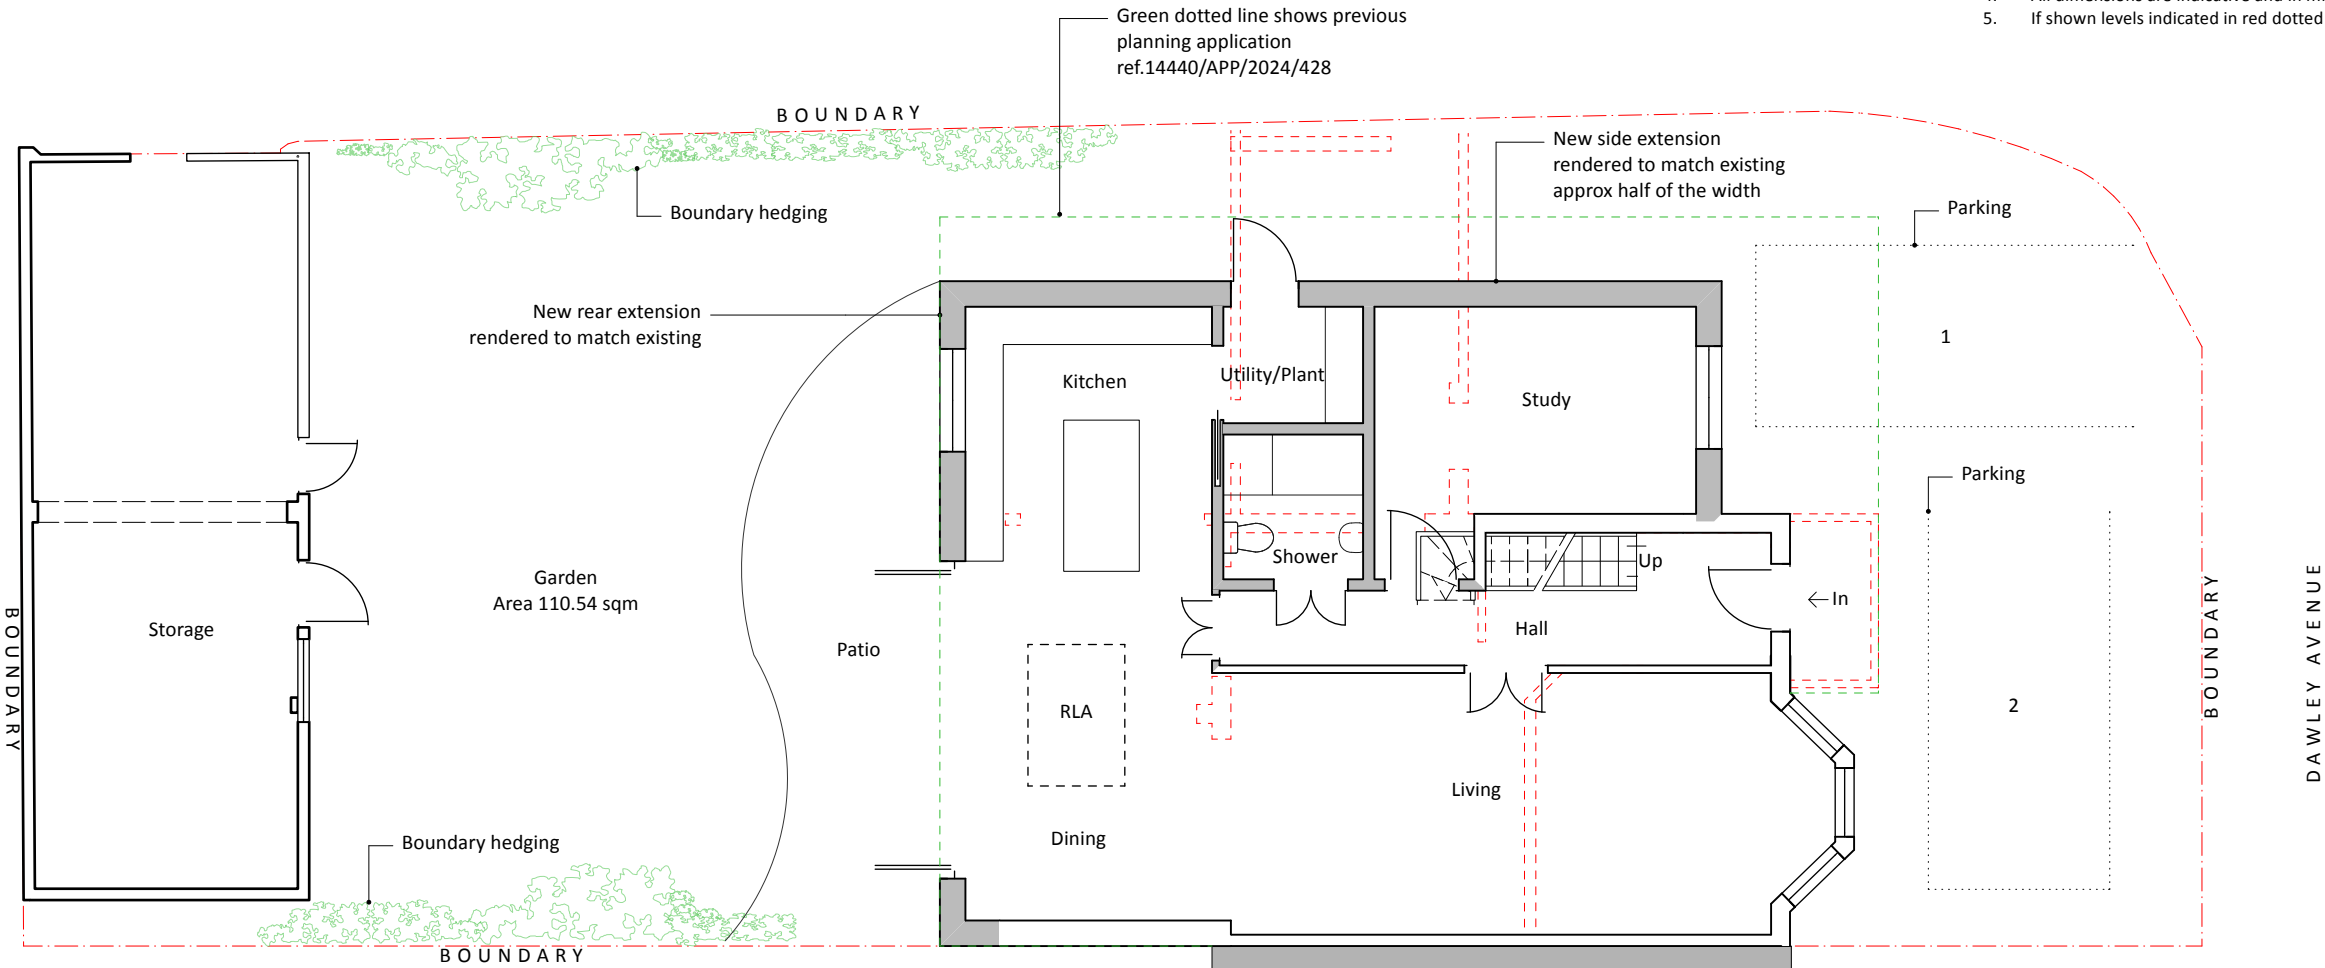

ISSUE	DATE	REVISION

PROJECT
28 Dawley Avenue, Uxbridge UB8 3BU

CLIENT
Mr & Mrs Dawrha

DRAWING
PROPOSED GROUND


STONES

ARCHITECTS

All rights described in chapter IV of the copyright designs & patents act 1988 have been asserted. This drawing must not be scaled; only figured dimensions should be used. Check and verify all dimensions on site prior to commencing any work. Any discrepancies should be reported to the Architects immediately.


PROJECT #	2025.044	DWG #	REV
DATE	10/11/2025		
SCALE	1:100		
DRAWN	CHKD		
PR	JC		

Stones Architects Ltd
50 Coldharbour Lane Hayes Middlesex UB3 3EP
t 020 8969 0000 e mail@stonesarchitects.co.uk w stonesarchitects.co.uk

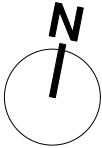

C01

- General Notes
1. New work shown shaded
 2. Demolition shown dotted
 3. W: Wardrobe
Cpbd: Cupboard
RLA: Roof lantern above
RL: Roof light/lantern below
 4. All dimensions are indicative and in mm
 5. If shown levels indicated in red dotted

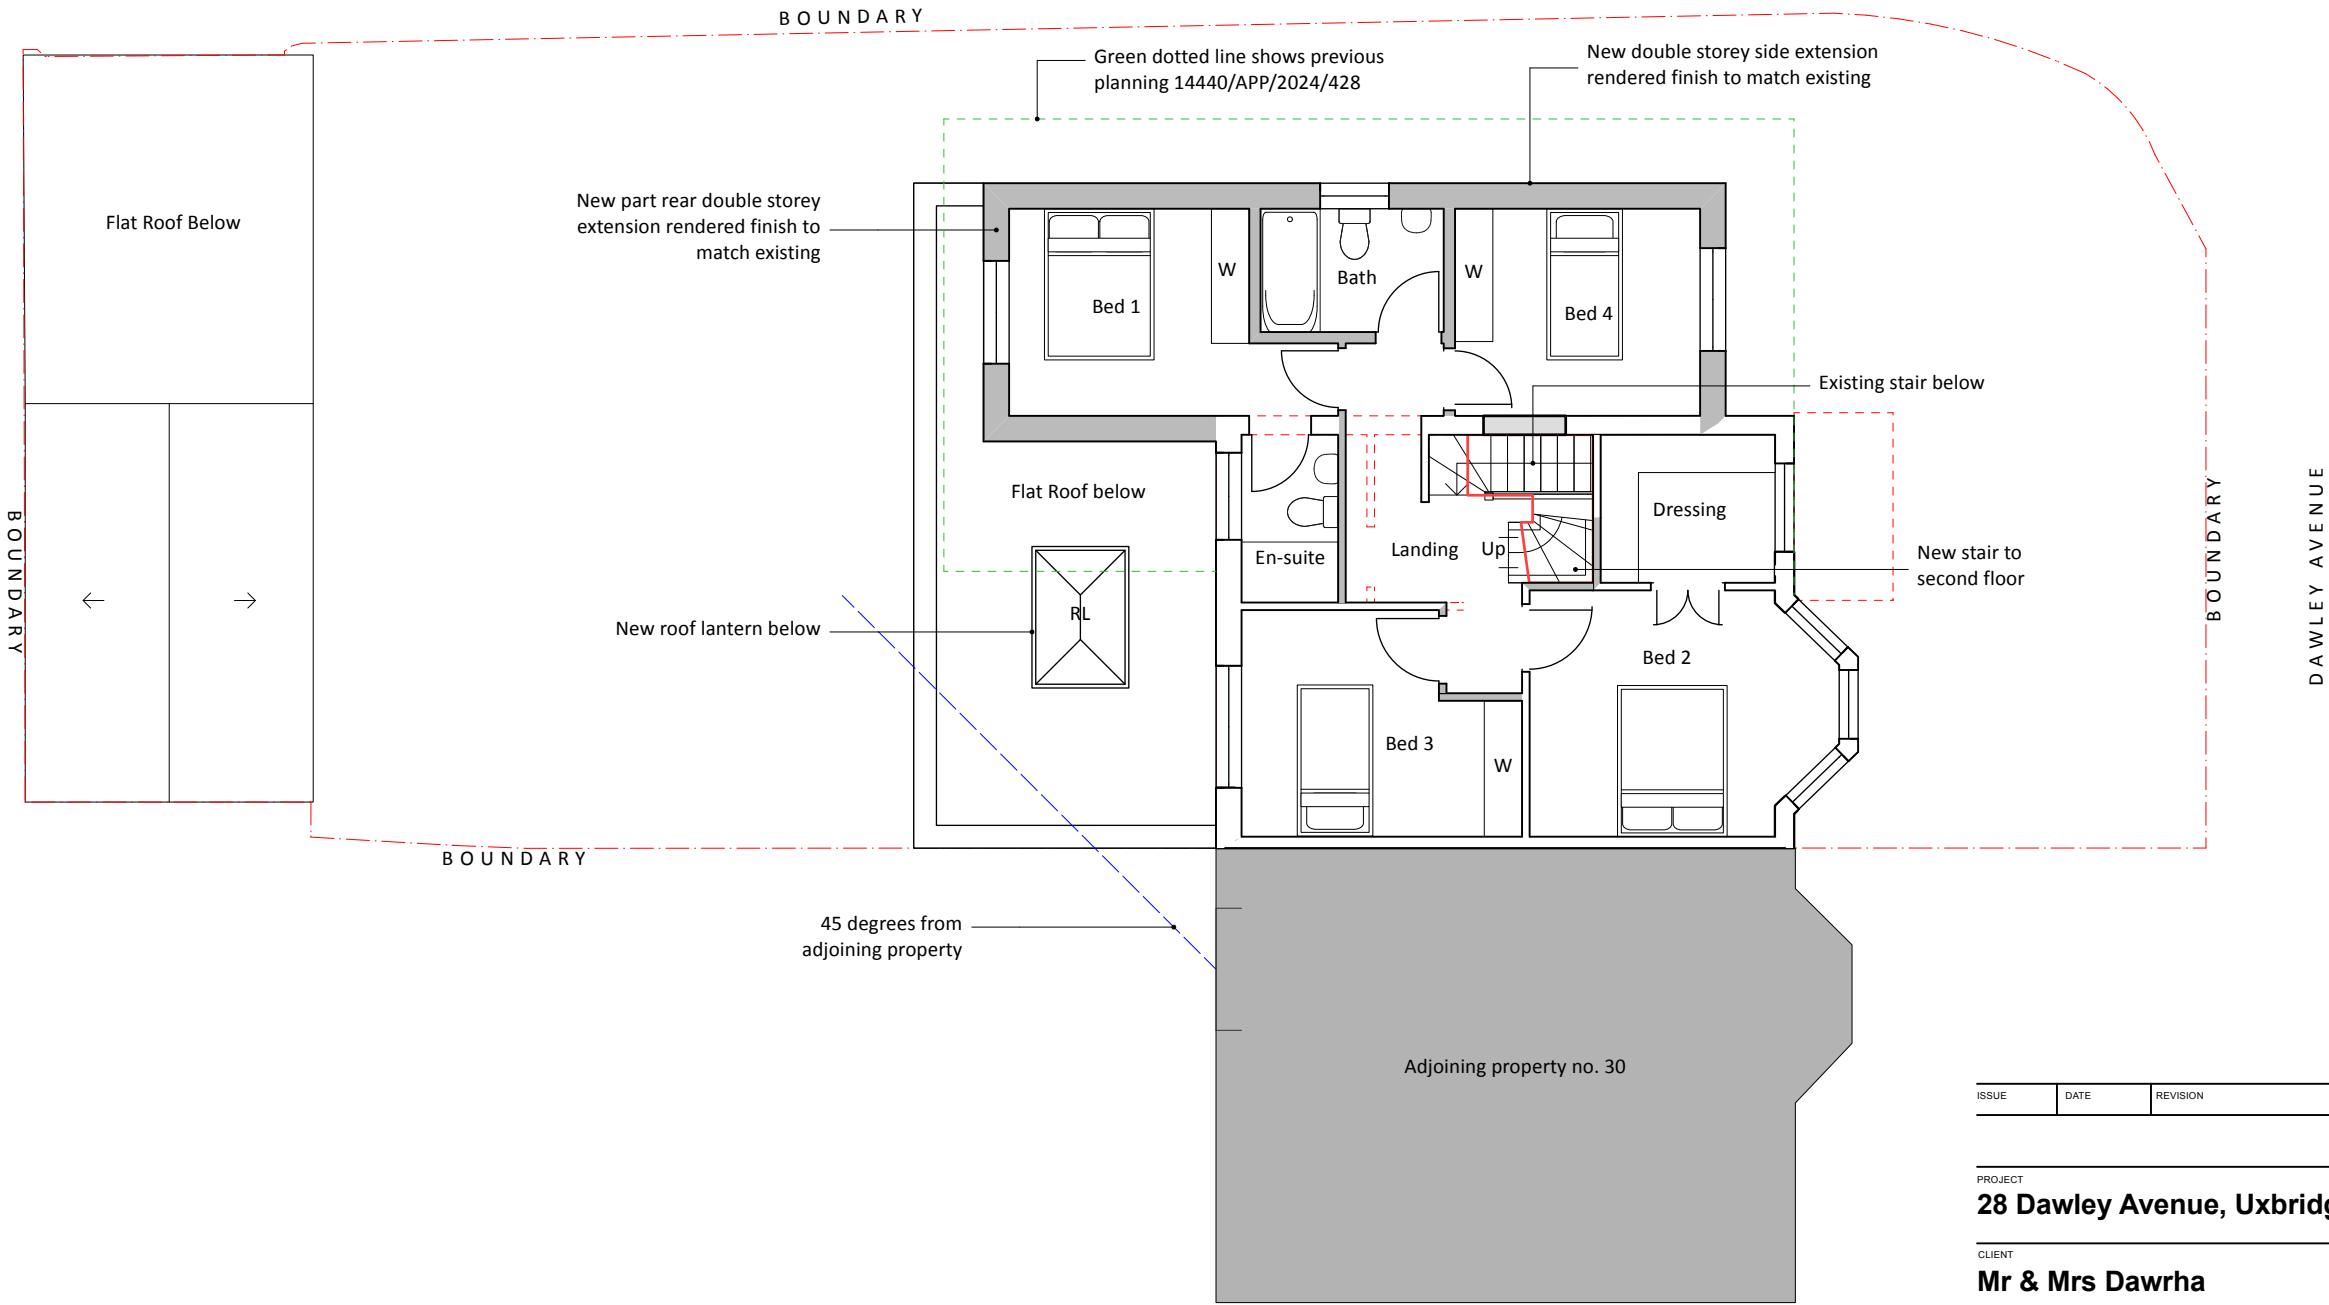

ISSUE	DATE	REVISION

PROJECT
28 Dawley Avenue, Uxbridge UB8 3BU

CLIENT
Mr & Mrs Dawrha

DRAWING
PROPOSED FIRST


STONES

ARCHITECTS

All rights described in chapter IV of the copyright designs & patents act 1988 have been asserted. This drawing must not be scaled; only figured dimensions should be used. Check and verify all dimensions on site prior to commencing any work. Any discrepancies should be reported to the Architects immediately.


PROJECT #	2025.044	DWG #	REV
DATE	10/11/2025		
SCALE	1:100		
DRAWN	CHKD		
PR	JC		

Stones Architects Ltd
50 Coldharbour Lane Hayes Middlesex UB3 3EP
t 020 8969 0000 e mail@stonesarchitects.co.uk w stonesarchitects.co.uk

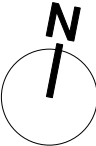


C02

- General Notes
1. New work shown shaded
 2. Demolition shown dotted
 3. W: Wardrobe
Cpbd: Cupboard
RLA: Roof lantern above
RL: Roof light/lantern below
 4. All dimensions are indicative and in mm
 5. If shown levels indicated in red dotted

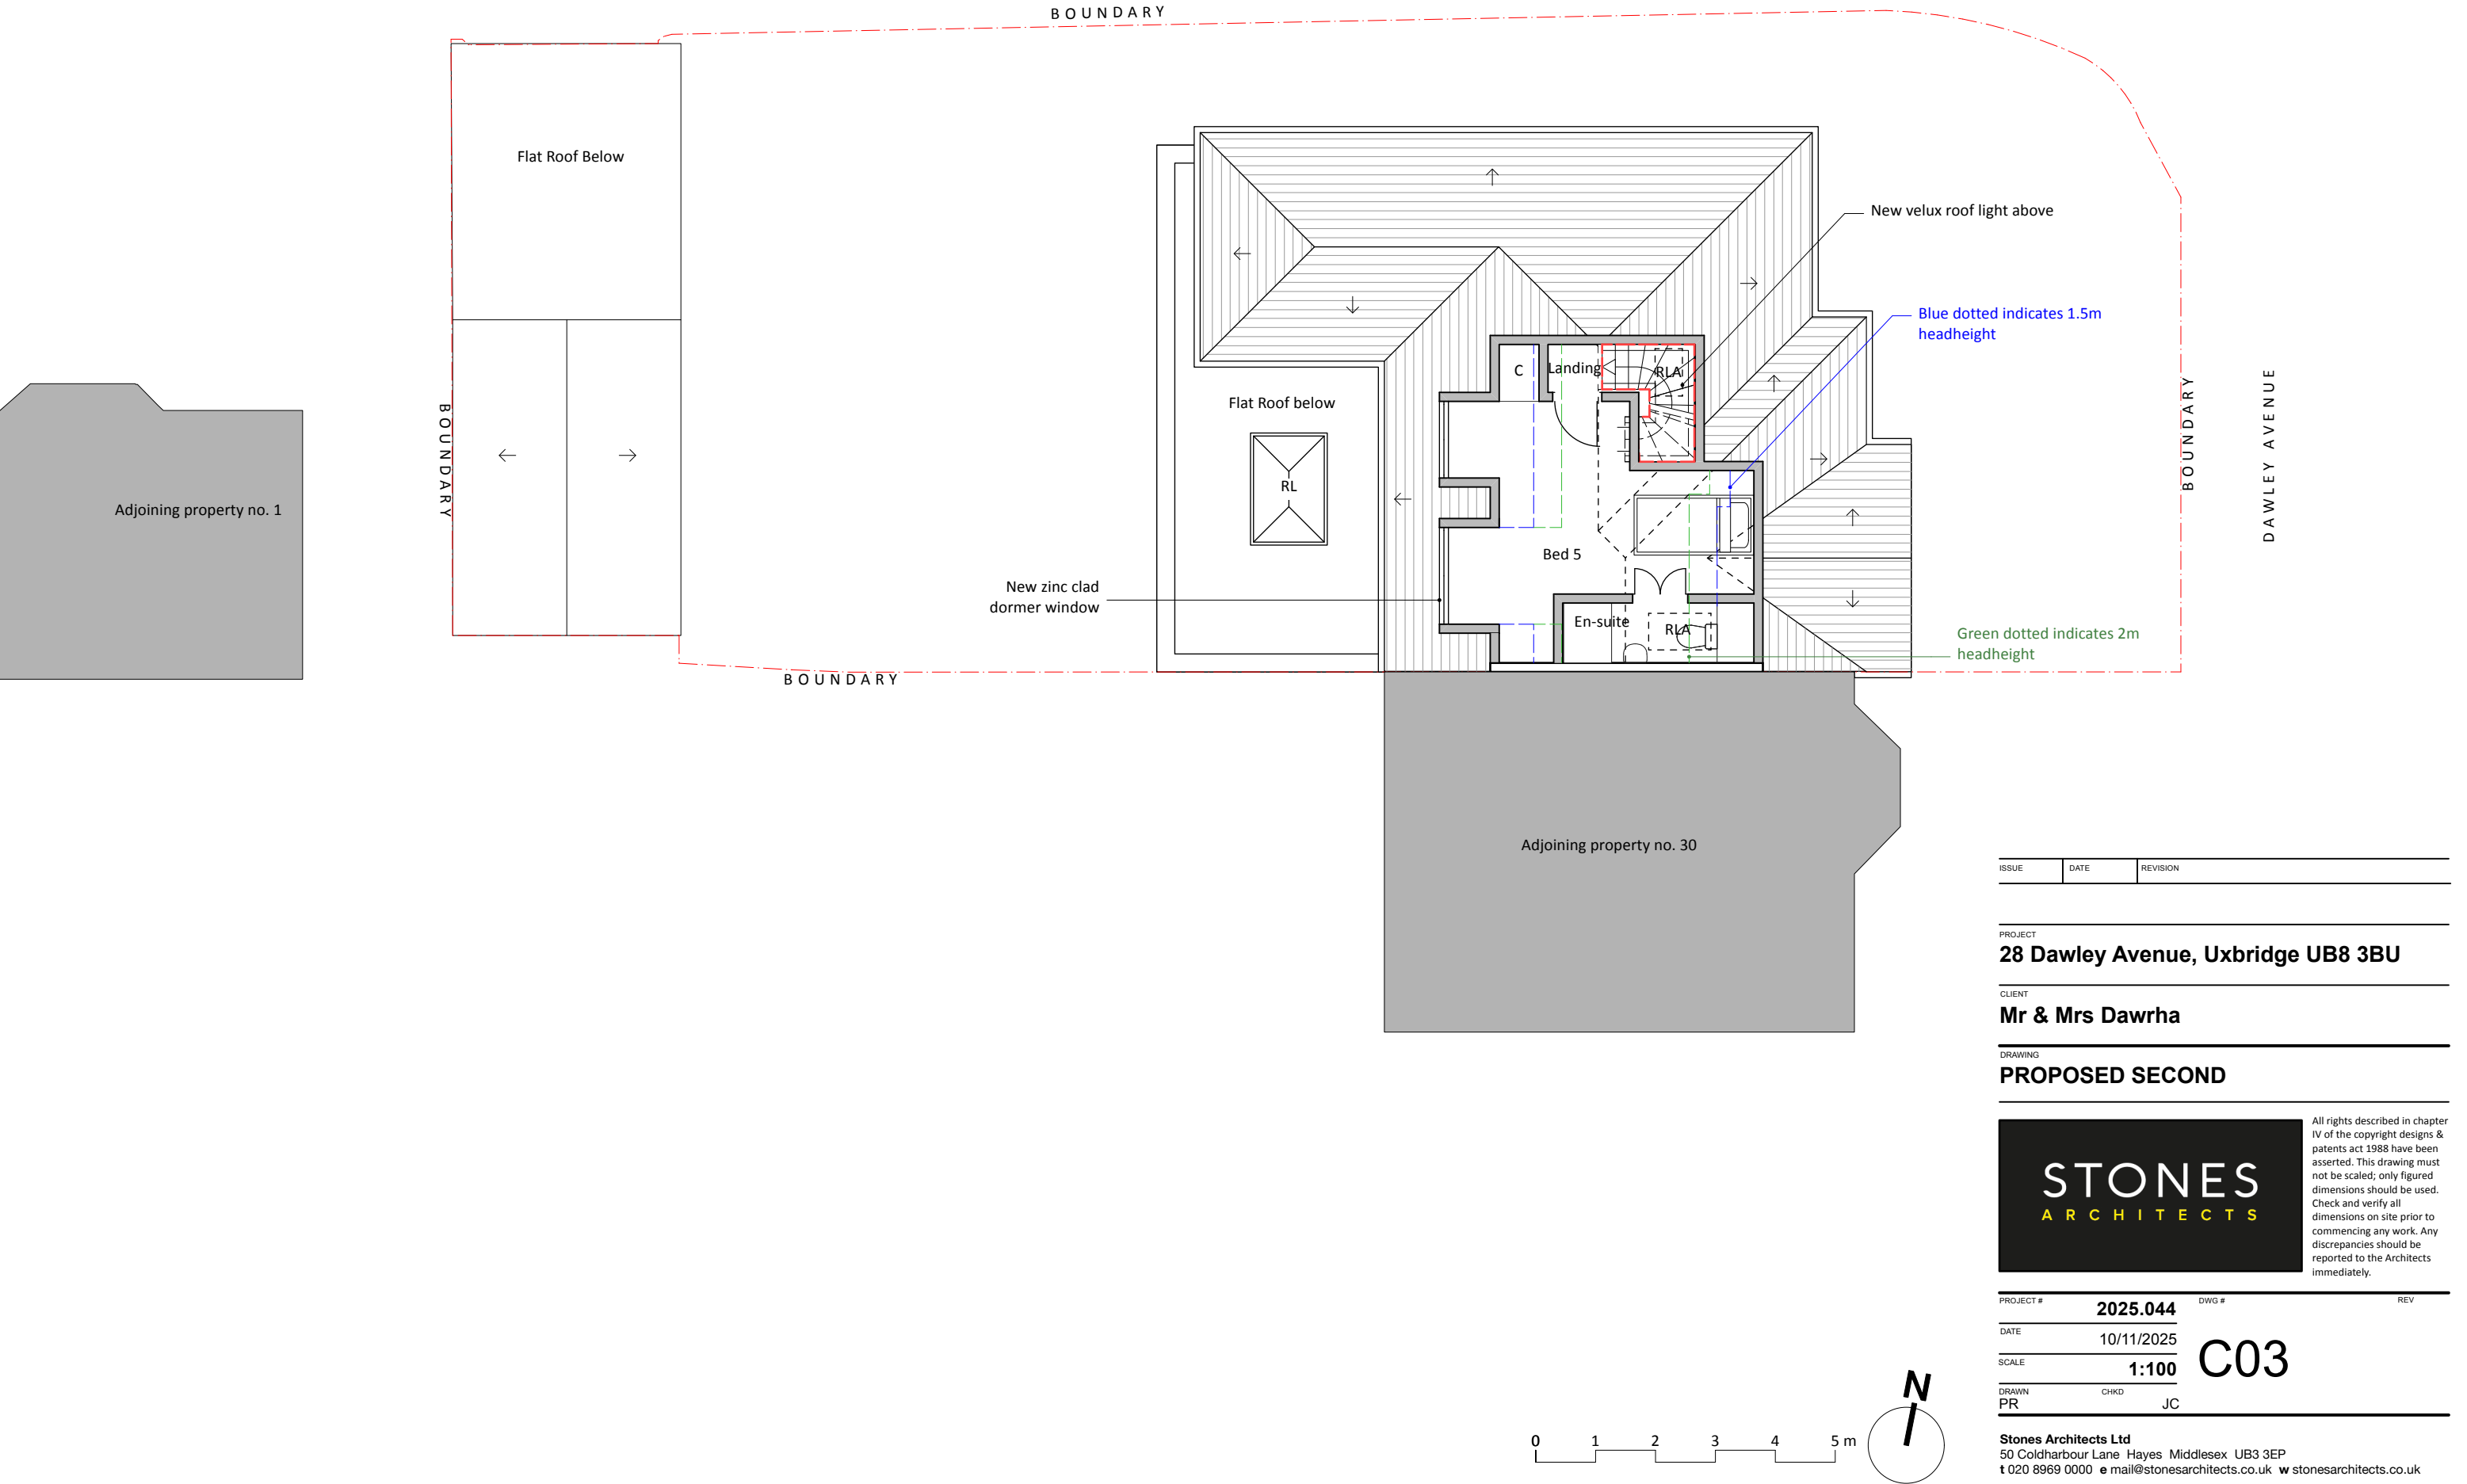

- General Notes
1. New work shown shaded
 2. Demolition shown dotted
 3. W: Wardrobe
Cphd: Cupboard

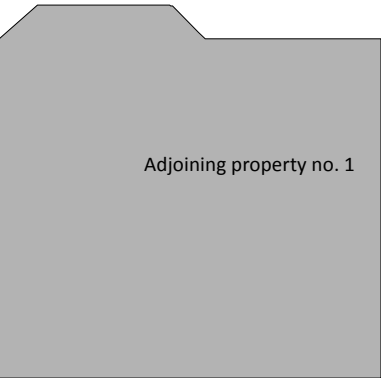

PROJECT
28 Dawley Avenue, Uxbridge UB8 3BU


DRAWING


PROPOSED ROOF




C04

Stones Architects Ltd
50 Coldharbour Lane Hayes Middlesex UB3 3EP
t 020 8969 0000 e mail@stonesarchitects.co.uk w stonesarchitects.co.uk

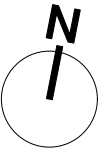


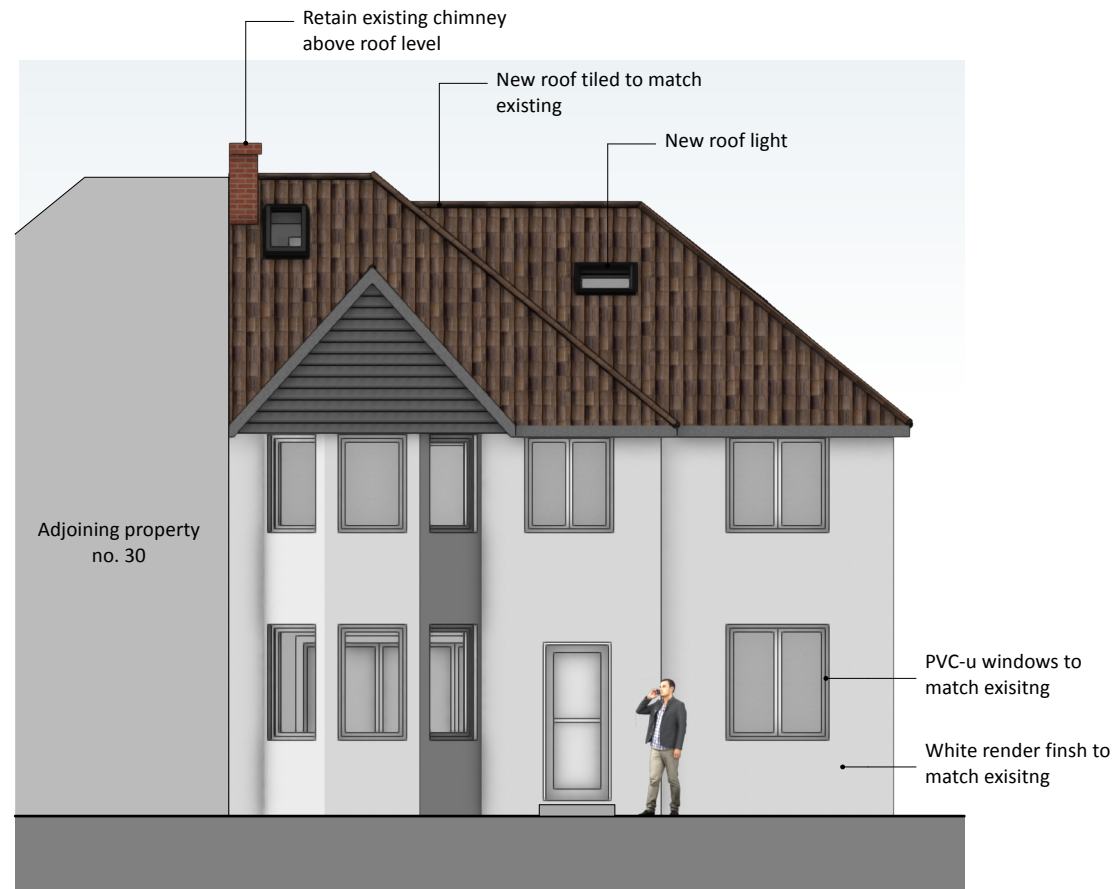


1 NORTH EAST
Scale: 1:100

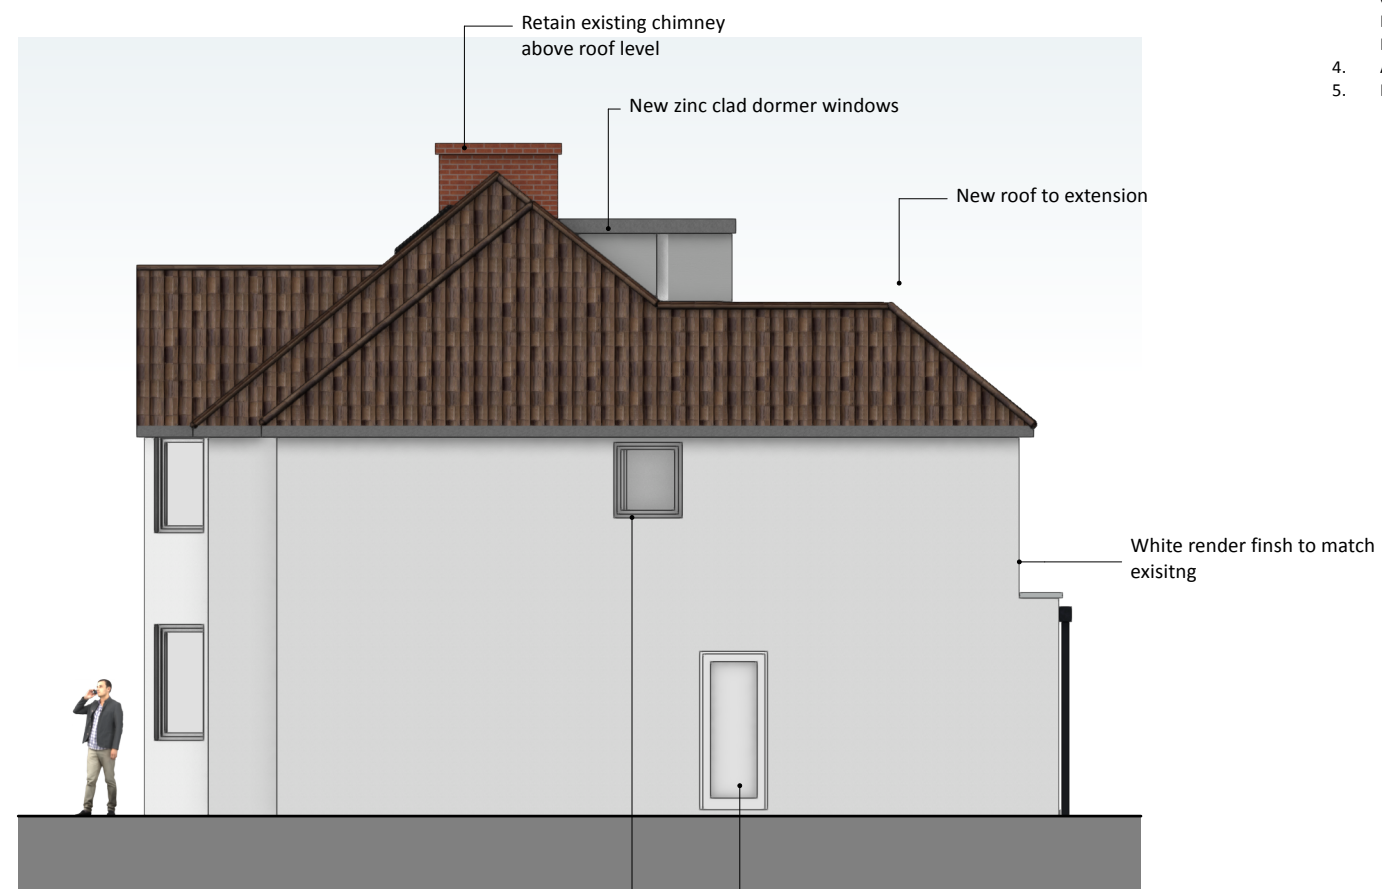

2 NORTH WEST
Scale: 1:100

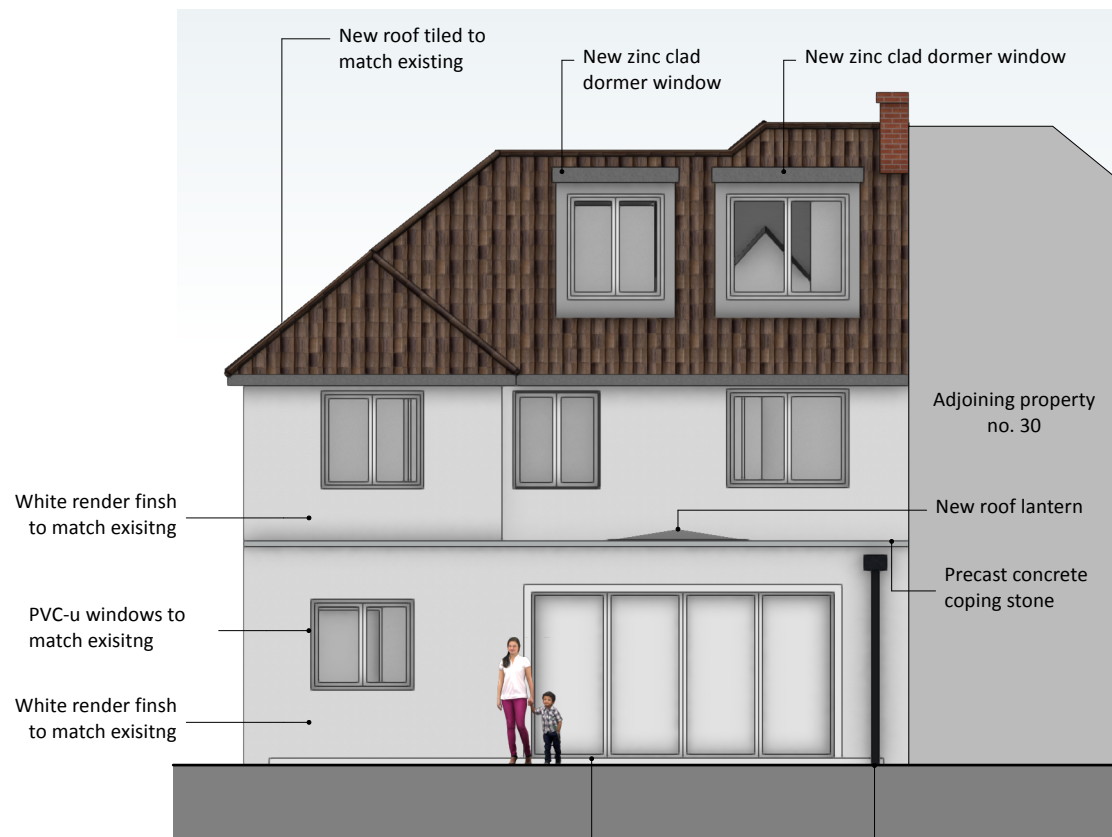

3 SOUTH WEST
Scale: 1:100

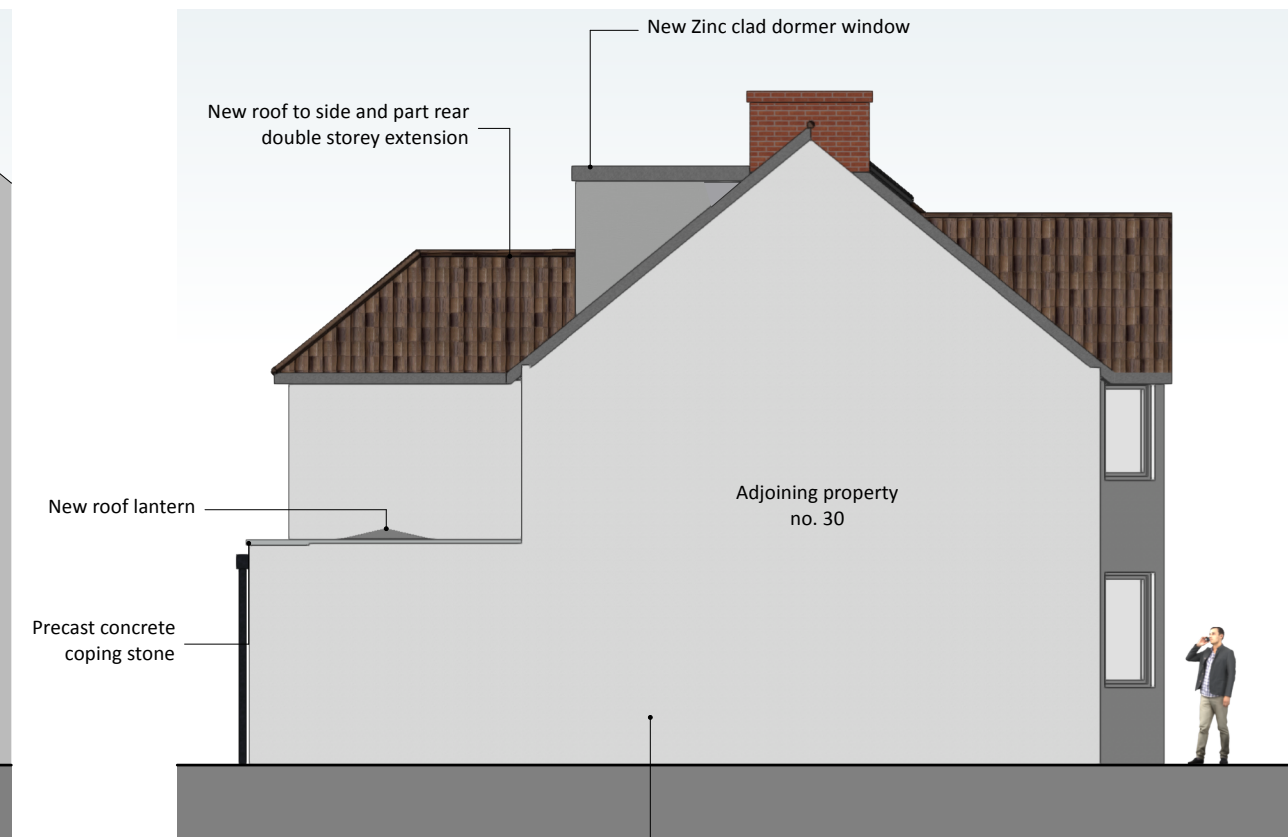

4 SOUTH EAST
Scale: 1:100



- General Notes
1. New work shown shaded
 2. Demolition shown dotted
 3. W: Wardrobe
Cpbd: Cupboard
RLA: Roof lantern above
RL: Roof light/lantern below
 4. All dimensions are indicative and in mm
 5. If shown levels indicated in red dotted

ISSUE	DATE	REVISION
-------	------	----------

PROJECT
28 Dawley Avenue, Uxbridge UB8 3BU

CLIENT
Mr & Mrs Dawrha

DRAWING
PROPOSED ELEVATIONS




PROJECT #	2025.044	DWG #	REV
DATE	10/11/2025		
SCALE	1:100		
DRAWN	PR	CHKD	JC

Stones Architects Ltd
50 Coldharbour Lane Hayes Middlesex UB3 3EP
t 020 8969 0000 e mail@stonesarchitects.co.uk w stonesarchitects.co.uk



- General Notes
1. New work shown shaded
 2. Demolition shown dotted
 3. W: Wardrobe
Cpbd: Cupboard
RLA: Roof lantern above
RL: Roof light/lantern below
 4. All dimensions are indicative and in mm
 5. If shown levels indicated in red dotted

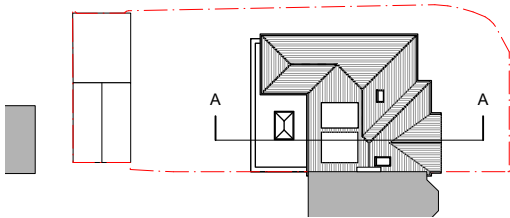

1 SECTION KEY
Scale: 1:500

ISSUE	DATE	REVISION

PROJECT
28 Dawley Avenue, Uxbridge UB8 3BU

CLIENT
Mr & Mrs Dawrha

DRAWING
PROPOSED SECTION A-A

STONES

ARCHITECTS

All rights described in chapter IV of the copyright designs & patents act 1988 have been asserted. This drawing must not be scaled; only figured dimensions should be used. Check and verify all dimensions on site prior to commencing any work. Any discrepancies should be reported to the Architects immediately.

PROJECT #	2025.044	DWG #	REV
DATE	10/11/2025		
SCALE	1:50		
DRAWN	CHKD		
PR	JC		

Stones Architects Ltd
50 Coldharbour Lane Hayes Middlesex UB3 3EP
t 020 8969 0000 e mail@stonesarchitects.co.uk w stonesarchitects.co.uk