

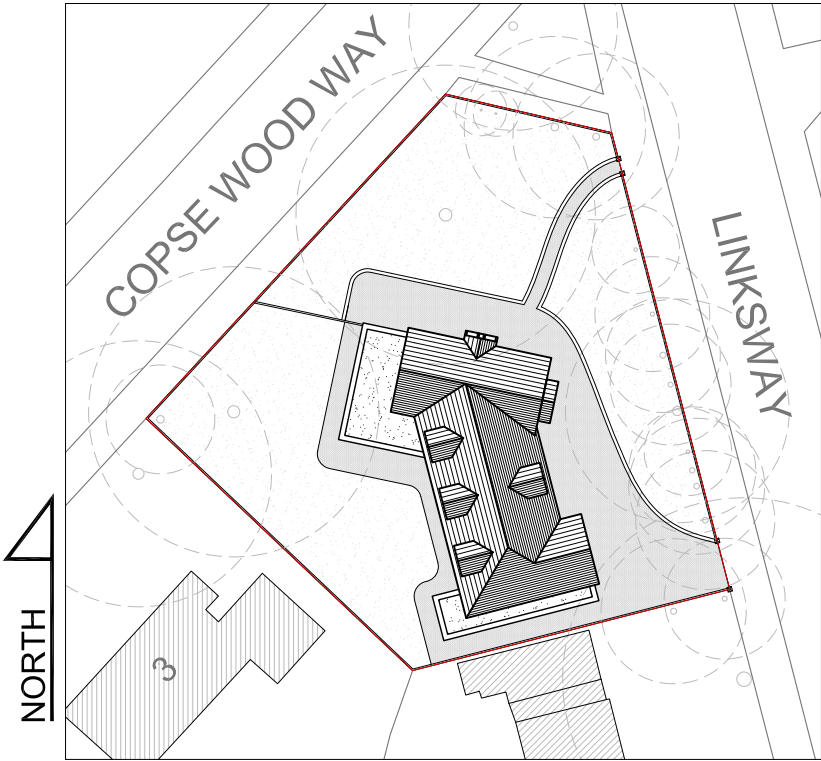


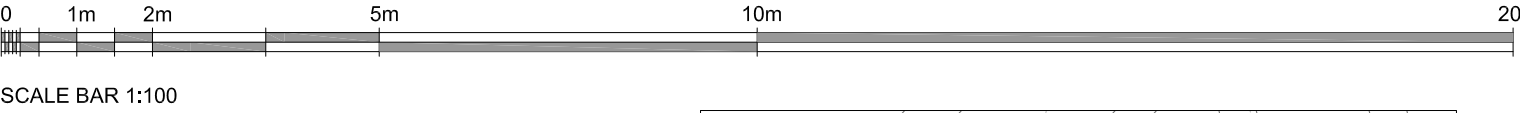

AS-BUILT BLOCK PLAN  
SCALE 1:500

PLEASE DO NOT SCALE FROM THIS  
DRAWING ON CAD OR BY ANY OTHER  
METHOD. ALL DIMENSIONS INDICATED  
ARE AS MEASURED ON SITE ON 06.02.17.

- ① FACING BRICKWORK TO MATCH EXISTING
- ② DOUBLE GLAZED WINDOW WITH SOLDIER COURSE HEAD DETAIL TO MATCH EXISTING
- ③ PLAN ROOFING TILES TO MATCH EXISTING
- ④ HIPPED ROOF DORMER WITH MATCHING ROOF TILES AND WINDOWS
- ⑤ SELF COLOURED RENDER TO NEW EXTENSION
- ⑥ BRICK ON EDGE DETAILING TO ALL ELEVATIONS
- ⑦ HIPPED ROOF PORCH WITH TIMBER POSTS
- ⑧ FLAT ROOF WITH PARAPET AND CONCEALED BOX GUTTER
- ⑨ VERTICAL TILING TO DORMER WINDOW IN MATCHING ROOF TILES TO MAIN ROOF
- ⑩ DOUBLE GLAZED SLIDING FOLDING DOORS IN MATCHING STYLE TO MAIN WINDOWS

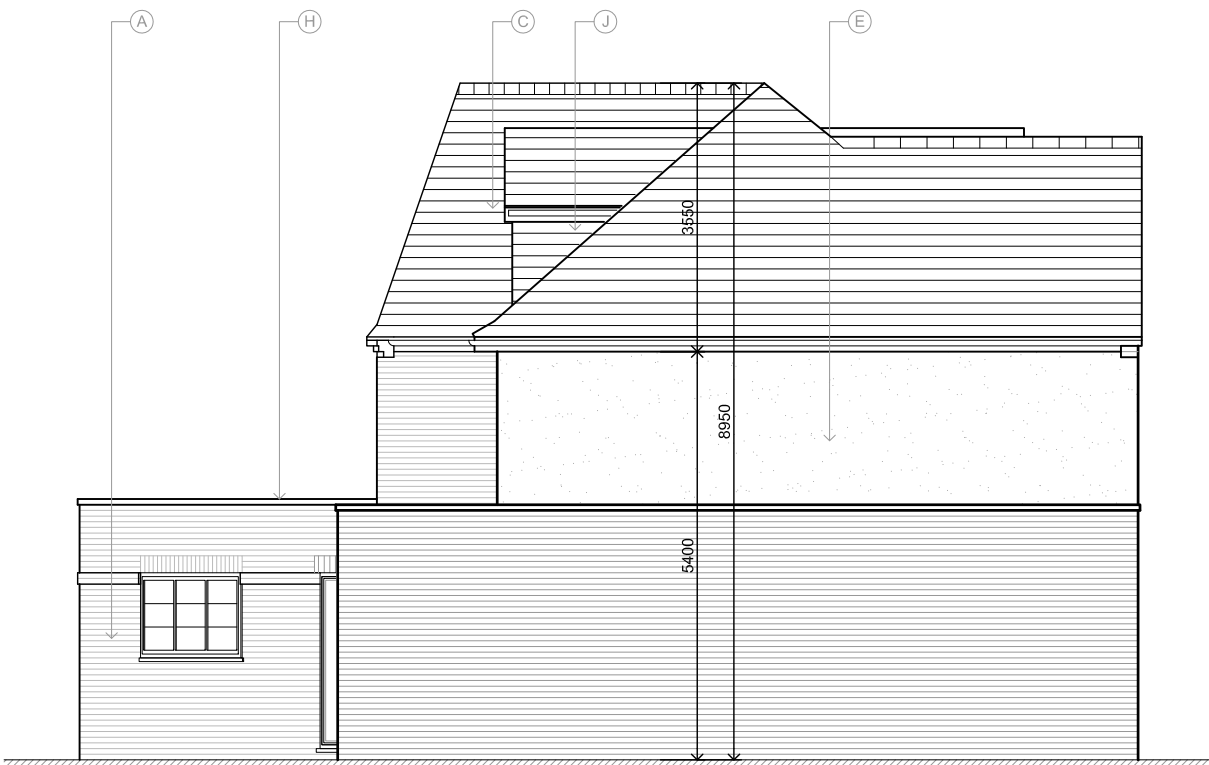

AS BUILT SIDE ELEVATION (E)

| Rev | Date     | Description                            | RP |
|-----|----------|----------------------------------------|----|
| E   | 24.03.17 | OUTLINE OF PREVIOUS APPROVALS ADDED    | BR |
| D   | 16.02.17 | RIDGE HEIGHT TO SUIT PLANNING COMMENTS | RP |
| C   | 13.02.17 | OBSOURED GLAZING AND DIMENSIONS        | RP |
| B   | 21.12.16 | GLAZING TO DORMERS OBSOURED            | RP |
| A   | 05.12.16 | AS BUILT ROOF HEIGHTS CORRECTED        | RP |

Client

MR. K. VHORA

Project Title  
PROPOSED EXTENSION TO PROPERTY

2 LINKSWAY, NORTHWOOD, HA6 2XB

Drawing Title

AS BUILT PLANS & ELEVATIONS


| Cad File    | Sheet Size   | Scale       |
|-------------|--------------|-------------|
| A001        | A1           | 1:100       |
| Drawn by    | Drawing Date | Approved by |
| RP          | FEB 2017     | NJ          |
| Project No. | Drawing No.  | Revision    |
| 1440        | A203         | E           |



Argyle House, Joel Street,  
Northwood Hills, Middlesex, HA6 1NW  
t 01923 840077 f 01923 840078  
info@jutla-architects.com  
jutla-architects.com

This drawing is property of Jutla Architects Ltd © and must not be  
copied or otherwise reproduced. All dimensions must be checked on  
site before commencing work. No dimensions to be scaled from this  
drawing. This drawing was produced using AutoCad 2016.

AS BUILT ISSUE

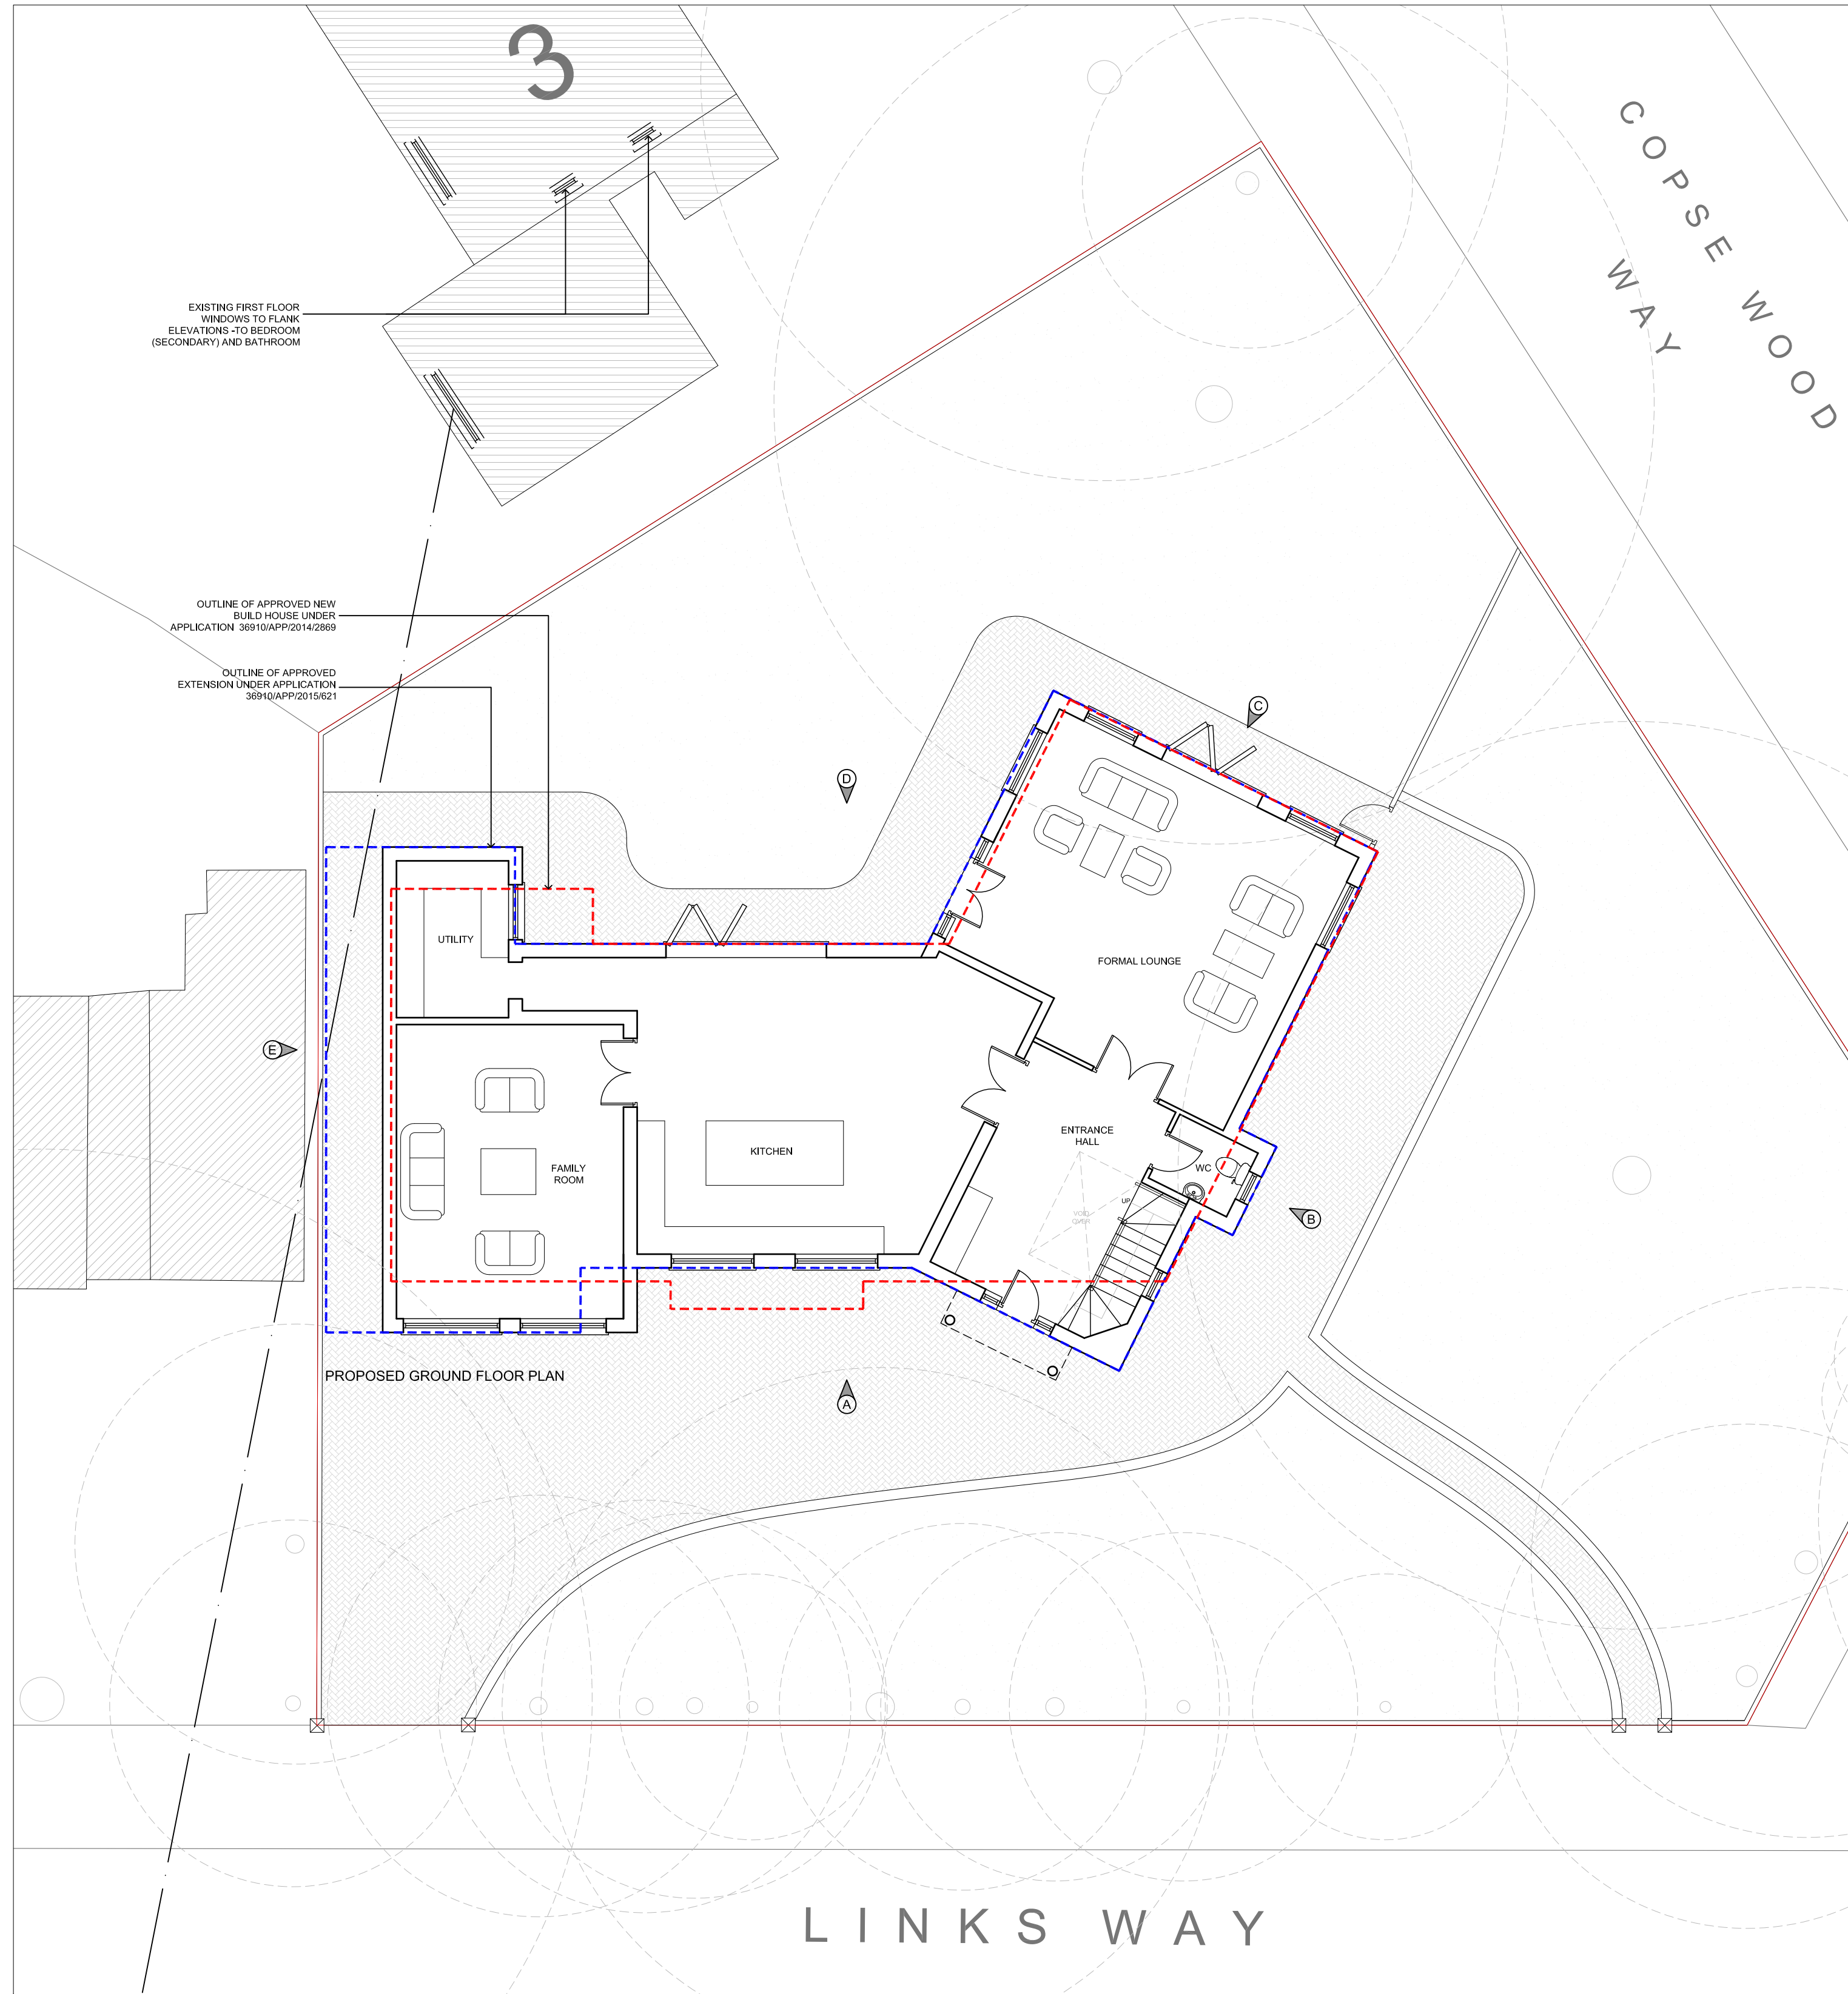


AS BUILT BLOCK PLAN




AS BUILT FRONT ELEVATION (B)




AS BUILT SIDE ELEVATION (C)

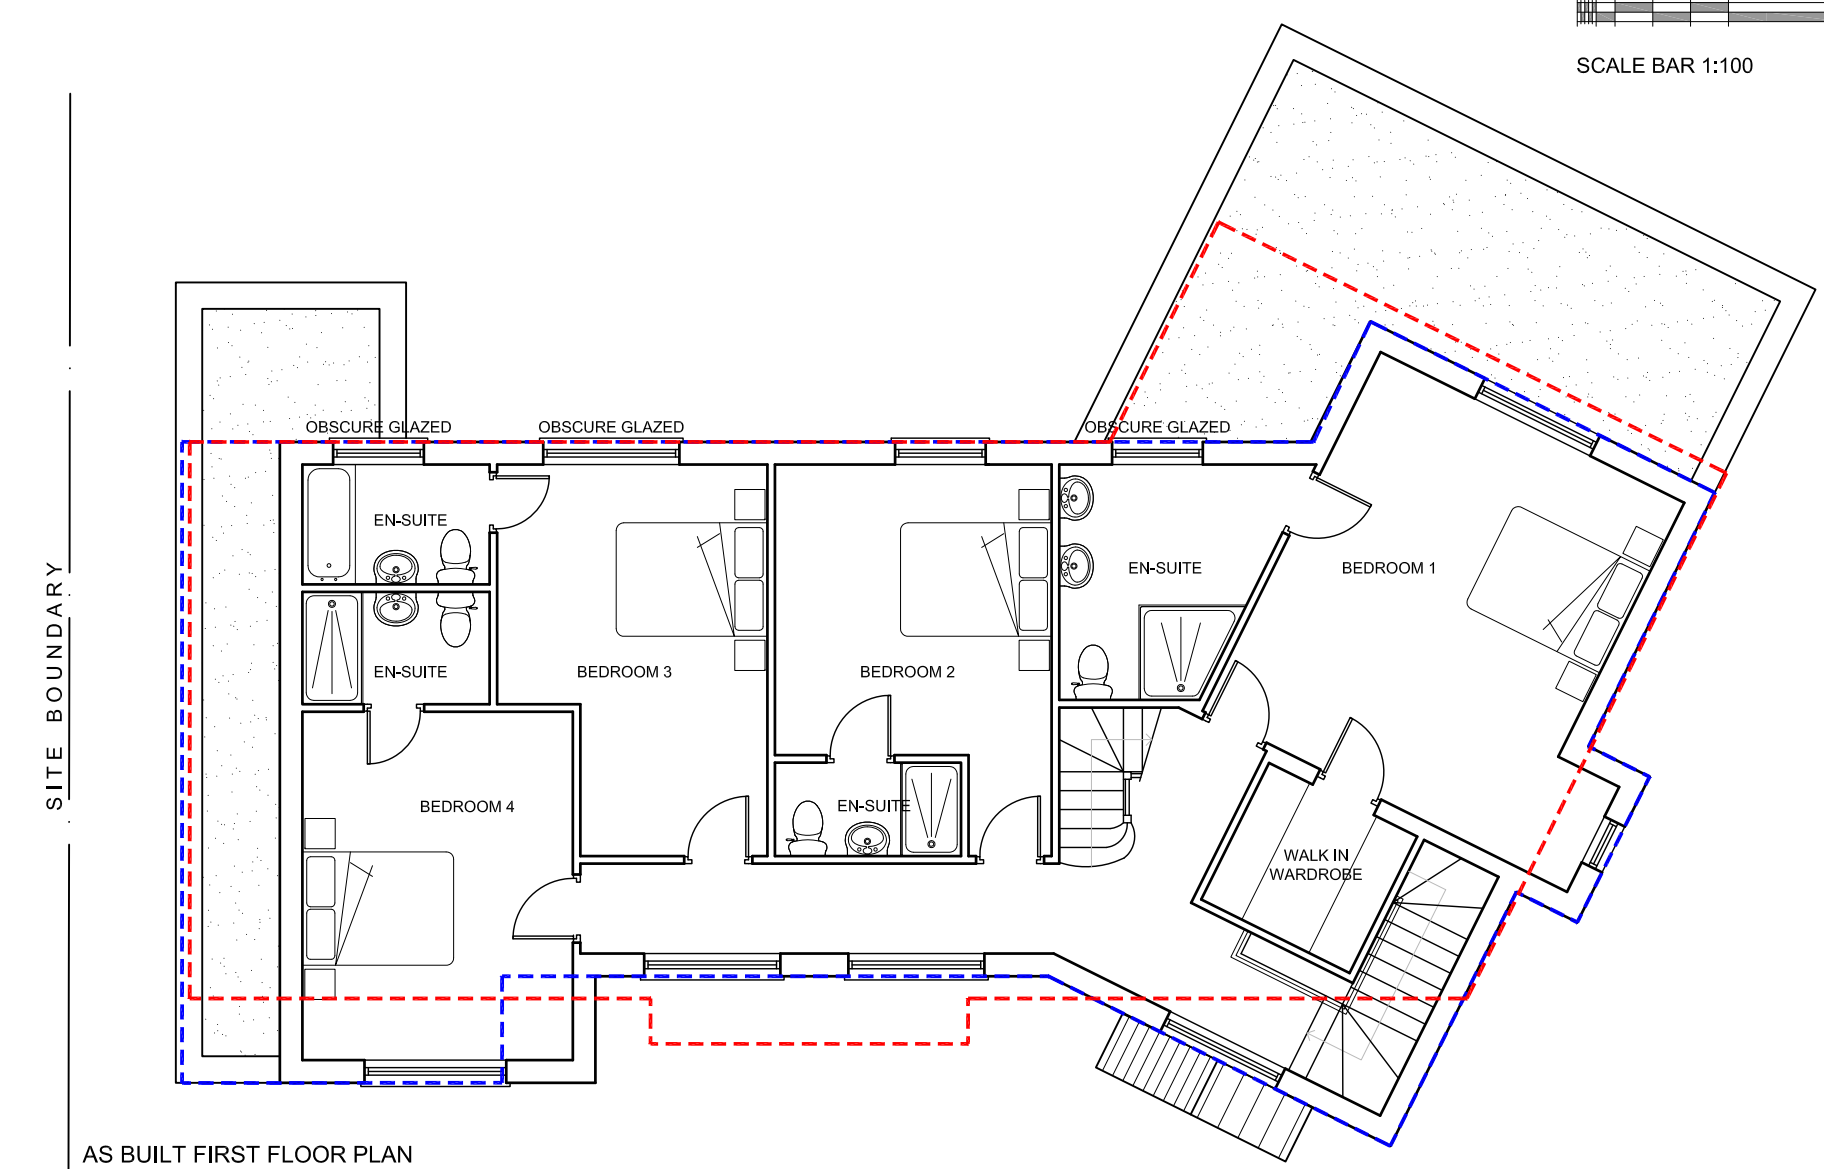


AS BUILT FIRST FLOOR PLAN

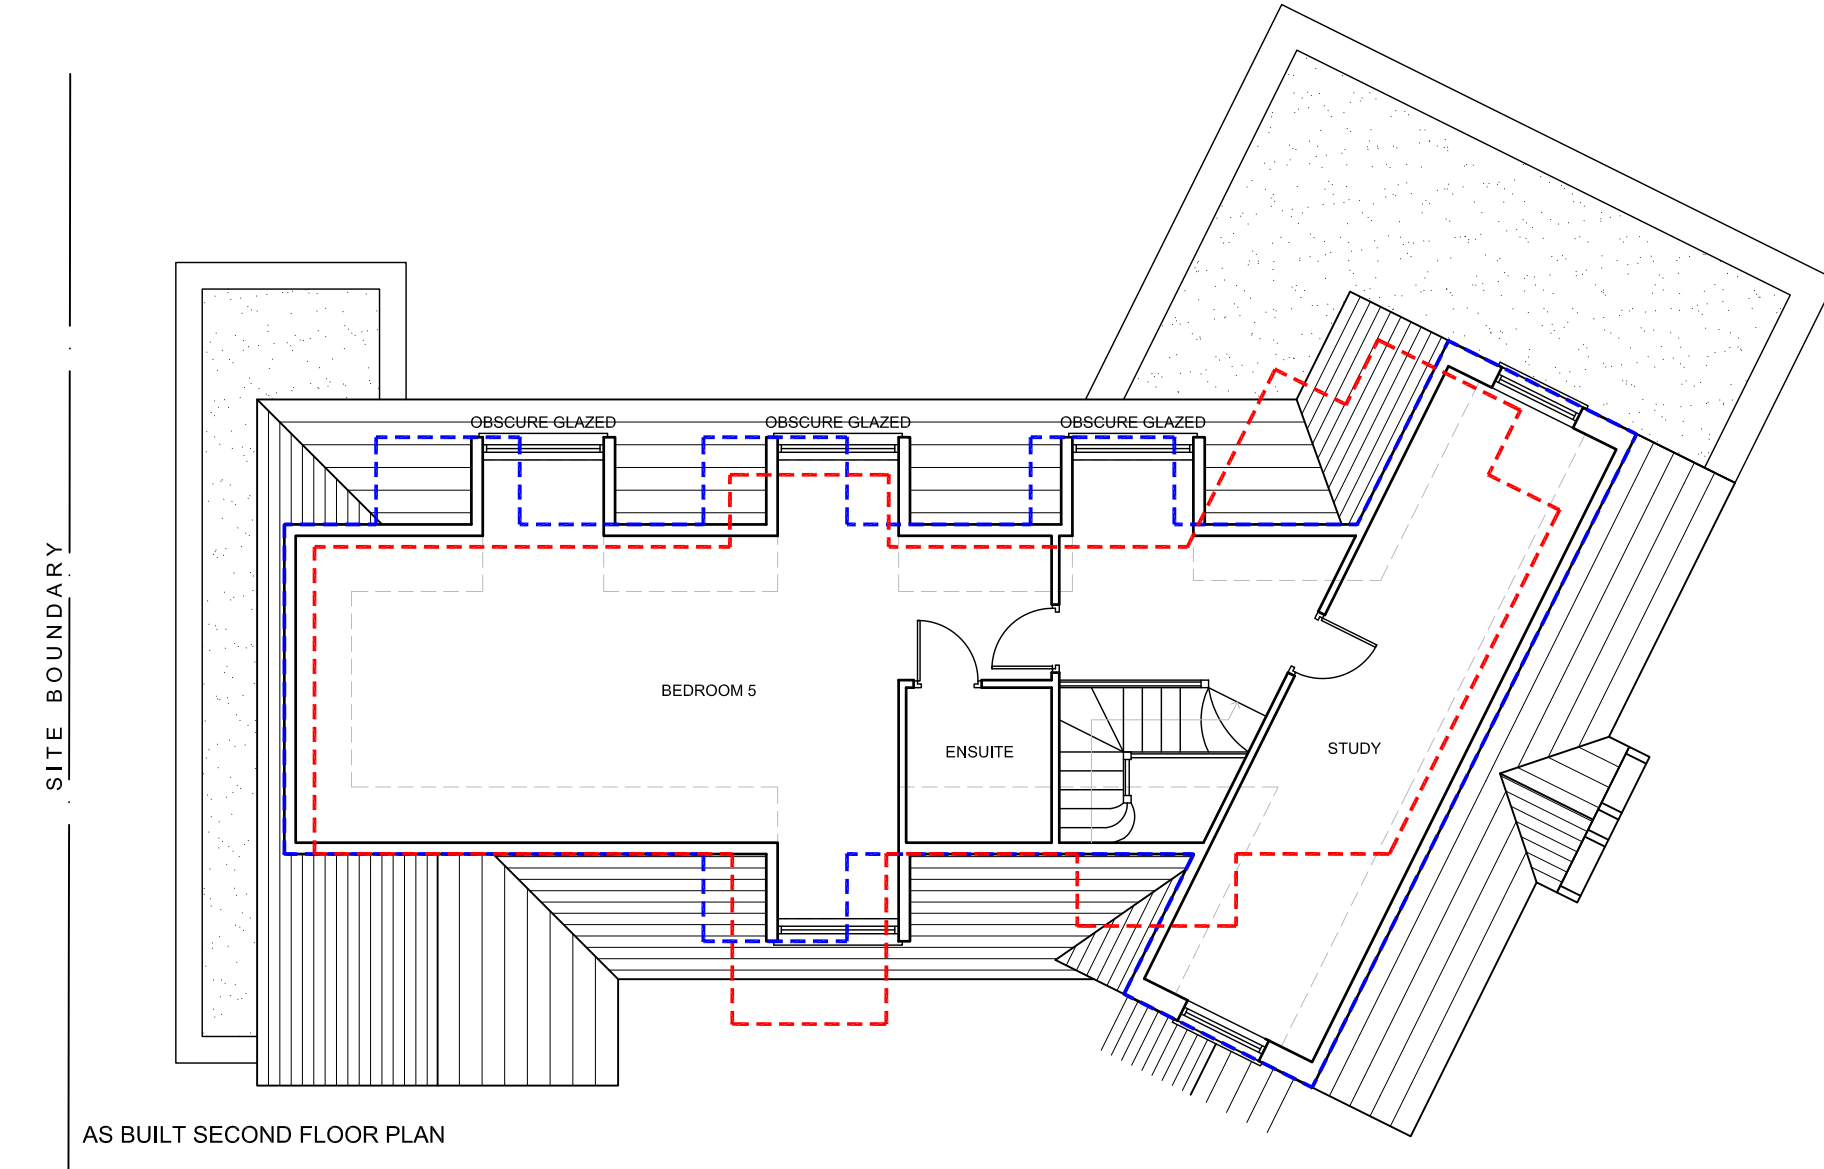

AS BUILT SECOND FLOOR PLAN

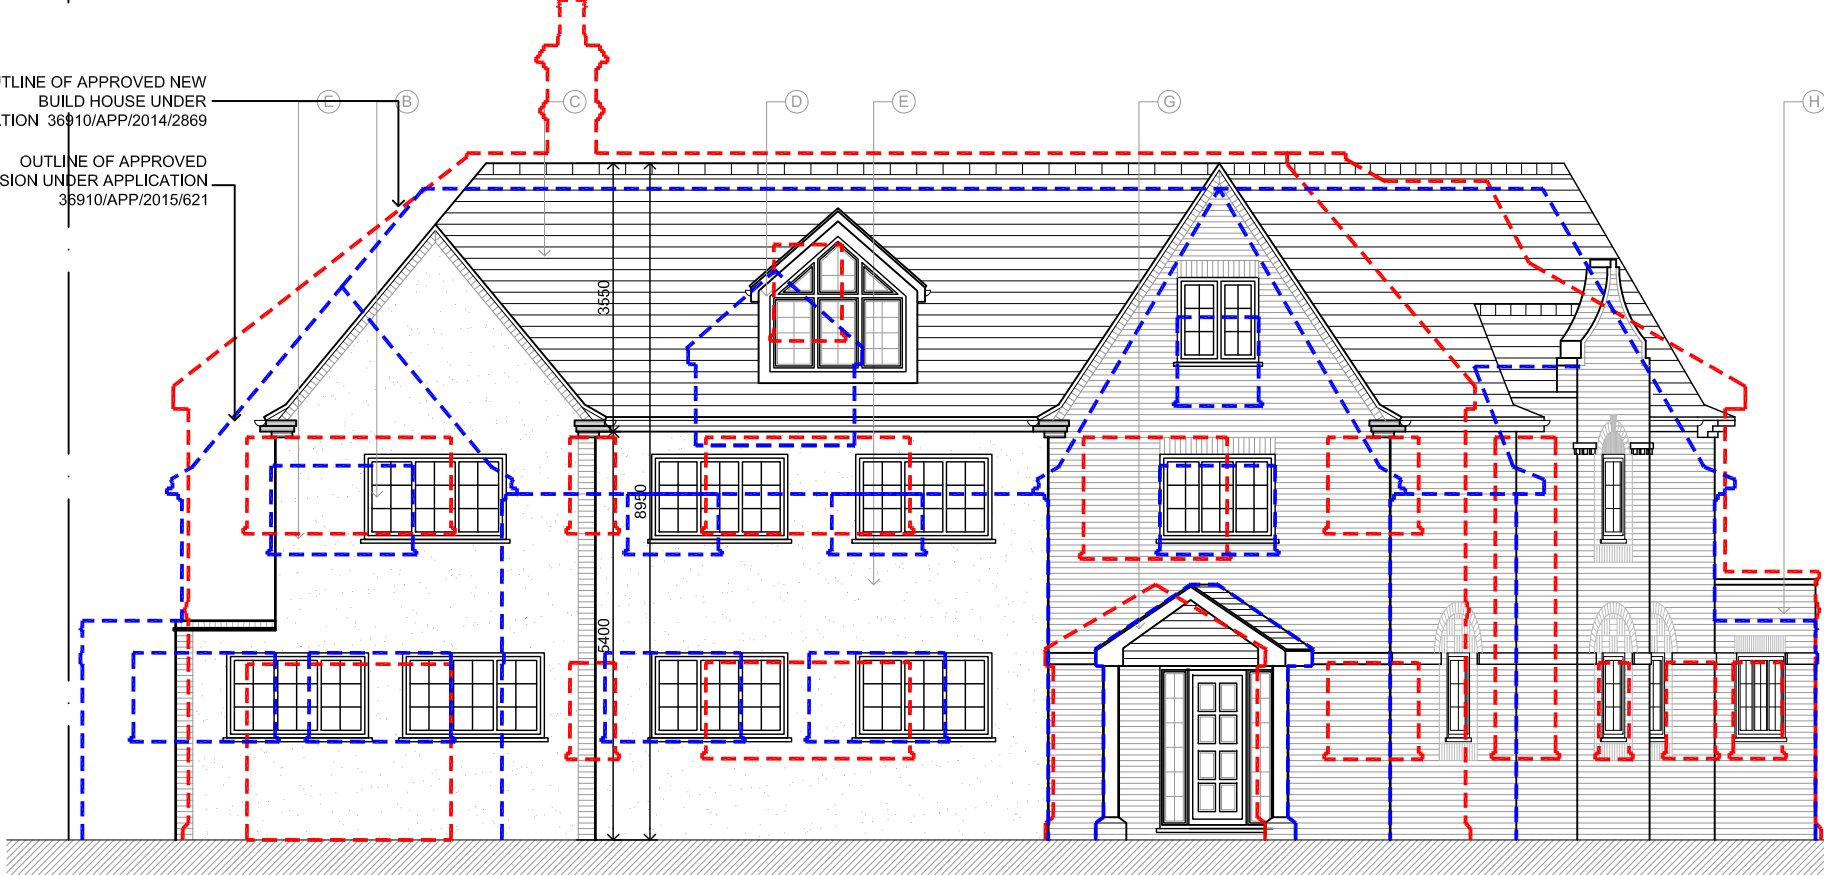

AS BUILT FRONT ELEVATION (A)

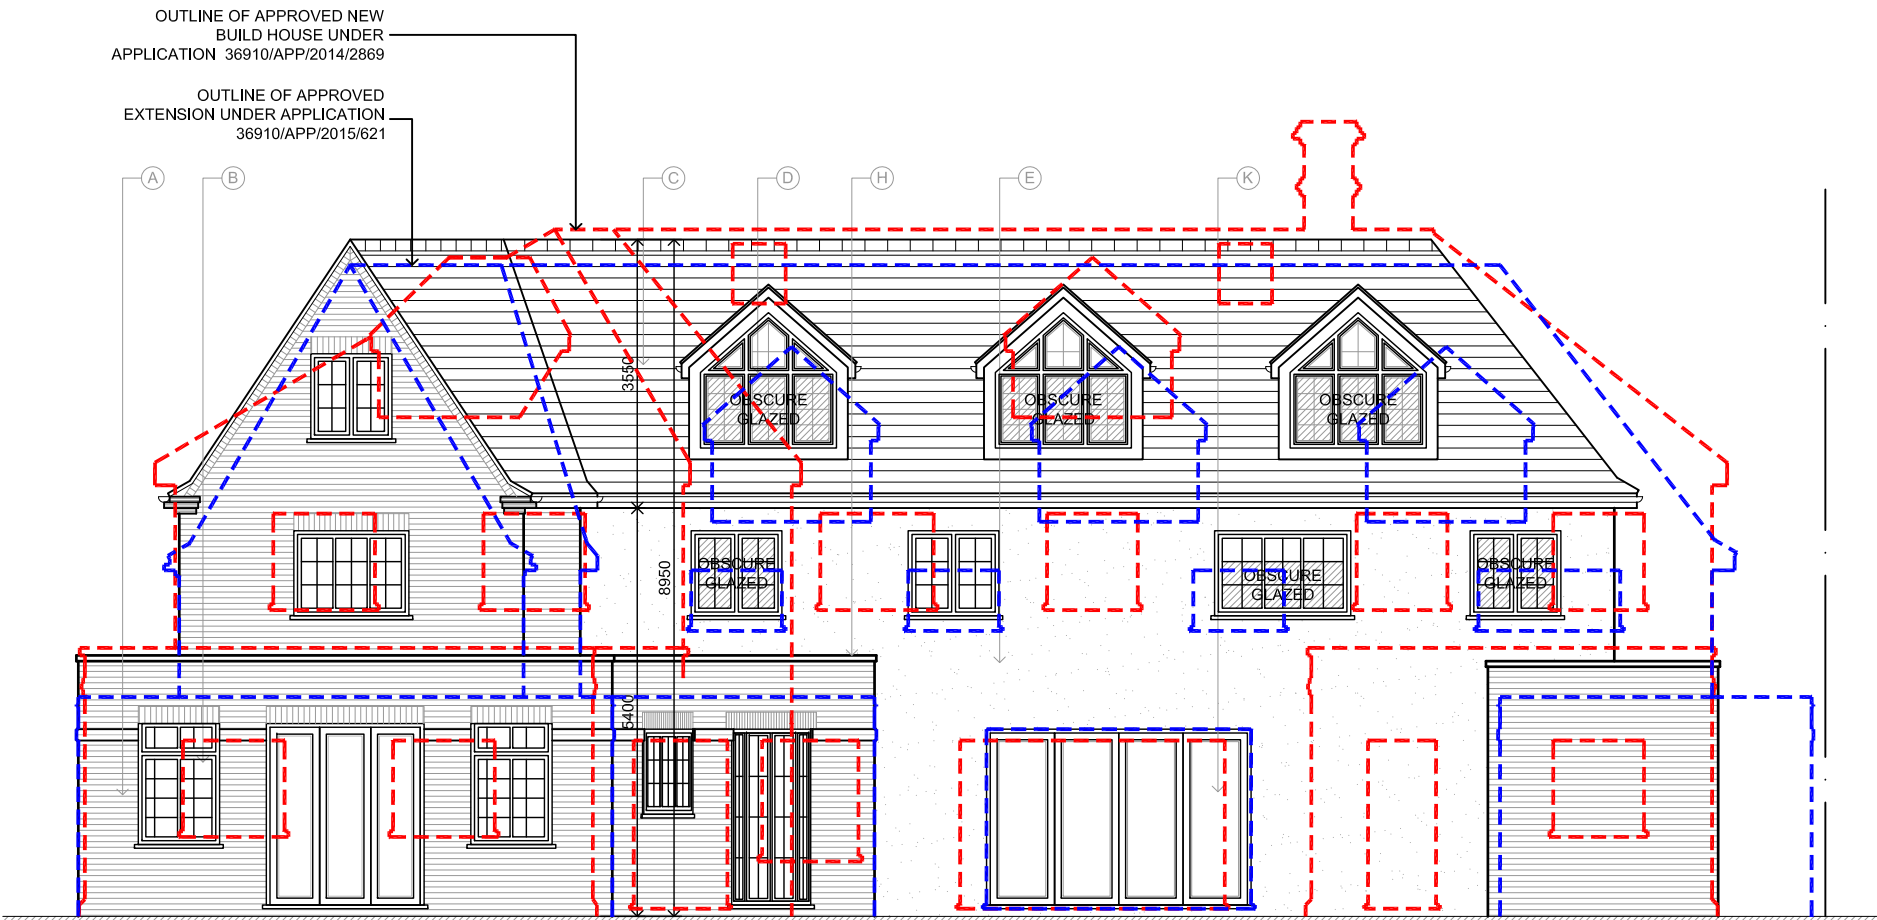

AS BUILT REAR ELEVATION (D)