



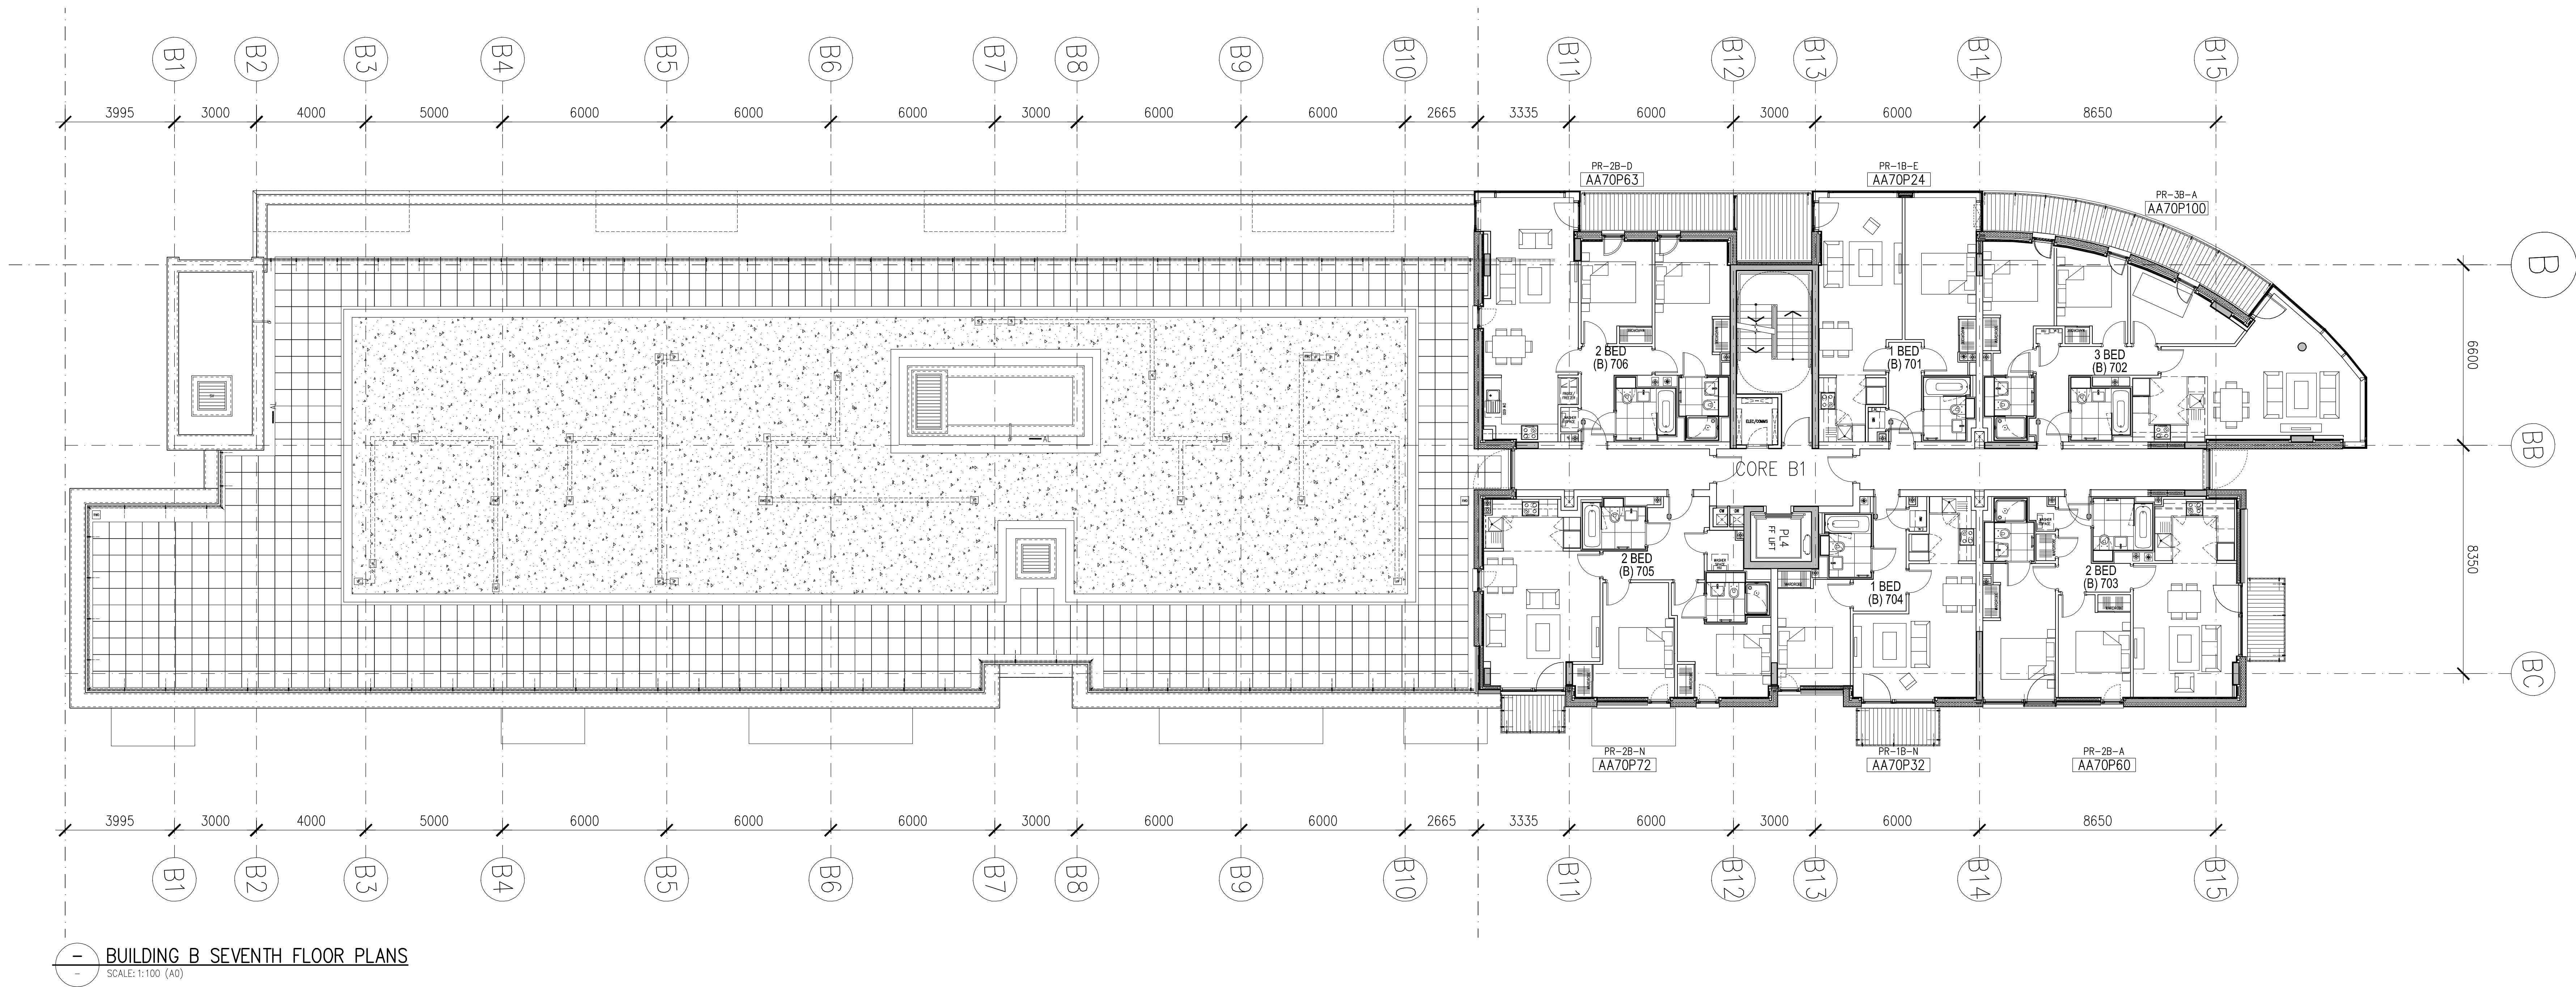

- NOTES
- 1 The Contractor must check and confirm dimensions
 - 2 All discrepancies must be reported and resolved by the Architect before works commence
 - 3 This drawing is not to be scaled
 - 4 All work and materials to be in accordance with current applicable Statutory Legislation and to comply with all relevant Codes of Practice and British Standards
 - 5 Level datum is 100m above reference datum to avoid confusion with previous survey

■	#100 VP
■	#100 RMP
■	#100 SVP
■	#100 SS
■	#200 MV

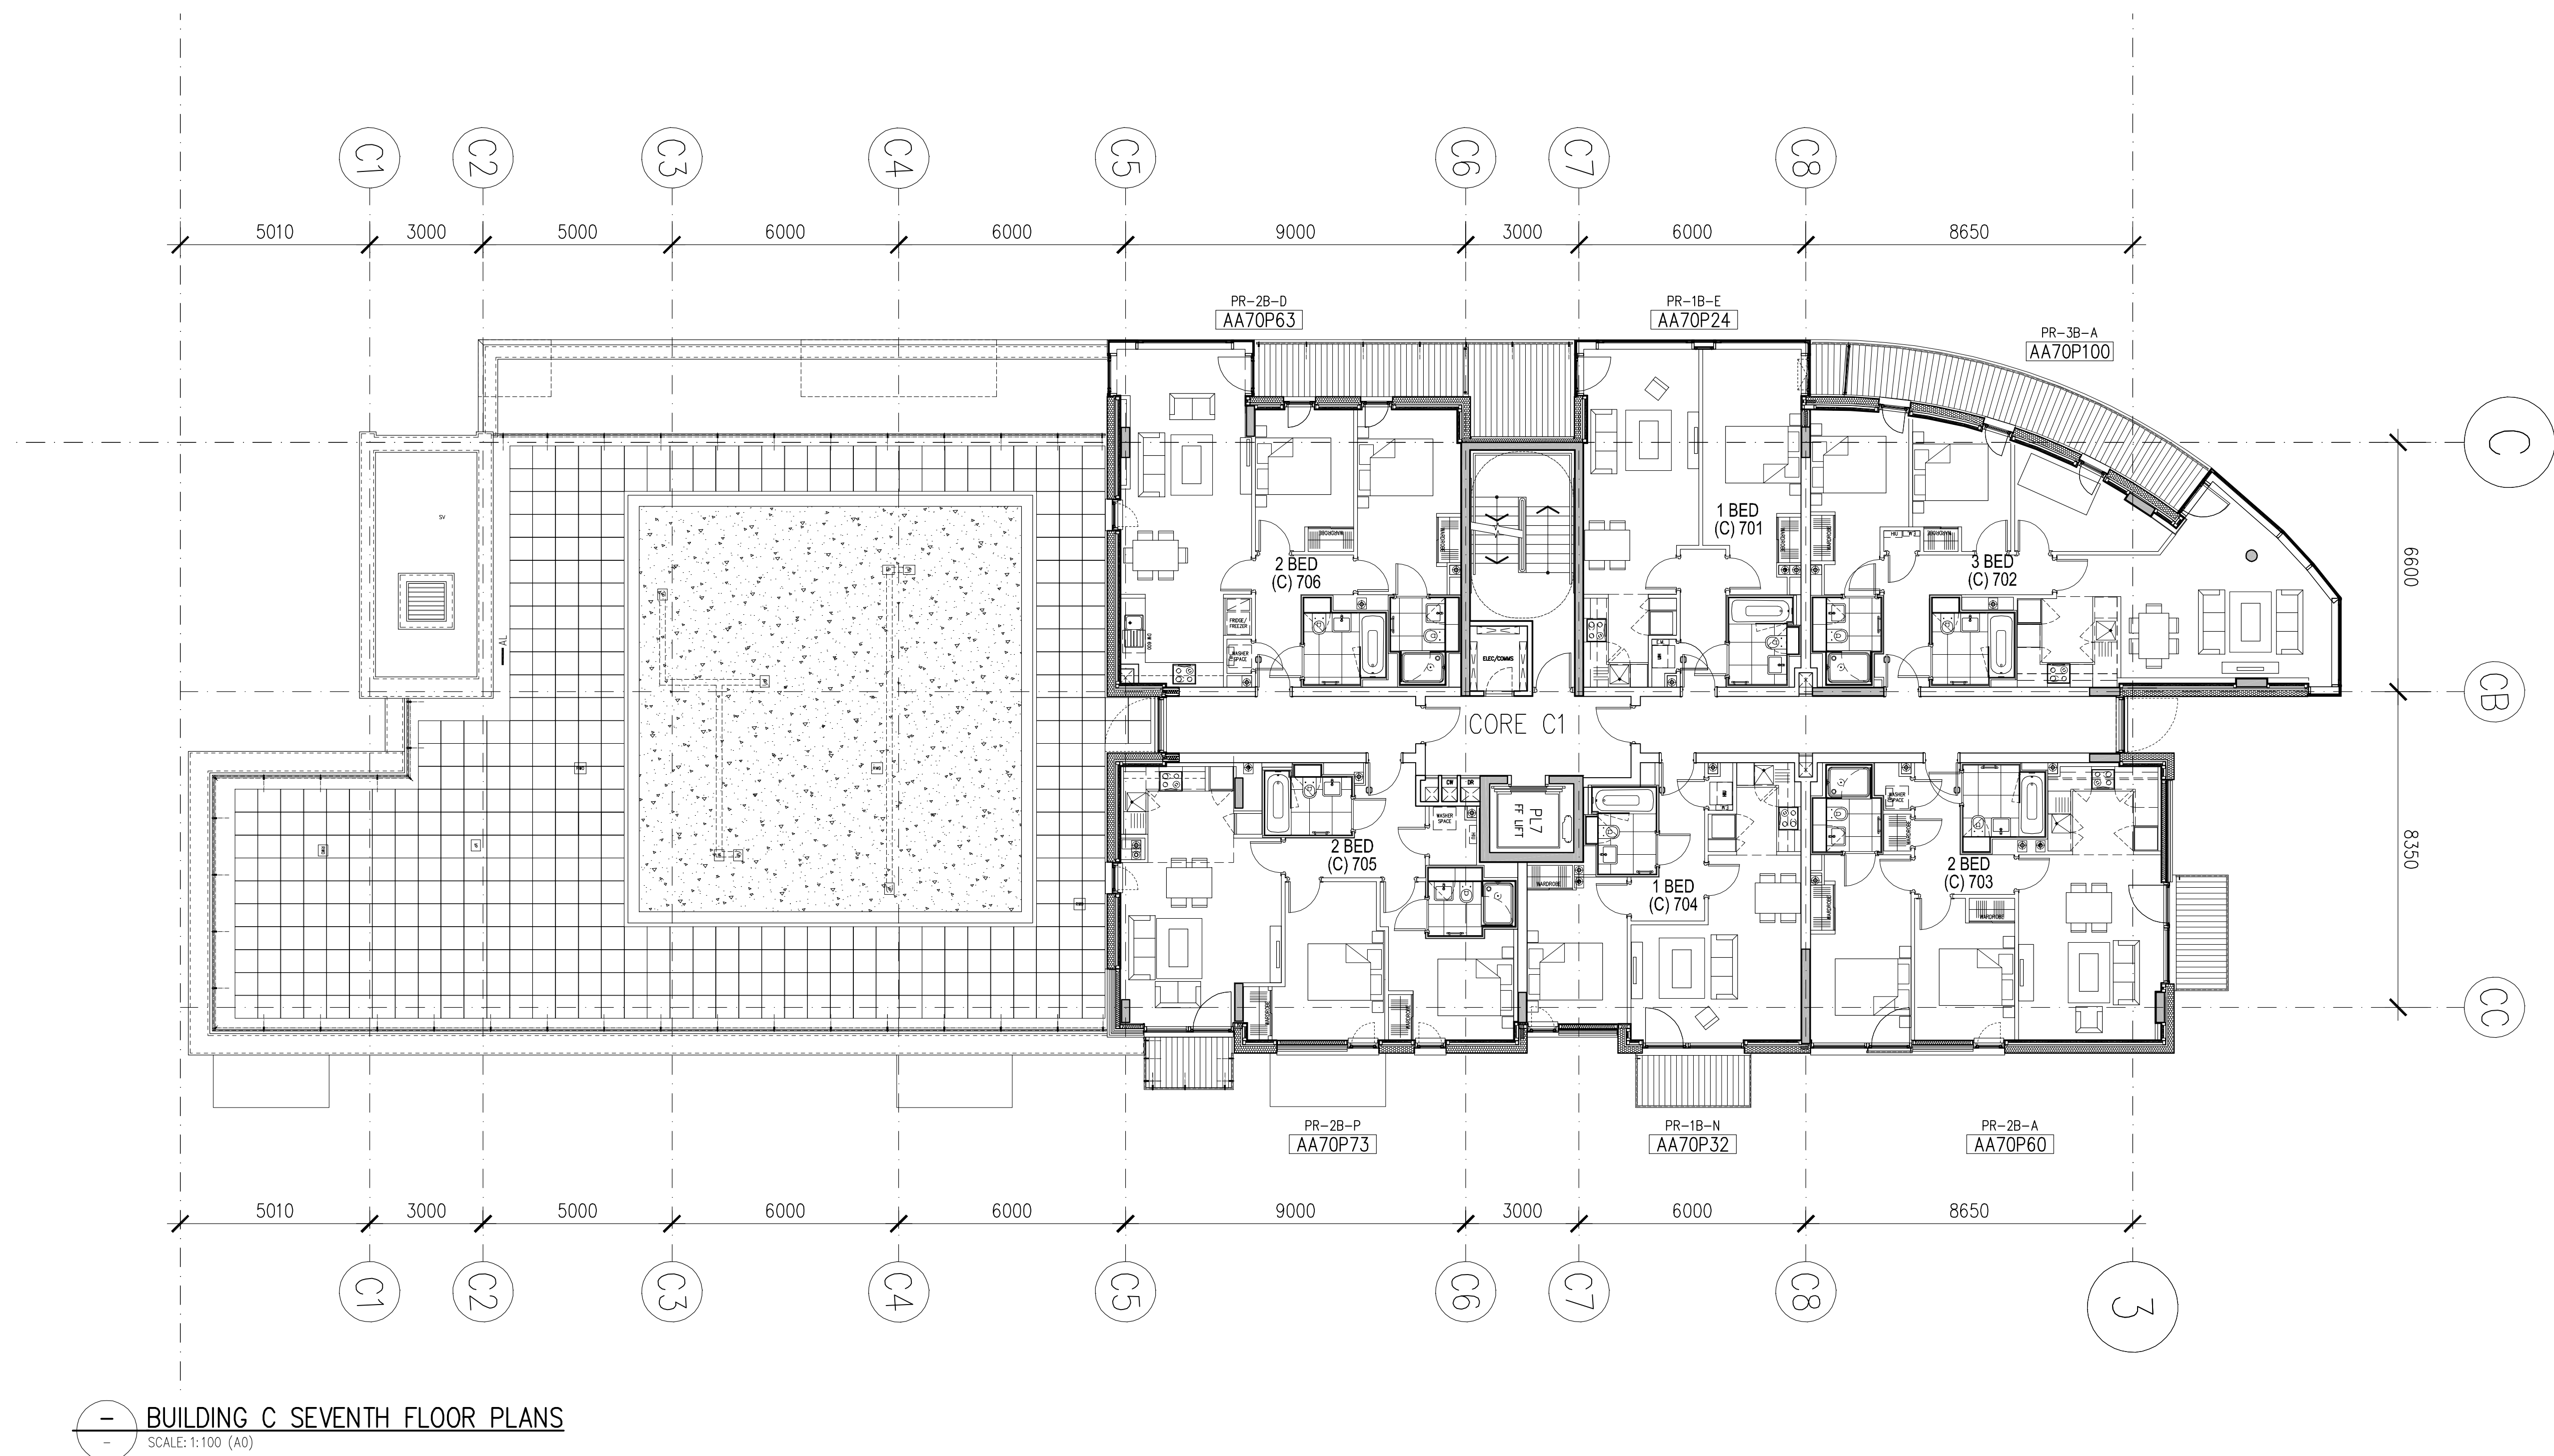

RECORD COPY

RD1 FINAL CONSTRUCTION ISSUE FOR BLOCKS B AND C	28/02/12
CR KITCHEN P-A1 - WALL ADDED	13/02/12
ISSUED FOR CONSTRUCTION	02/12/11
C7 KITCHEN P-A1 UPDATED	17/11/11
C8 HANDWORKS UPDATED	10/10/11
C5 FOLDING PARTITION TO 3 BED APARTMENT	10/10/11
OMITTED	
C4 BLOCK C APARTMENTS RENUMBERED AS POSTAL	12/09/11
C3 BLOCK B APARTMENTS RENUMBERED AS B1	09/02/11
C2 ROOF LAYOUT AMENDED TO ALLOW MORE	17/10/11
AMENITY SPACE. ISSUED FOR CONSTRUCTION	03/10/11
C1 DRY LIVING CONSTRUCTION ISSUE	29/09/11
FLAT LAYOUTS GENERAL UPDATE	30/04/11
SERVICES COORDINATION ISSUE	
ISSUED FOR COMMENTS	
5 SITE CO-ORDINATION ISSUE	30/04/11
ISSUED FOR COMMENT	
4 ISSUED FOR STAGE 1 DRY LIVING TENDER	24/03/11
3 ISSUED FOR STAGE 2 CLADDING TENDER	12/03/11
2 GENERAL UPDATE	22/12/10
1 SITE WIDE CO-ORDINATION BETWEEN PLANS AND ELEVATIONS	07/12/10

Rev | | Date

Rolfe Judd
Architecture Planning Interiors

Old Church Court, Clevedon Road, The Oval, London SW16 1AZ
T 020 7556 1900
www.rolfe-judd.co.uk

Client
BALLYMORE (HAYES) LIMITED

Project
HIGH POINT VILLAGE

Drawing
**BUILDING B & C
SEVENTH FLOOR PLANS**

Scale 1:100 (A0)	Date SEPT 2006	Drawn TR
Drawing No 3942 / BA(20)P07	Revision RD1	
CAD Ref No C:\3942\A-Series\Building B\BA20\BA20P07		
© Copyright Rolfe Judd Ltd		