


THIS DRAWING IS NOT TO BE SCALED.
THE GENERAL CONTRACTOR IS TO CHECK ALL DIMENSIONS AND NOTIFY
ARCHITECT OF ANY DISCREPANCIES OR OMISSIONS.

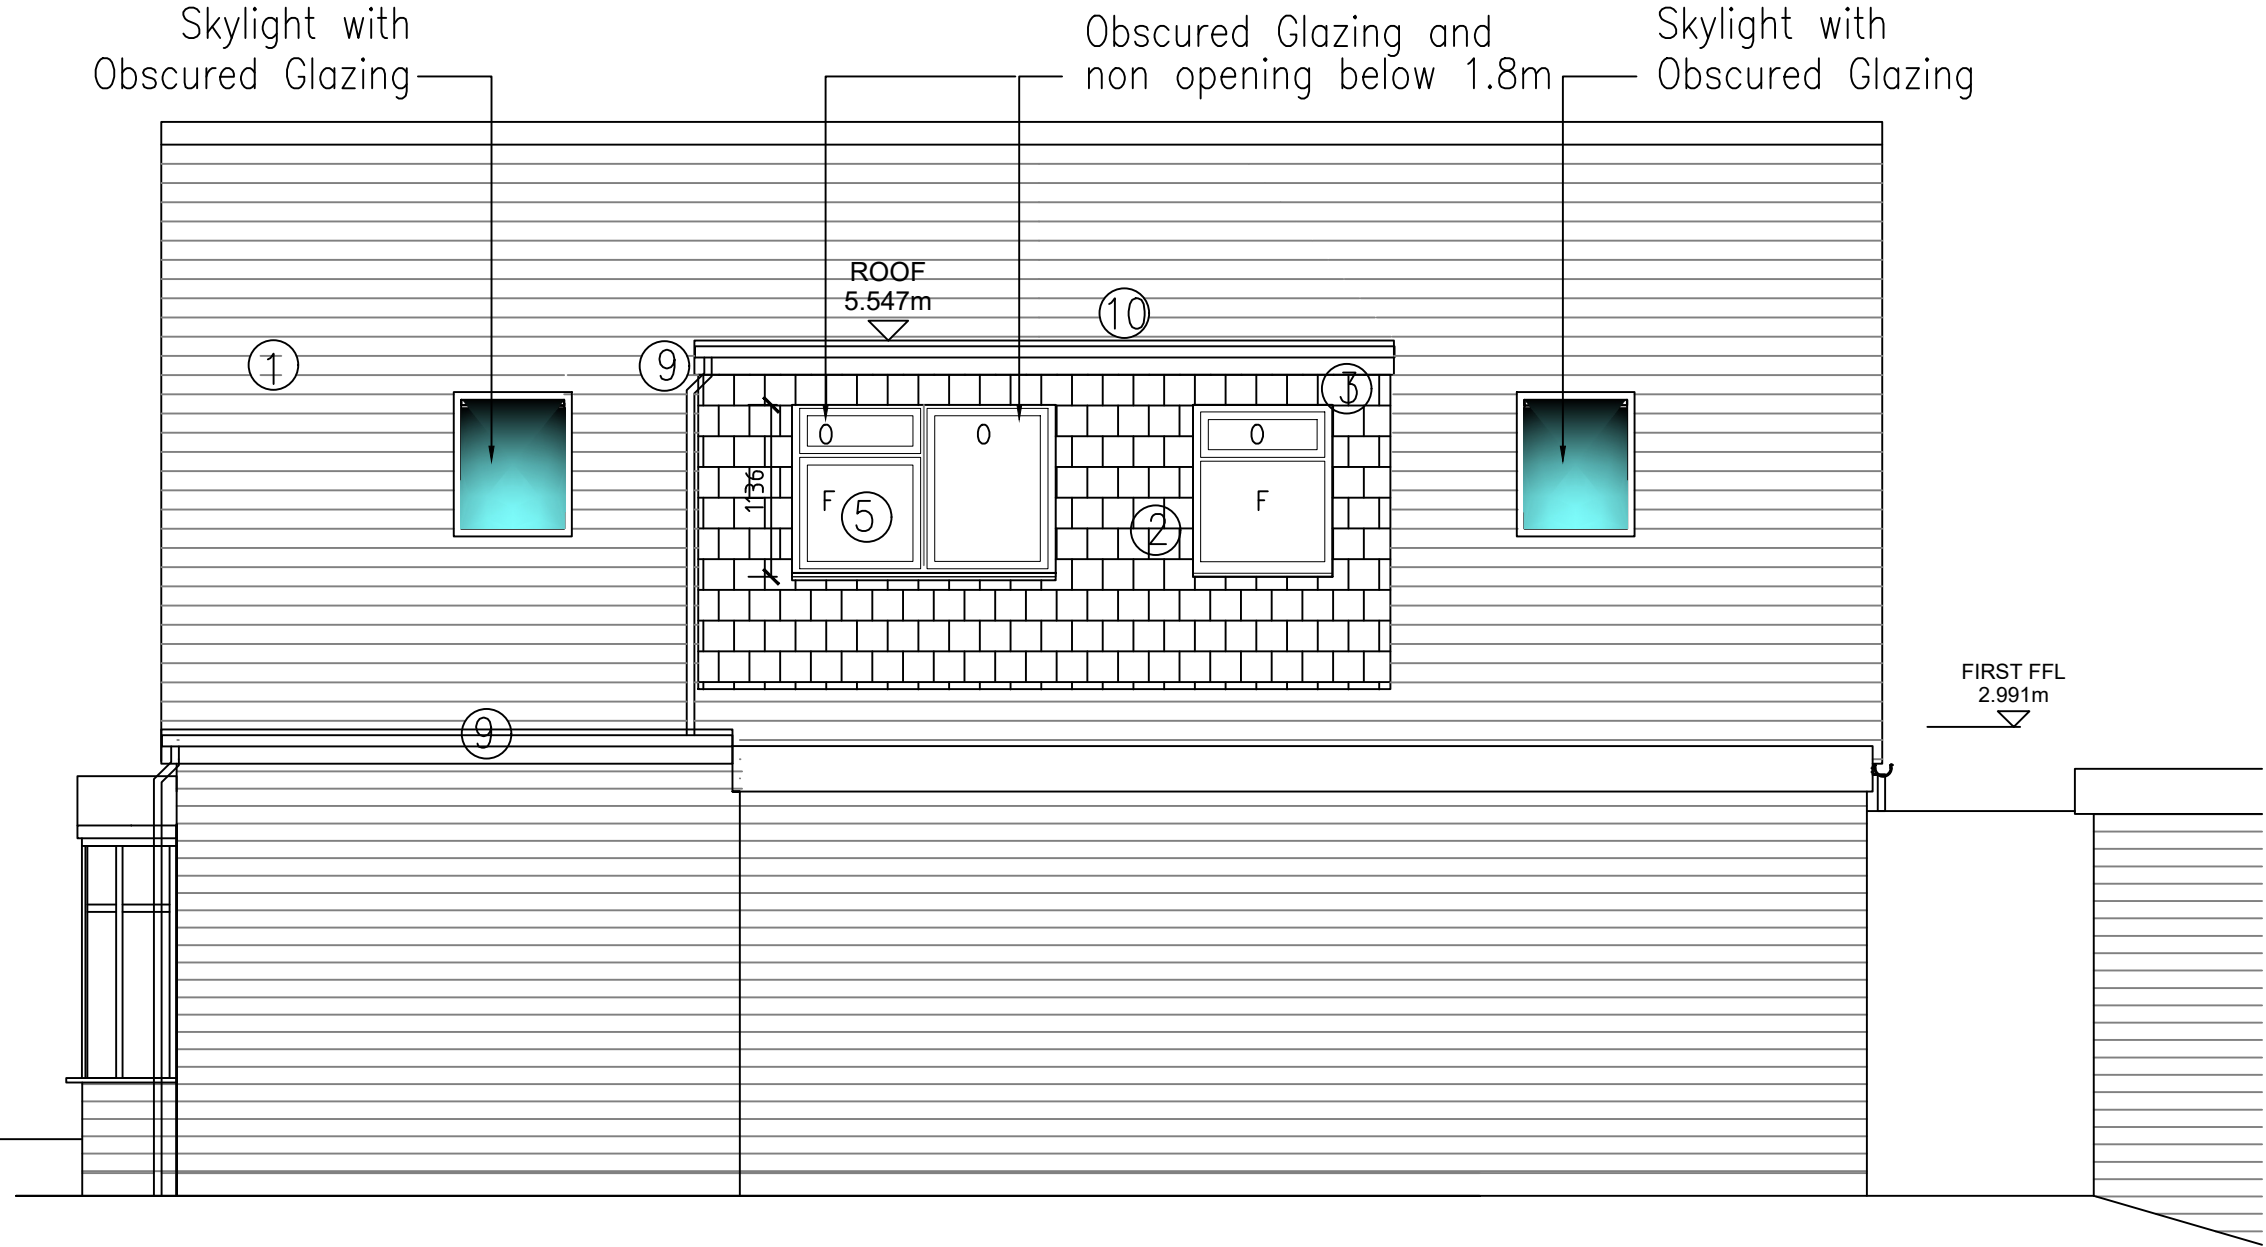

- Materials Key
- ① Redland Double Roman tiles roof to match existing
 - ② Charcoal grey hanging tiles
 - ③ Treated Timber fascia and soffit painted white
 - ④ Facing brick with sand colour mortar joints to match existing
 - ⑤ uPVC casement windows in white
 - ⑥ PPC Aluminium Doors in Anthracite Grey
 - ⑦ French Doors with side glazed panels in white
 - ⑧ Glass balustrade with stainless steel hand rail
 - ⑨ Black uPVC Rainwater gutter and downpipes
 - ⑩ GRP roof in grey
 - ⑪ Fixed Glazing
 - ⑫ Rendered wall with brick plinth

PROPOSED NORTH ELEVATION

AS BUILT ISSUE

B All side windows to be obscured and non opening below 1.8m 20.05.24



4D ARCHITECTS LTD
PLANNING INTERIORS ARCHITECTURE

10 Dene Garens, Thames Ditton, KT17 0BJ T:+44 7702604568 www.4darchitects.co.uk

CLIENT T Dallal
PROJECT 103 HALFORD ROAD, ICKENHAM
TITLE PROPOSED NORTH ELEVATION

SCALE 1:50@A3
DATE JUNE 2023
DRN MS

DRG NO 2314 CON 09
REV. B