
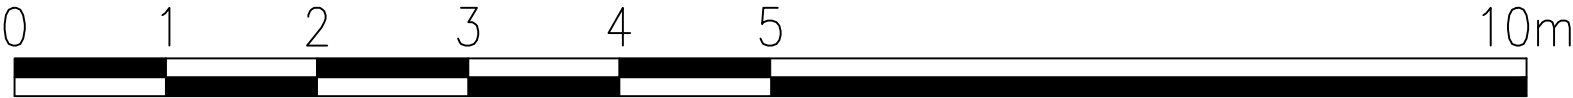


THIS DRAWING IS NOT TO BE SCALED.
THE GENERAL CONTRACTOR IS TO CHECK ALL DIMENSIONS AND NOTIFY ARCHITECT OF ANY DISCREPANCIES OR OMISSIONS.

Skylight with Obscured Glazing Obscured Glazing and non opening below 1.8m Skylight with Obscured Glazing

- Materials Key
- ① Redland Double Roman tiles roof to match existing
 - ② Charcoal grey hanging tiles
 - ③ Treated Timber fascia and soffit painted white
 - ④ Facing brick with sand colour mortar joints to match existing
 - ⑤ uPVC casement windows in white
 - ⑥ PPC Aluminium Doors in Anthracite Grey
 - ⑦ French Doors with side glazed panels in white
 - ⑧ Glass balustrade with stainless steel hand rail
 - ⑨ Black uPVC Rainwater gutter and downpipes
 - ⑩ GRP roof in grey
 - ⑪ Fixed Glazing
 - ⑫ Rendered wall with brick plinth

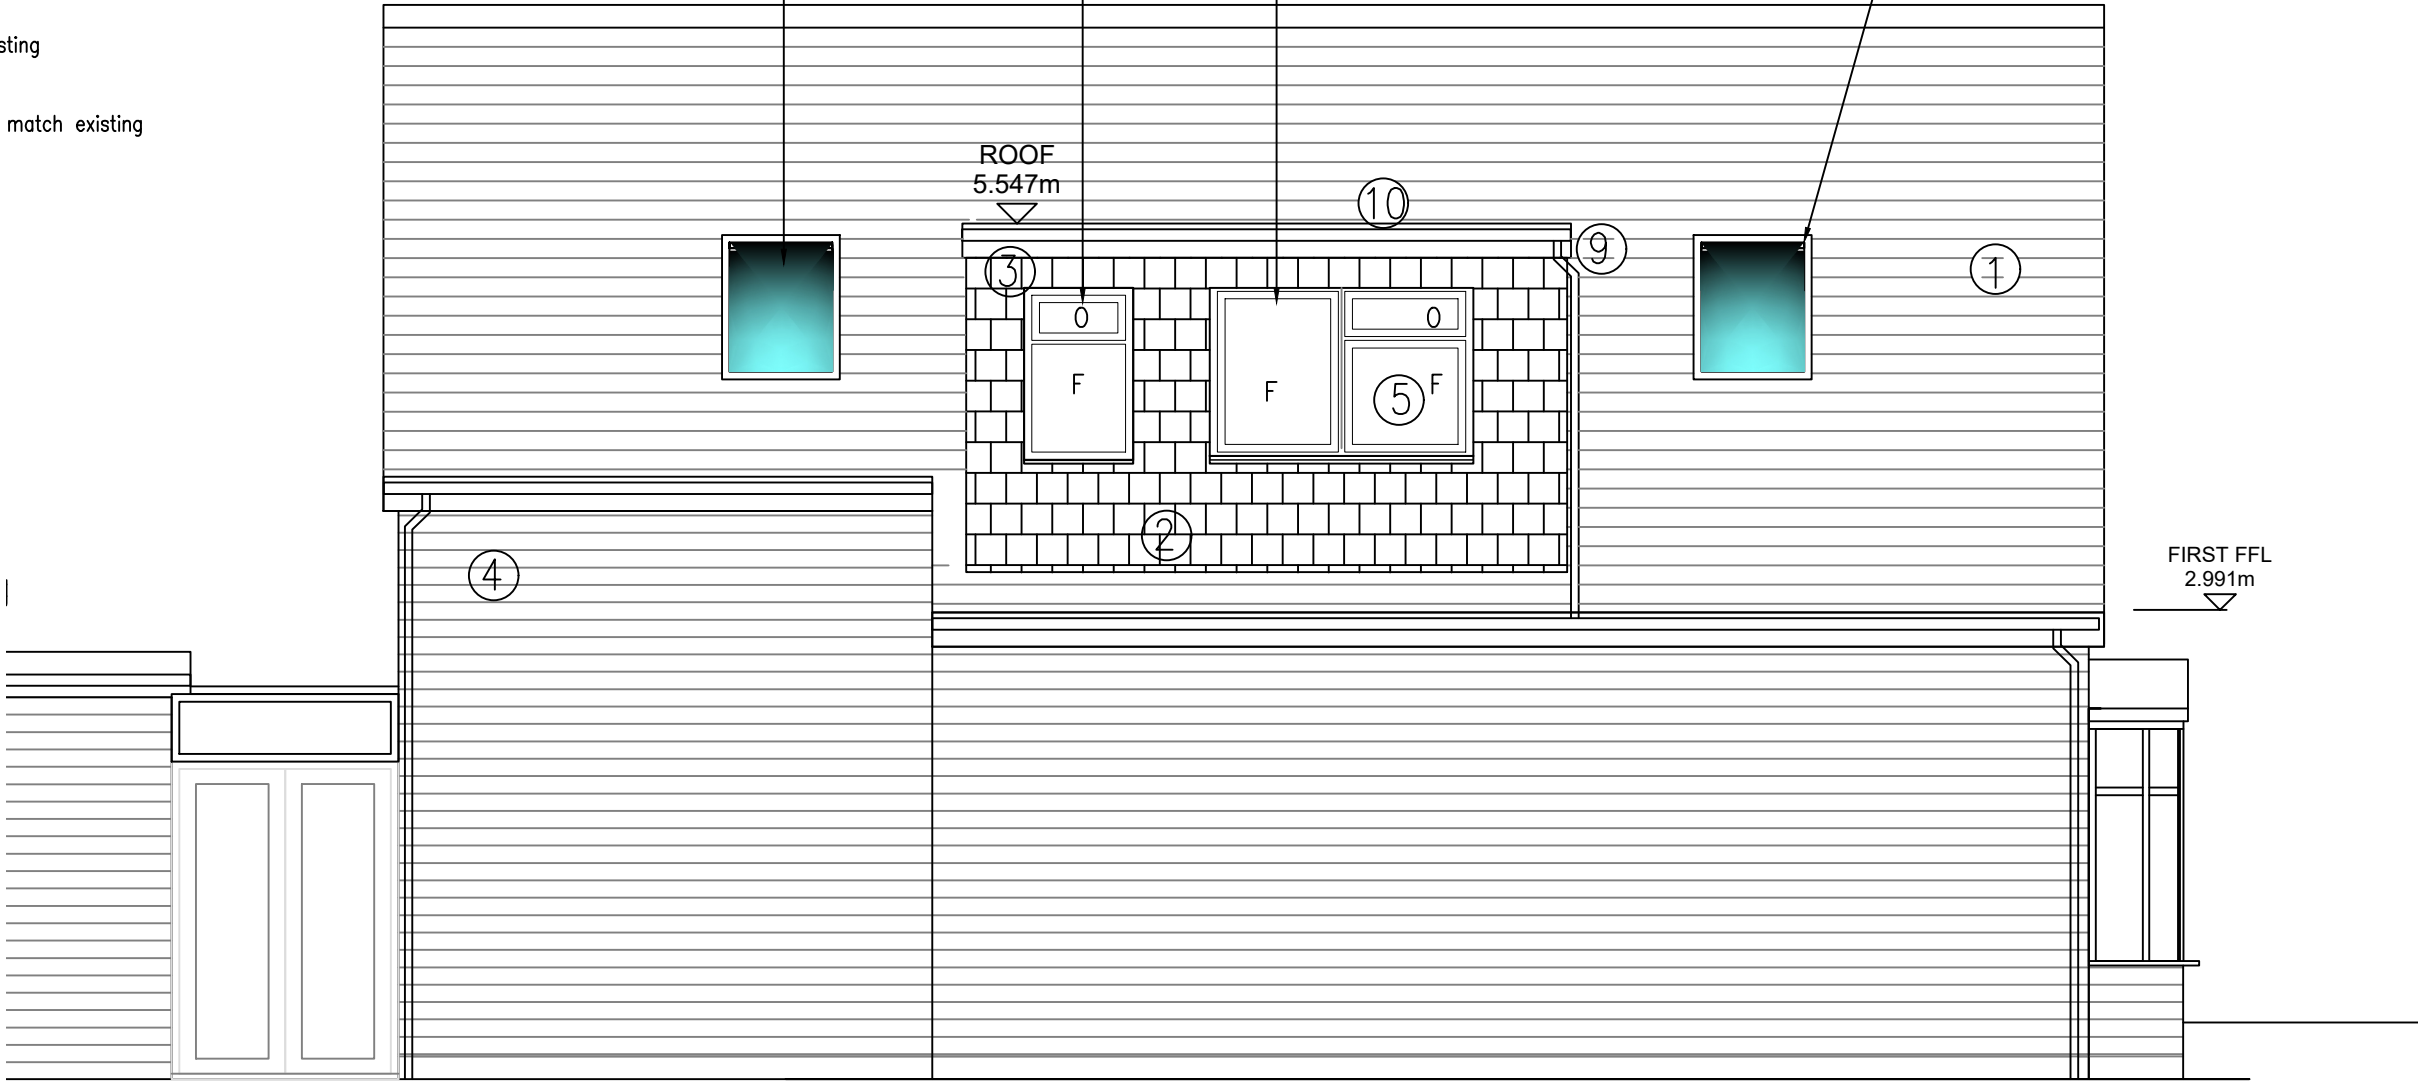

AS BUILT ISSUE

B All side windows to be obscured and non opening below 1.8m 20.05.24
REV. DESCRIPTION DATE



4D ARCHITECTS LTD
PLANNING INTERIORS ARCHITECTURE

10 Dene Garens, Thames Ditton, KT7 0BJ T: +44 7702604568 www.4darchitects.co.uk

CLIENT T Dallal
PROJECT 103 HALFORD ROAD, ICKENHAM
TITLE PROPOSED SOUTH ELEVATION

SCALE 1:50@A3
DATE JUNE 2023
DRN MS

DRG NO 2314 CON 10
REV. B