



THIS DRAWING IS NOT TO BE SCALED.
THE GENERAL CONTRACTOR IS TO CHECK ALL DIMENSIONS AND NOTIFY ARCHITECT OF ANY DISCREPANCIES OR OMISSIONS.

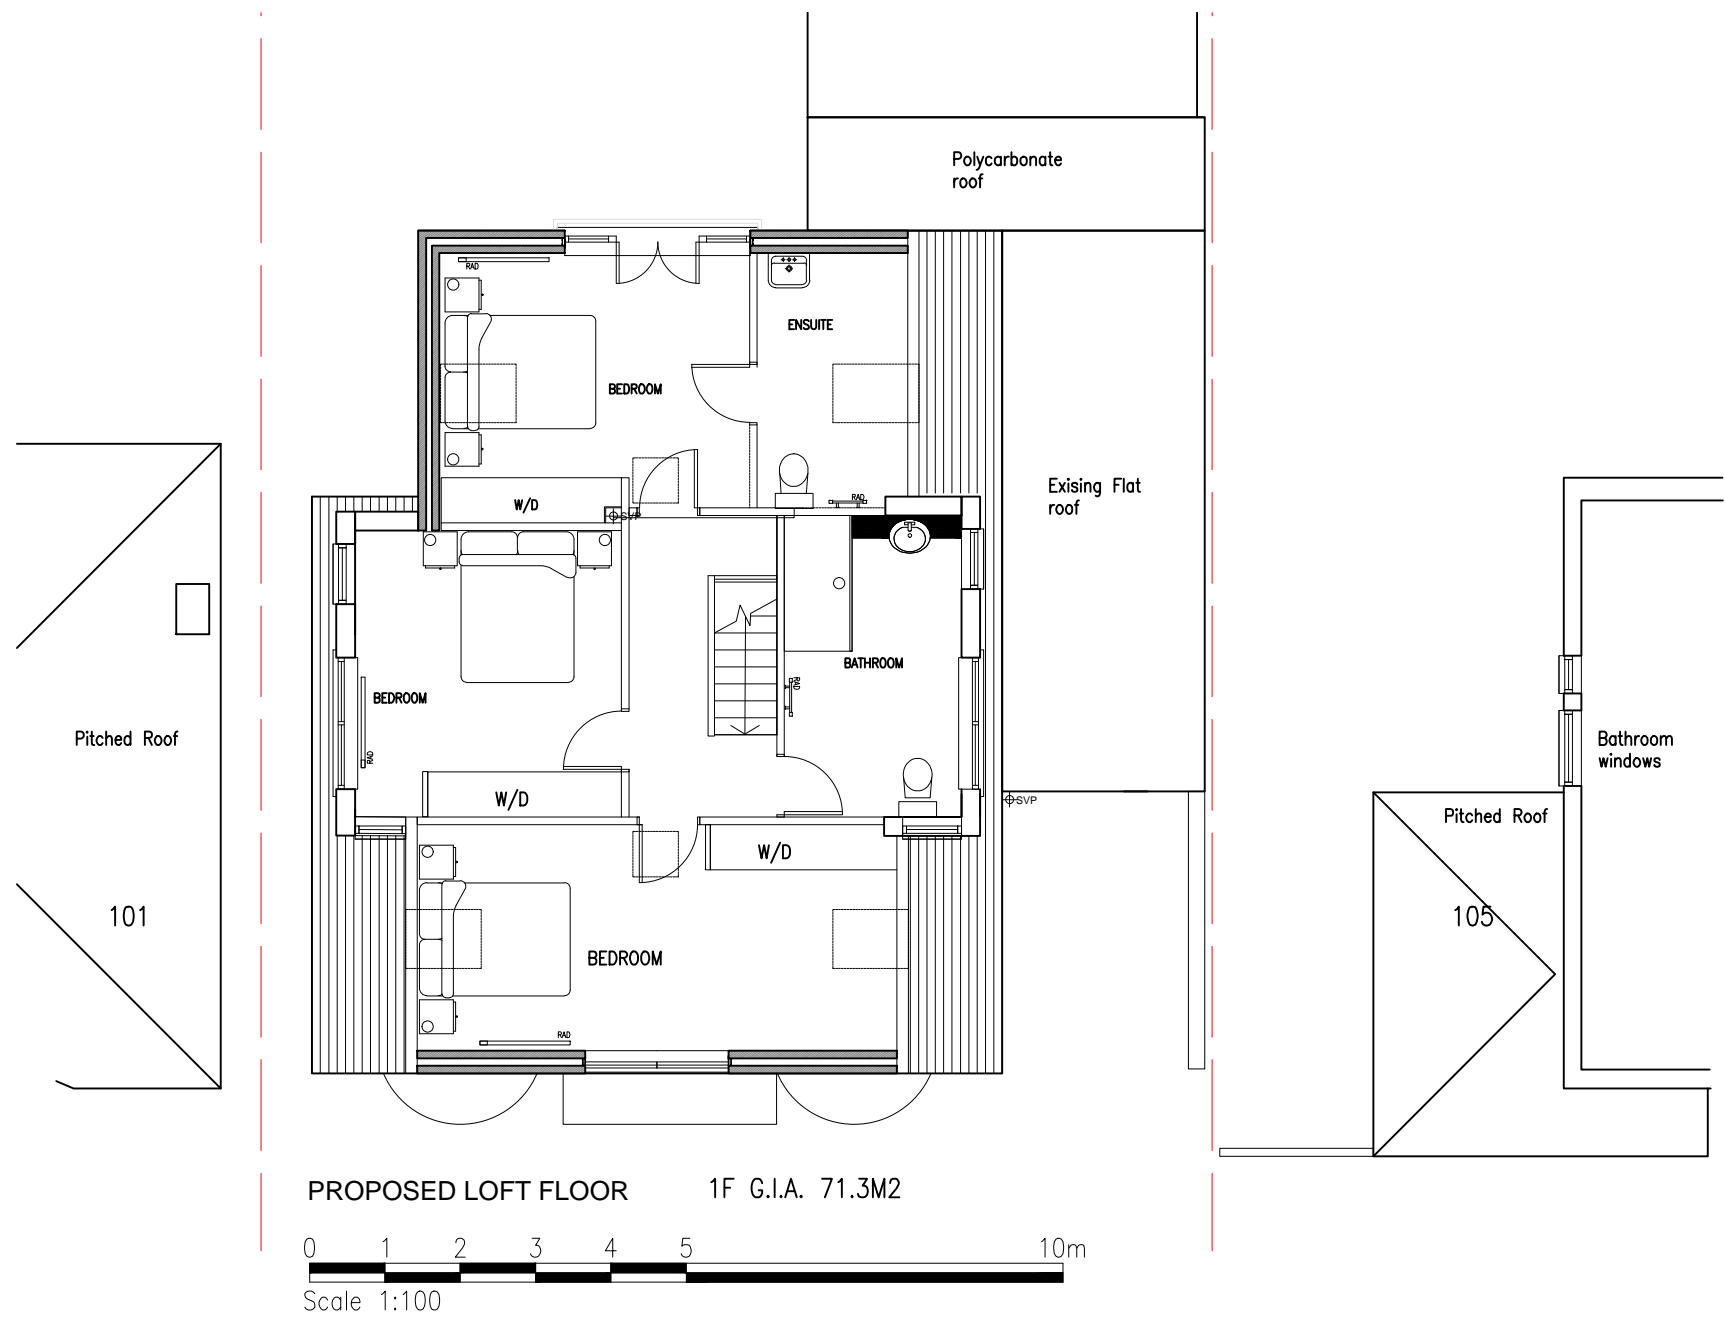

B amended to As Built

 10 Dene Gares, Thames Ditton, KT7 0BJ T:+44 7702604568 www.4darchitects.co.uk	4D ARCHITECTS LTD PLANNING INTERIORS ARCHITECTURE		CLIENT	T Dallal	SCALE	1:100@A3	DRG NO 2314 PL06
			PROJECT	103 HALFORD ROAD, ICKENHAM	DATE	JUNE 2023	
			TITLE	PROPOSED LOFT FLOOR PLAN	DRN	MS	REV. B