


1 Pre-Existing Ground Floor
1 : 100

0m 1m 2m 3m 4m 5m

VISUAL SCALE 1:50 @ A3

0m 2m 4m 6m 8m 10m


VISUAL SCALE 1:100 @ A3

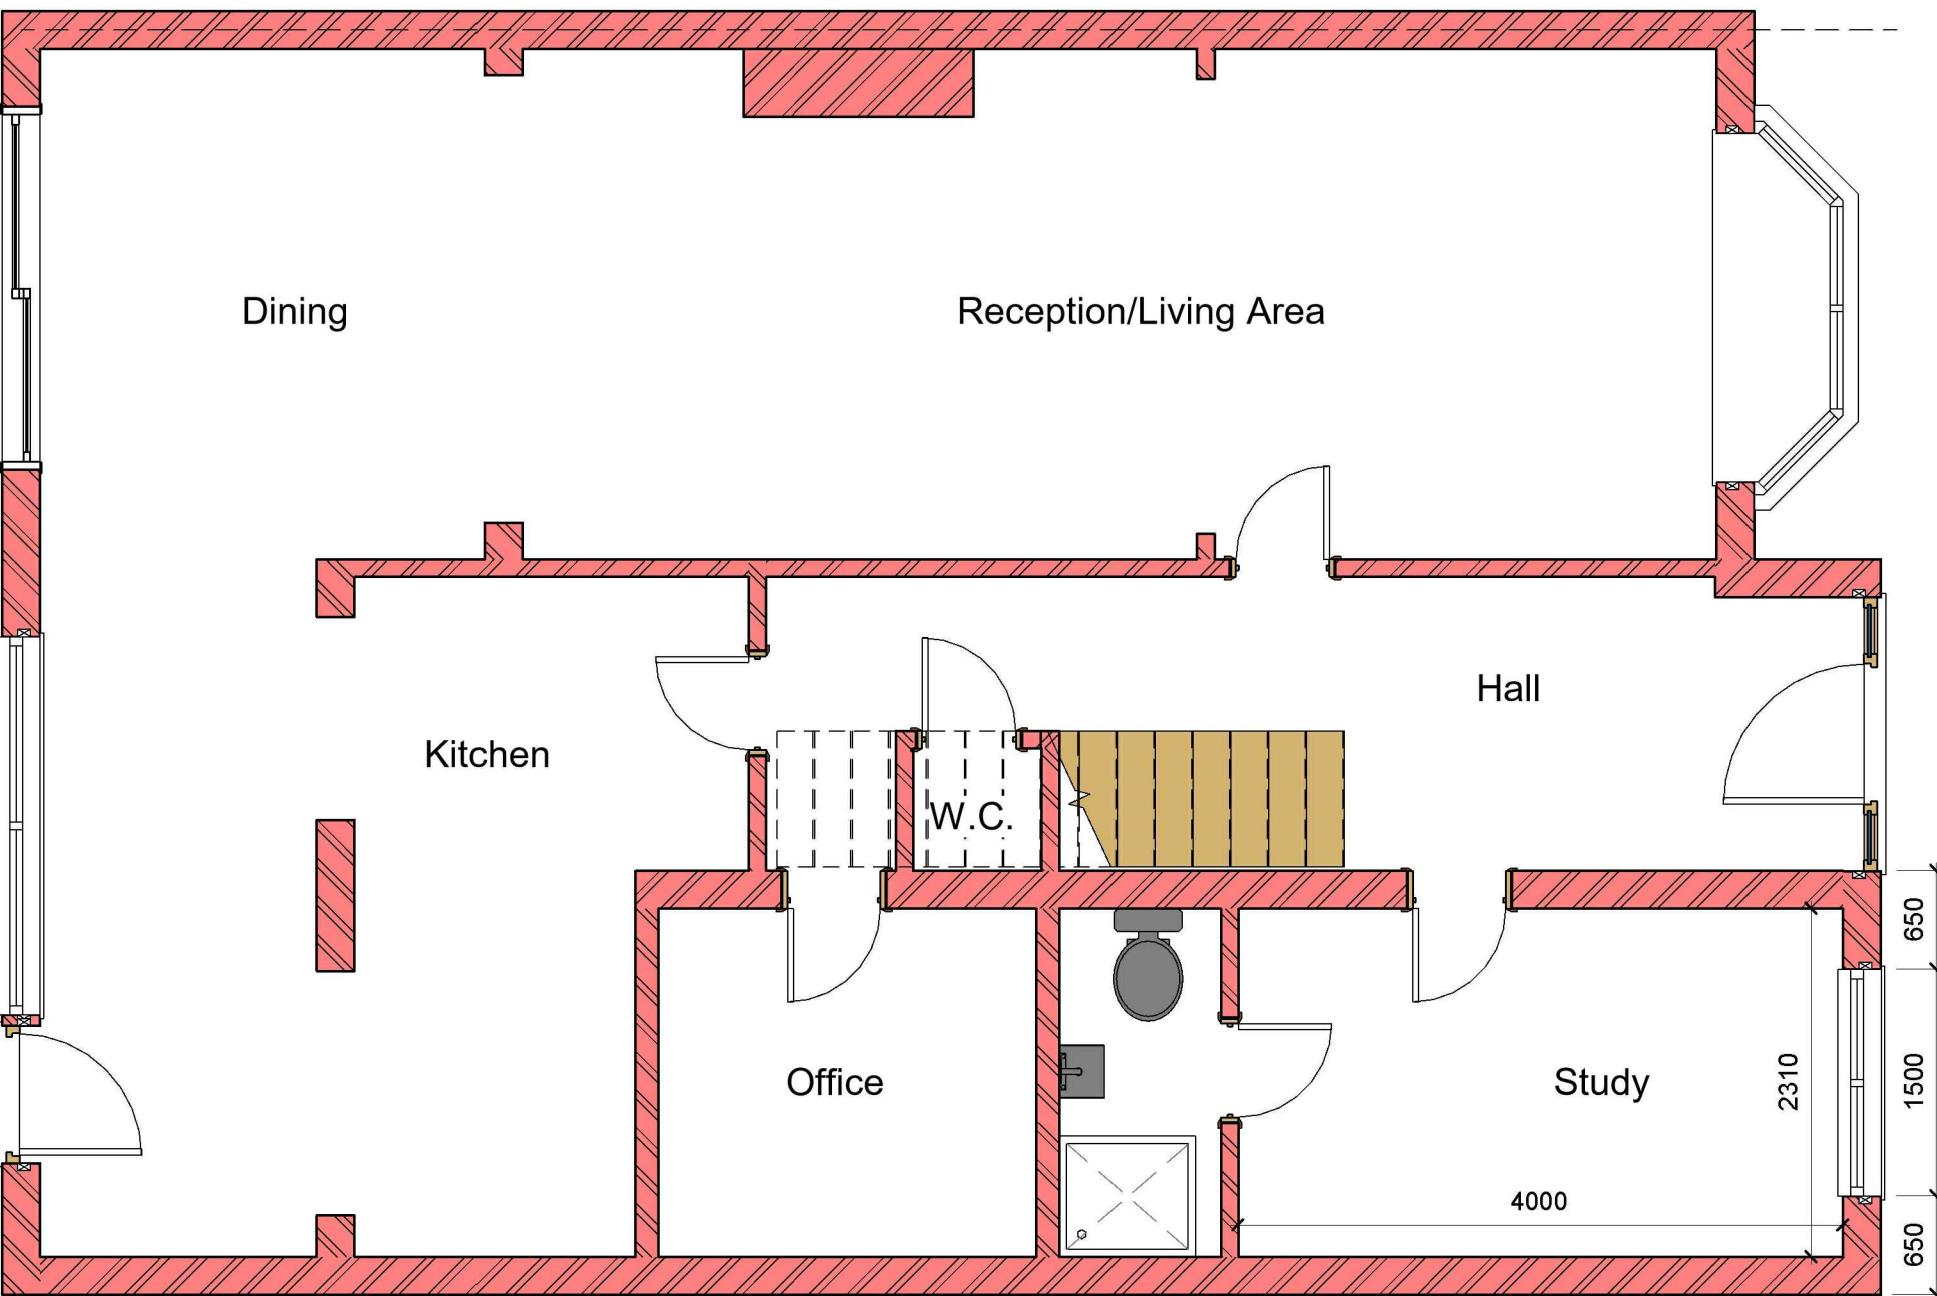


2 As-Built Ground Floor
1 : 50

GENERAL NOTES:


1. DO NOT SCALE FROM THE DRAWINGS
2. ALL DIMENSIONS ARE IN MILLIMETER.
3. VERIFY ALL DIMENSIONS AND CONDITIONS BEFORE BUILDING OR STARTING CONSTRUCTION.
4. NOTIFY THE DESIGNER IMMEDIATELY OF ANY DISCREPANCY OR VARIATION.
5. ALL WORK TO COMPLY WITH CURRENT BUILDING REGULATIONS AND CODES OF PRACTICE.

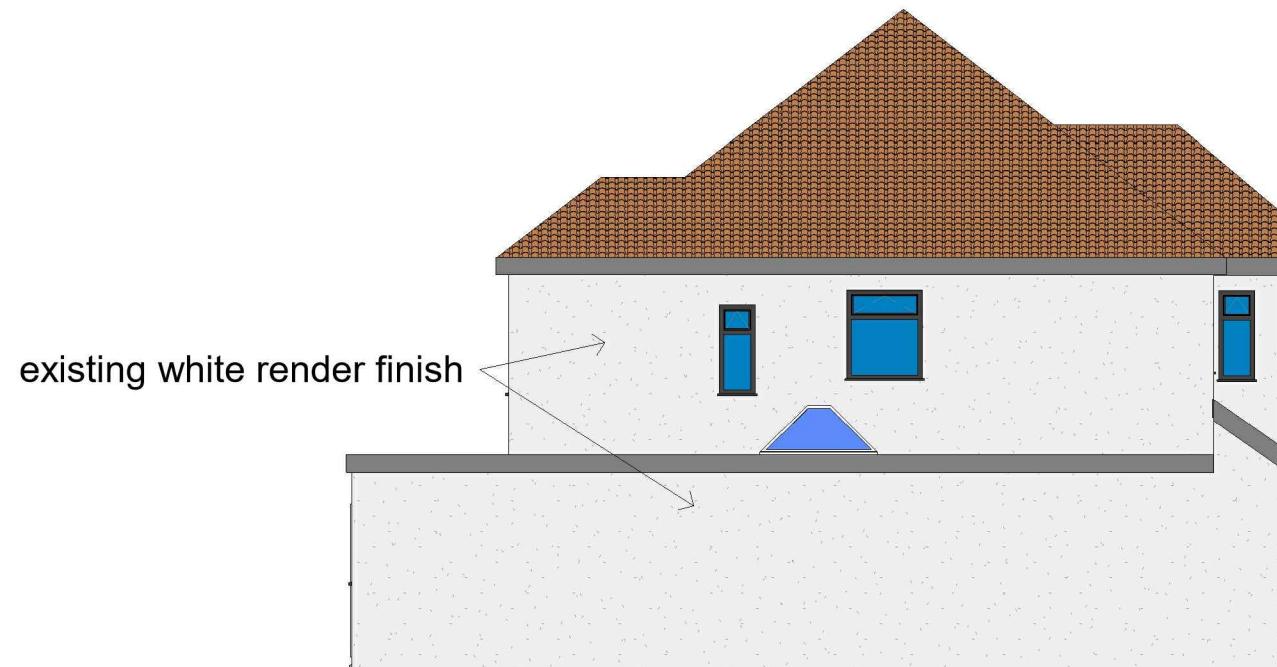

1 Pre-Existing Front_Elevation
1 : 100

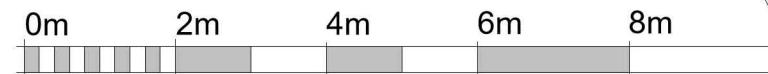

VISUAL SCALE 1:100 @ A3

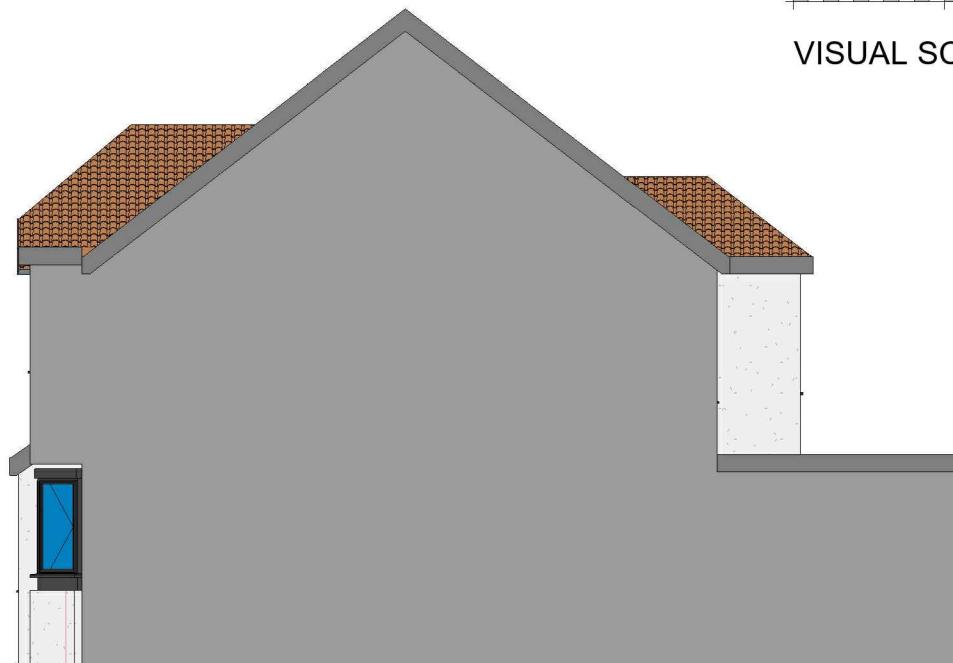

2 Pre-Existing Side 02_Elevation
1 : 100


existing white render finish




3 Pre-Existing Side 01_Elevation
1 : 100

GENERAL NOTES:


1. DO NOT SCALE FROM THE DRAWINGS
2. ALL DIMENTIONS ARE IN MILLIMETER.
3. VERIFY ALL DIMENSIONS AND CONDITIONS BEFORE BUILDING OR STARTING CONSTRUCTION.
4. NOTIFY THE DESIGNER IMMEDIATELY OF ANY DISCREPANCY OR VARIATION.
5. ALL WORK TO COMPLY WITH CURRENT BUILDING REGULATIONS AND CODES OF PRACTICE.

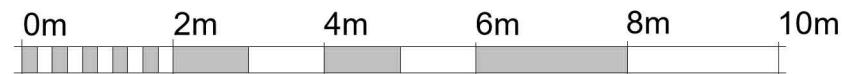


VISUAL SCALE 1:100 @ A3

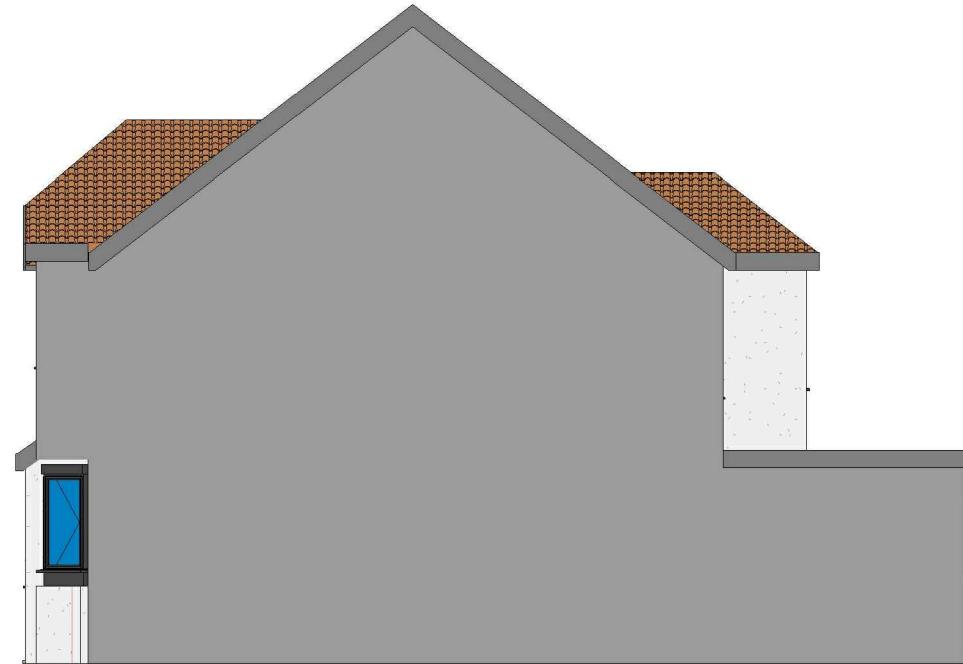

4 As-Built Front_Elevation
1 : 100

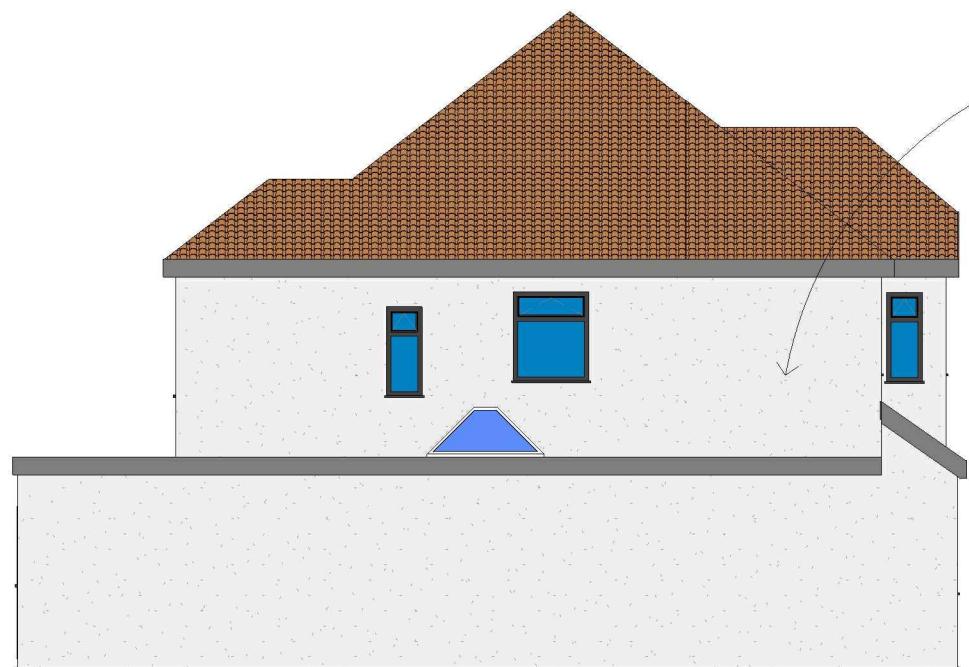

2 As-Built Side 02_Elevation
1 : 100

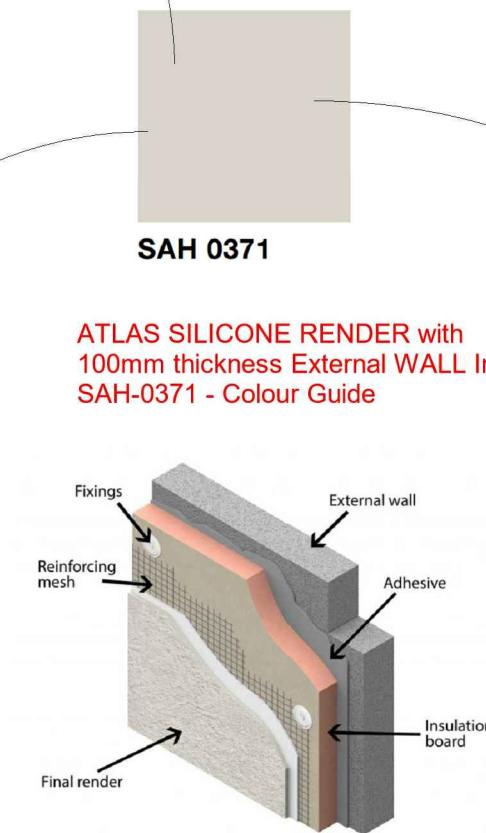


3 As-Built Side 01_Elevation
1 : 100

1 As-Built Rear_Elevation
1 : 100

GENERAL NOTES:

1. DO NOT SCALE FROM THE DRAWINGS
2. ALL DIMENSIONS ARE IN MILLIMETER.
3. VERIFY ALL DIMENSIONS AND CONDITIONS BEFORE BUILDING OR STARTING CONSTRUCTION.
4. NOTIFY THE DESIGNER IMMEDIATELY OF ANY DISCREPANCY OR VARIATION.
5. ALL WORK TO COMPLY WITH CURRENT BUILDING REGULATIONS AND CODES OF PRACTICE.

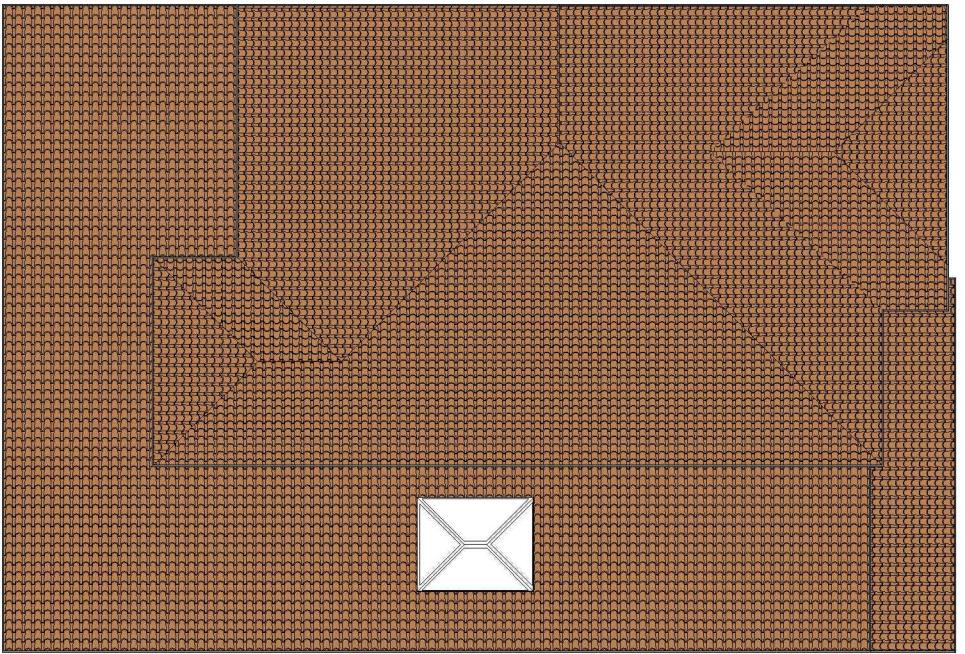


1 Pre-Existing Roof
1 : 100

0m 2m 4m 6m 8m 10m

VISUAL SCALE 1:100 @ A3

0m 1m 2m 3m 4m 5m

VISUAL SCALE 1:50 @ A3

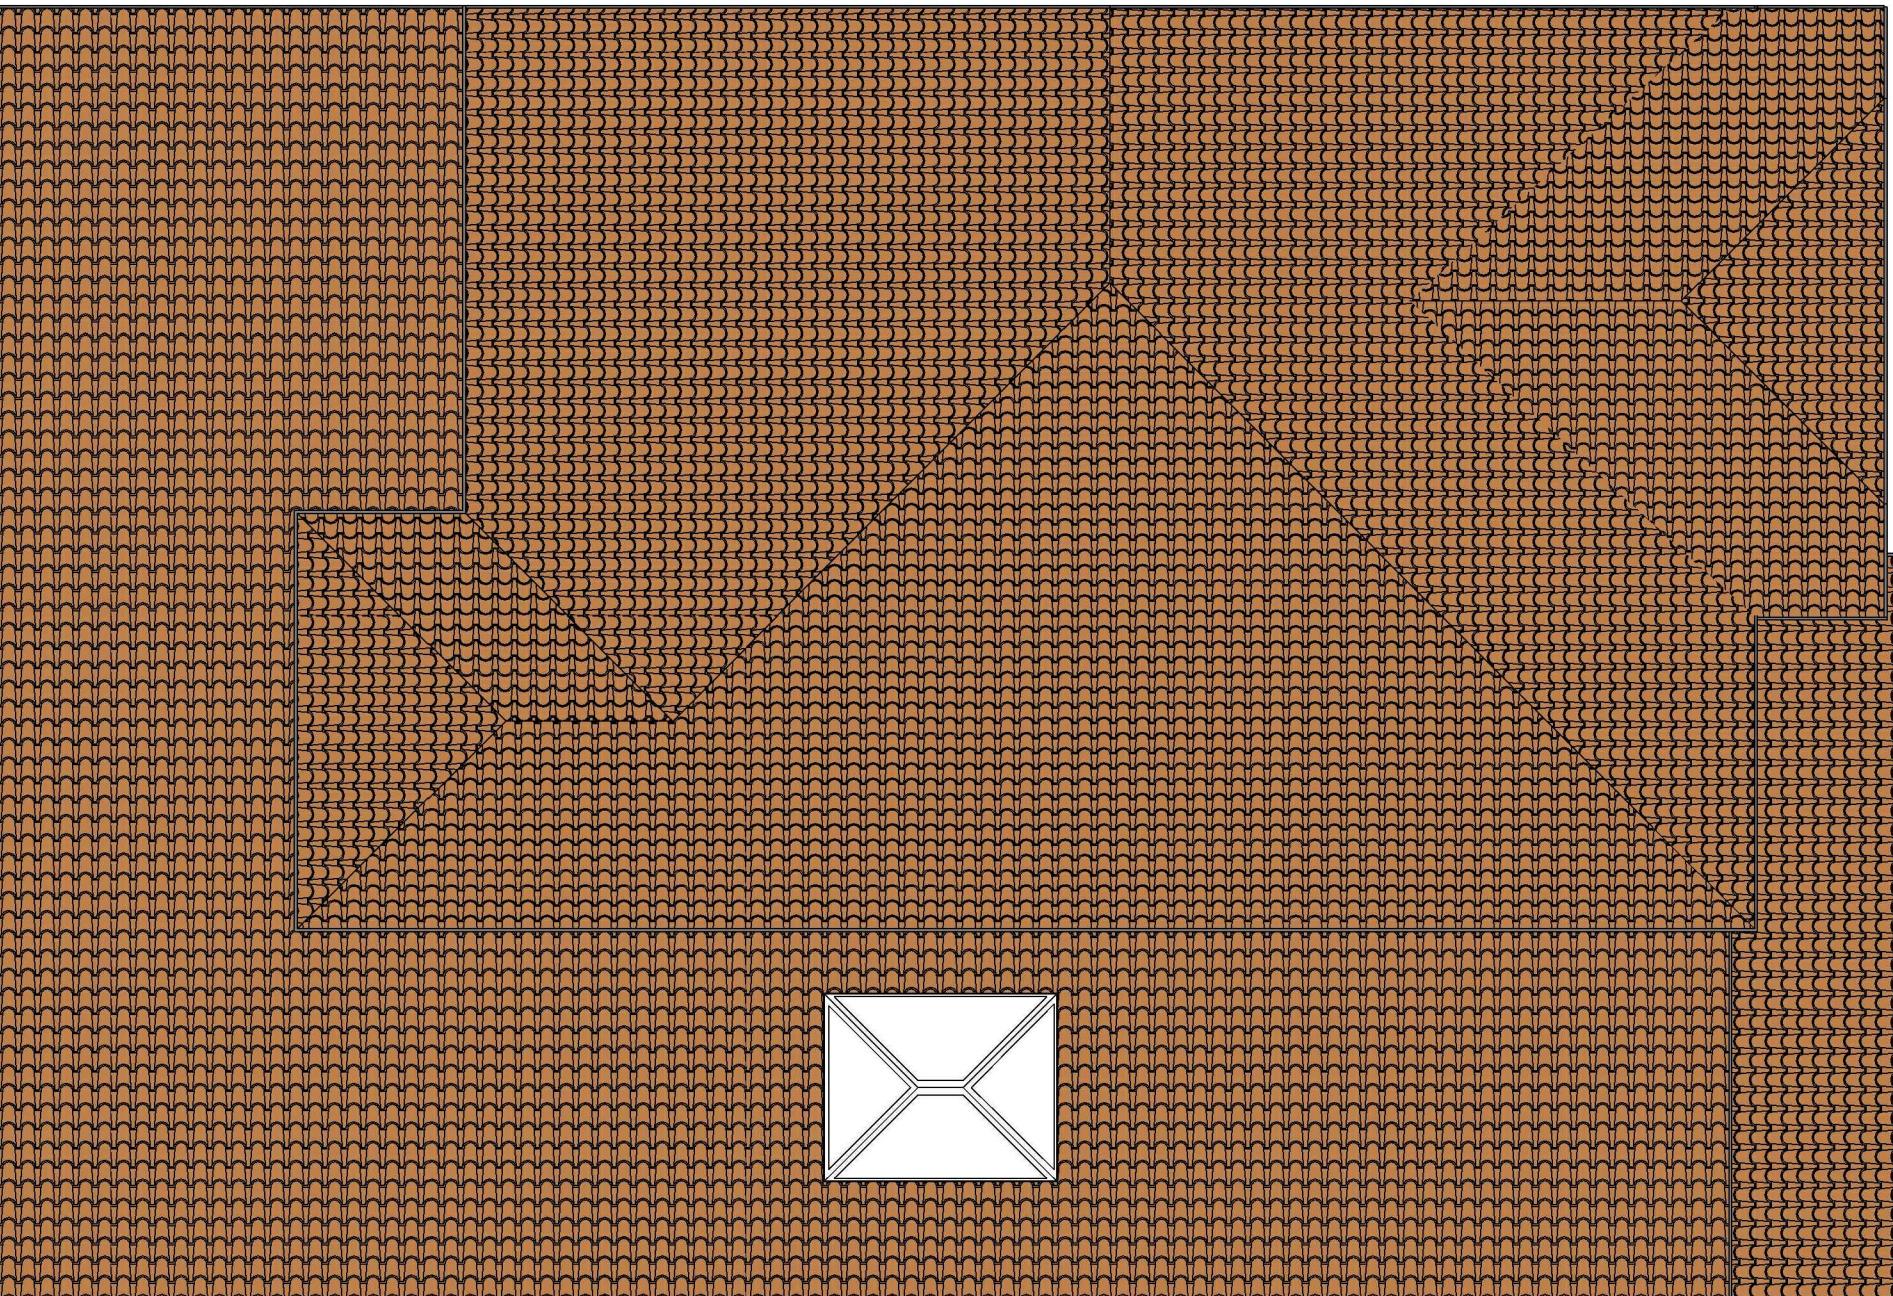

2 As-Built Roof
1 : 50

GENERAL NOTES:

1. DO NOT SCALE FROM THE DRAWINGS
2. ALL DIMENSIONS ARE IN MILLIMETER.
3. VERIFY ALL DIMENSIONS AND CONDITIONS BEFORE BUILDING OR STARTING CONSTRUCTION.
4. NOTIFY THE DESIGNER IMMEDIATELY OF ANY DISCREPANCY OR VARIATION.
5. ALL WORK TO COMPLY WITH CURRENT BUILDING REGULATIONS AND CODES OF PRACTICE.