


0m 5m 10m

NOTE

THIS DRAWING IS THE COPYRIGHT OF AMASIA ARCHITECTS LTD AND MAY NOT BE COPIED, ALTERED OR REPRODUCED IN ANY FORM, OR PASSED TO A THIRD PARTY WITHOUT THE WRITTEN CONSENT OF AMASIA ARCHITECTS LTD. DIMENSIONS SHOULD BE CHECKED AND VERIFIED ON SITE AND ANY DISCREPANCIES SHOULD BE REPORTED TO THE ARCHITECT. USE FIGURED DIMENSIONS ONLY.
IF IN DOUBT ASK FOR CONFIRMATION.

KEY:

- AS BUILT PARKING SPACES
- AS BUILT CYCLE SPACES
- ACTIVE ELECTRIC VEHICLE CHARGING POINT

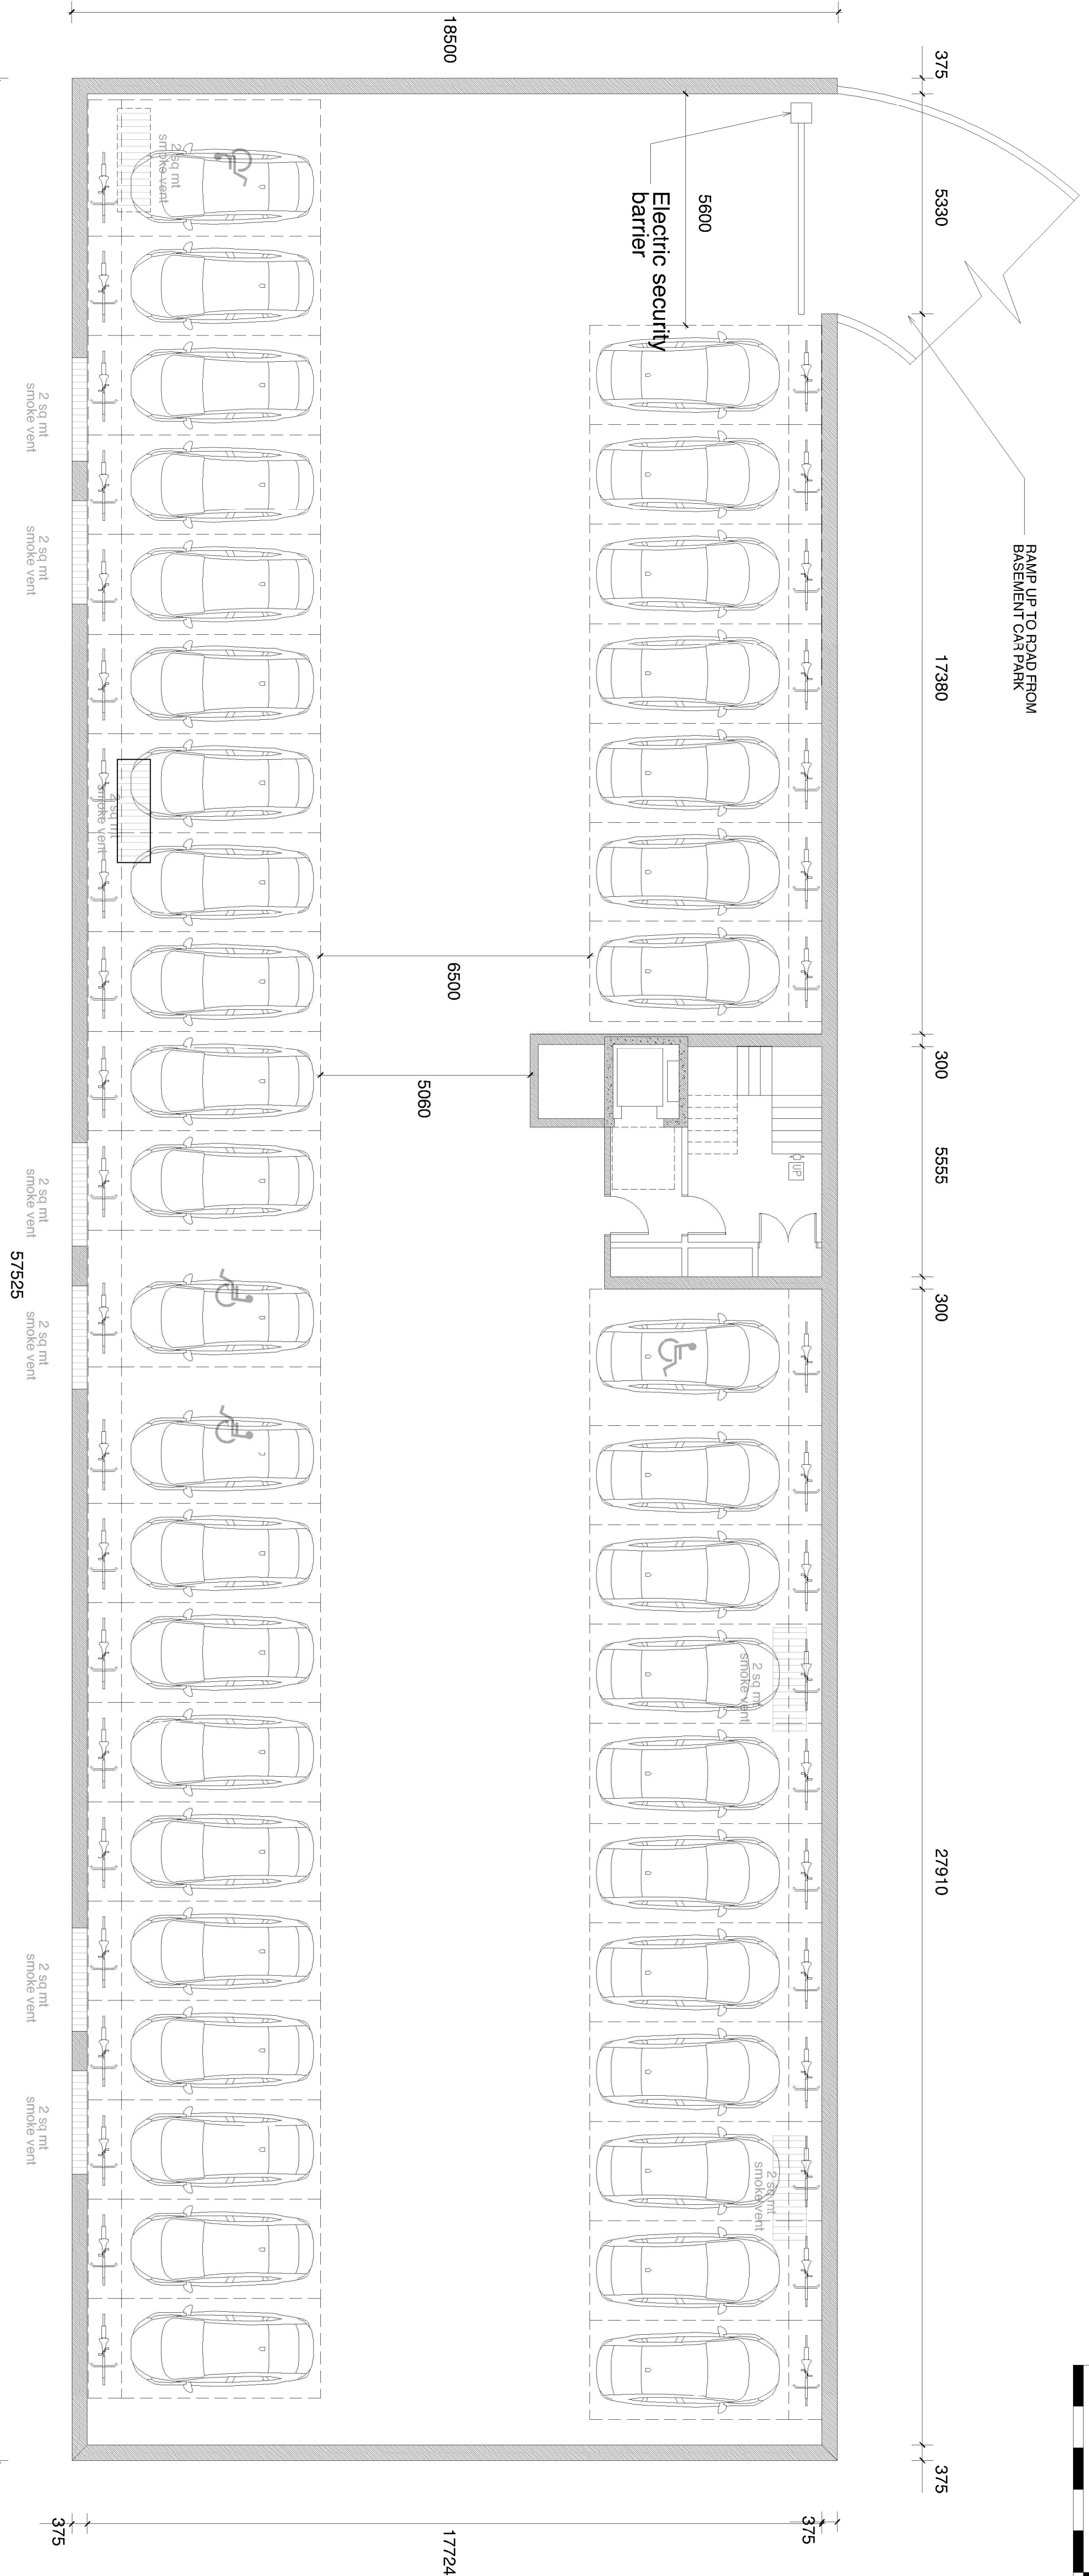

APPROVED BASEMENT PLAN (Original Approval 12768-APP-2016-1580)



REV	DESCRIPTION	DRAWN	DATE
REVISIONS			
TWO/20 PROPOSALS			
SITE ADDRESS: FORMER WEST DRAYTON POLICE STATION CONSTABULARY CLOSE WEST DRAYTON LONDON, UB7 7GE			
CLIENT: KEARNS PREMIER HOMES			
SCALE: 1:200 AI SG JAN 21			
DRAWING TITLE: APPROVED AND AS BUILT BASEMENT PLAN & PARKING LAYOUT			
DRAWING NUMBER: AAL-20-235-P03			
REVISION:			
T: 01483 205724 www.amasiaarchitects.com Copyright: Reg No. 486903 VAT Reg No. 794519110			