




NOTE

THIS DRAWING IS THE COPYRIGHT OF AMASIA ARCHITECTS LTD AND MAY NOT BE COPIED, ALTERED OR REPRODUCED IN ANY FORM, OR PASSED TO A THIRD PARTY WITHOUT THE WRITTEN CONSENT OF AMASIA ARCHITECTS LTD. DIMENSIONS SHOULD BE CHECKED AND VERIFIED ON SITE AND ANY DISCREPANCIES SHOULD BE REPORTED TO THE ARCHITECT. USE FIGURED IF IN DOUBT AS FOR CONFIRMATION.

KEY:

- AS BUILT PARKING SPACES
- AS BUILT CYCLE SPACES
- ROLEC EVMP2010 ACTIVE ELECTRIC VEHICLE CHARGING POINT (16 AMP)

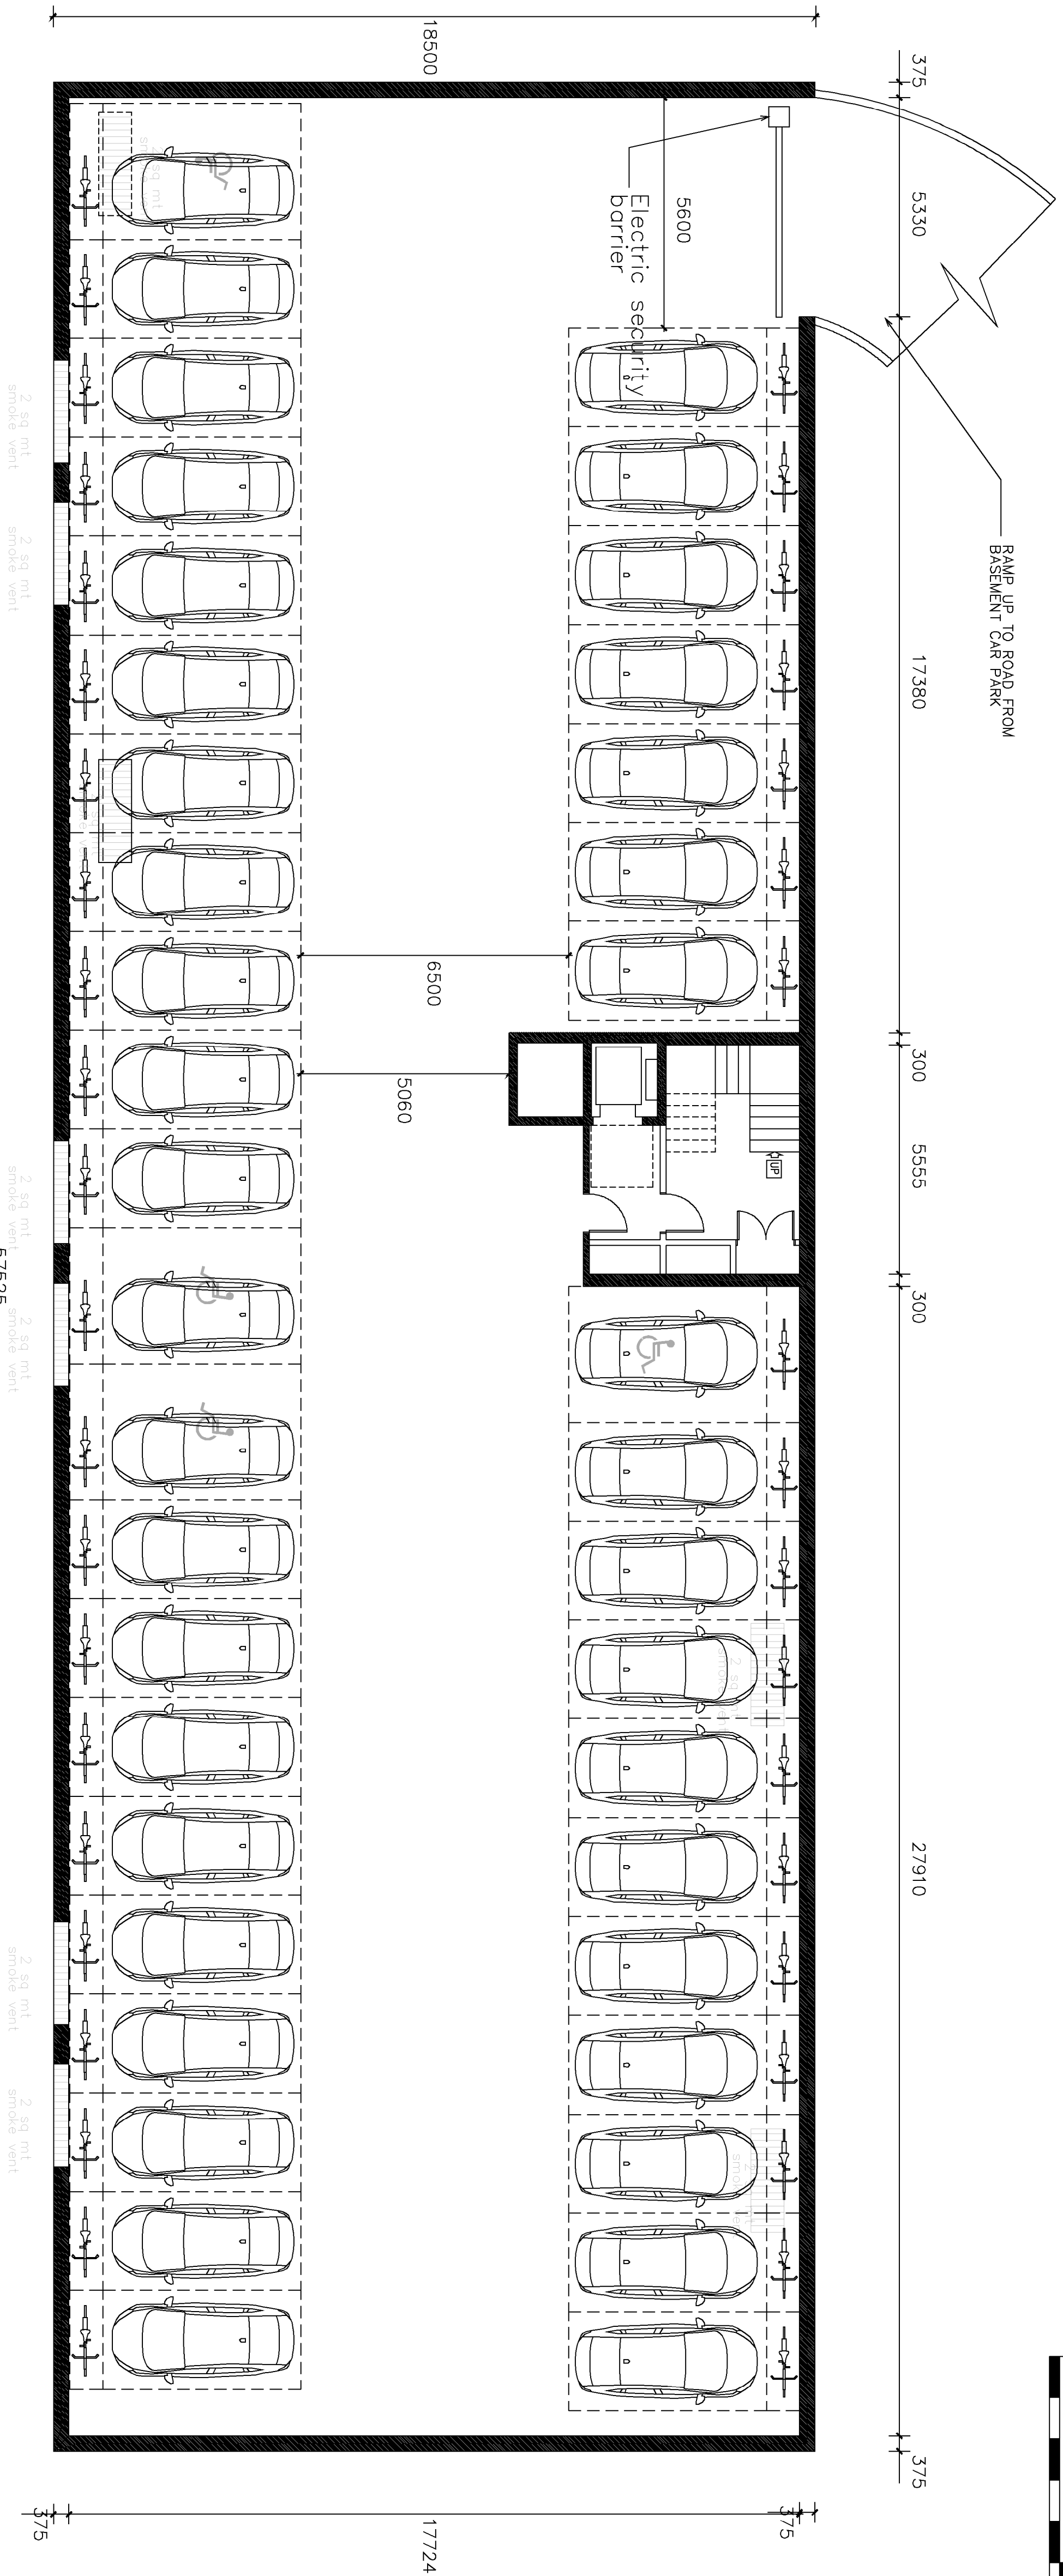

APPROVED BASEMENT PLAN (Original Approval 12768-APP-2016-1580)
36No. Parking Spaces & 4No. Accessible spaces.



AS BUILT BASEMENT PLAN
33No. Parking Spaces & 5No. Accessible spaces.

PROPOSALS			
TOTAL COVER		DATE	
FORMER WEST DRAYTON POLICE STATION		26-03-21	
CONSTABULARY CLOSE WEST DRAYTON LONDON, UB7 7GE		DATE	
CLIENT		DRAWN	
KEARNS PREMIER HOMES		DATE	
TOTAL		DATE	
1-200 A1 SG JAN 21		DATE	
DRAWING TITLE		DATE	
APPROVED AND AS BUILT BASEMENT PLAN & PARKING LAYOUT		DATE	
DRAWING NUMBER		DATE	
AAL-20-235-P03		DATE	
A		DATE	
AMASIA ARCHITECTS LTD		DATE	
FORMER WEST DRAYTON POLICE STATION		DATE	
CONSTABULARY CLOSE WEST DRAYTON LONDON, UB7 7GE		DATE	
CLIENT		DATE	
KEARNS PREMIER HOMES		DATE	
TOTAL		DATE	
1-200 A1 SG JAN 21		DATE	
DRAWING TITLE		DATE	
APPROVED AND AS BUILT BASEMENT PLAN & PARKING LAYOUT		DATE	
DRAWING NUMBER		DATE	
AAL-20-235-P03		DATE	