



As Built Elevation




As Built Elevation

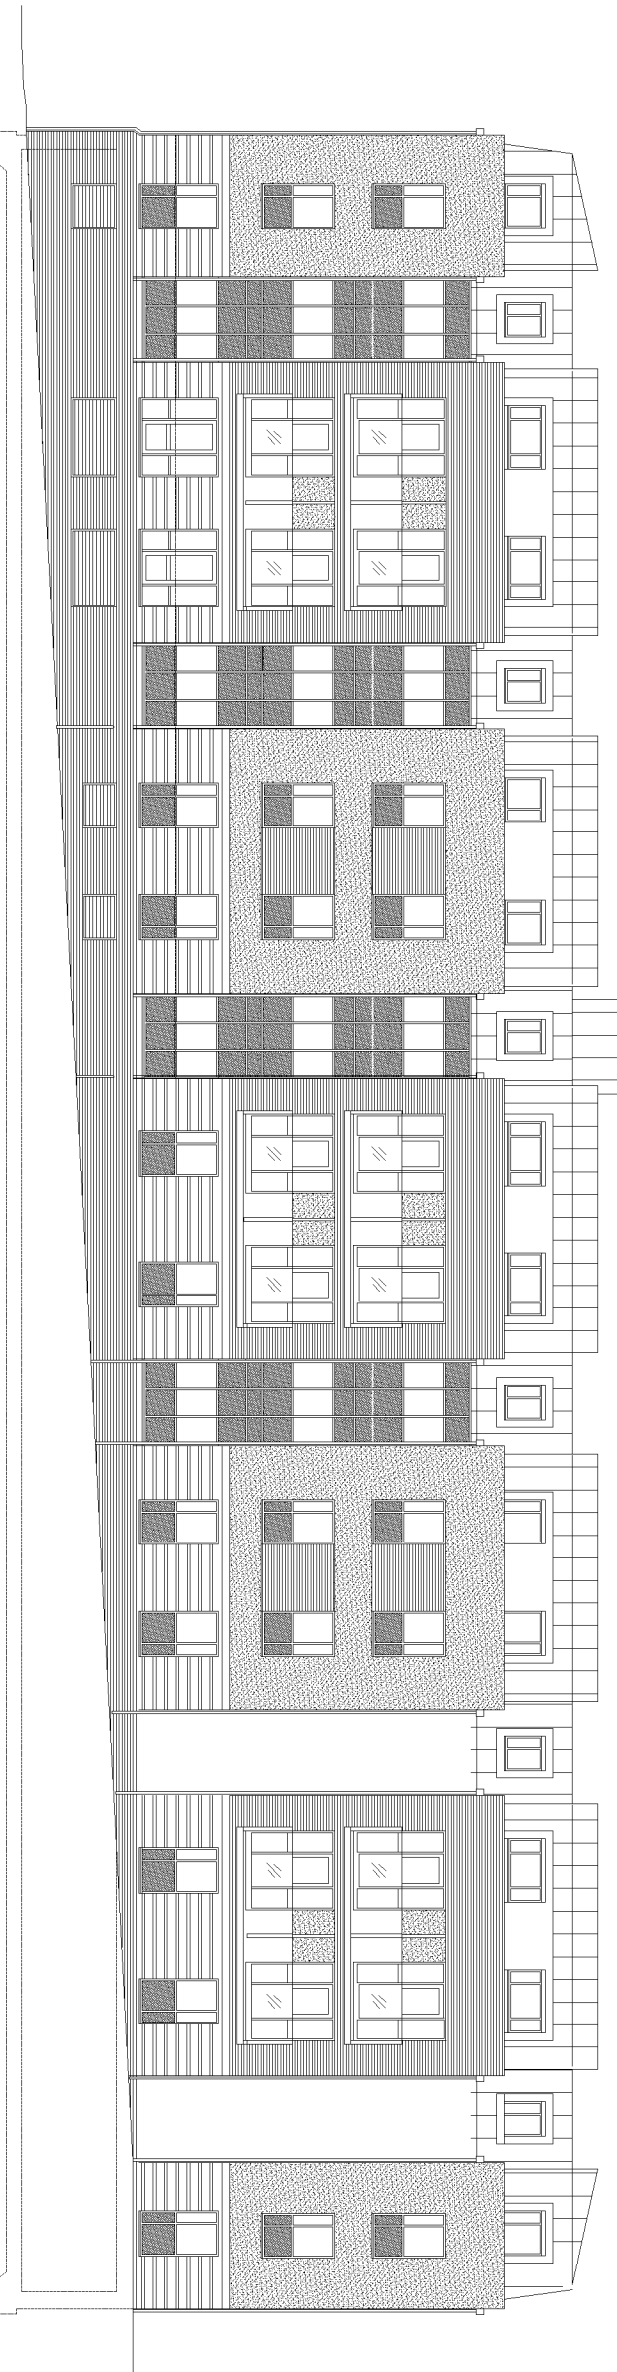


As Built Elevation

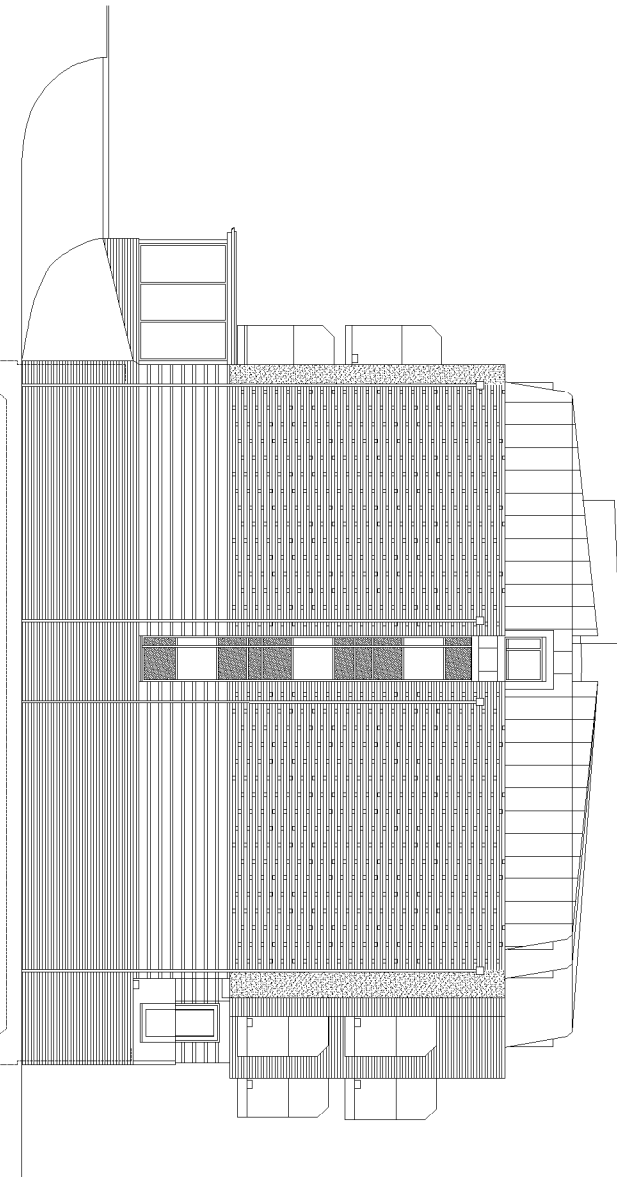


AS BUILT BASEMENT PLAN

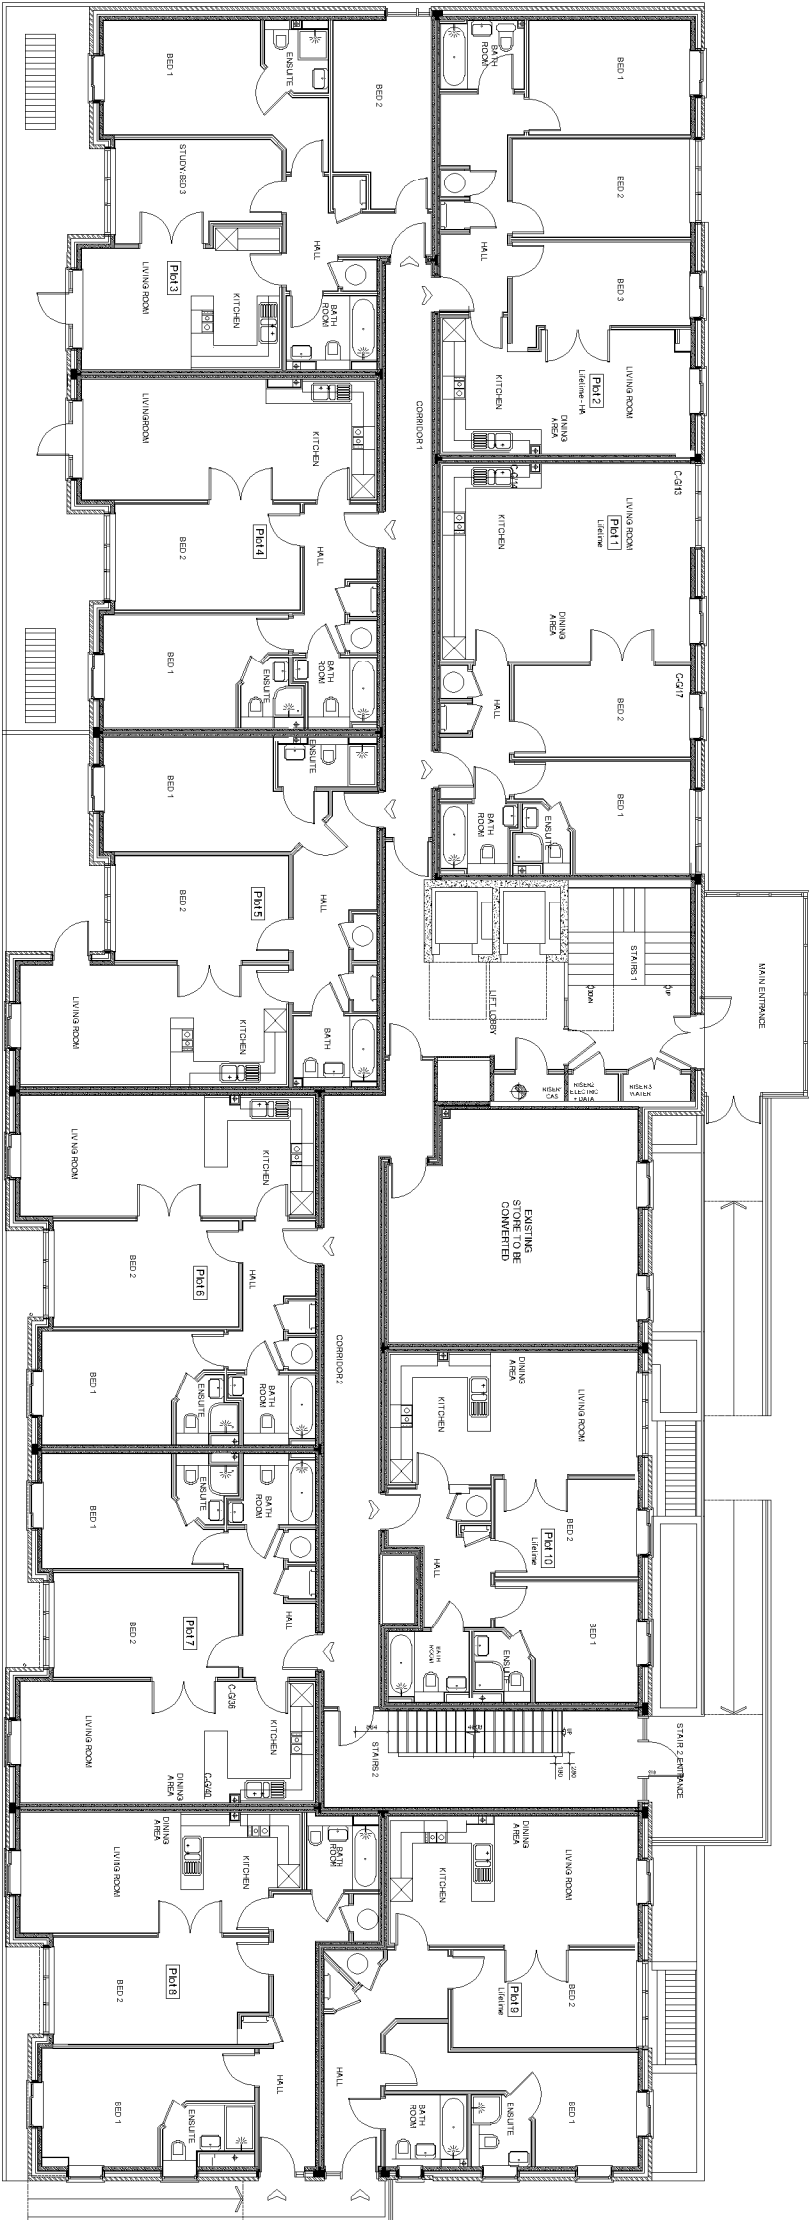


EXISTING GROUND FLOOR PLAN

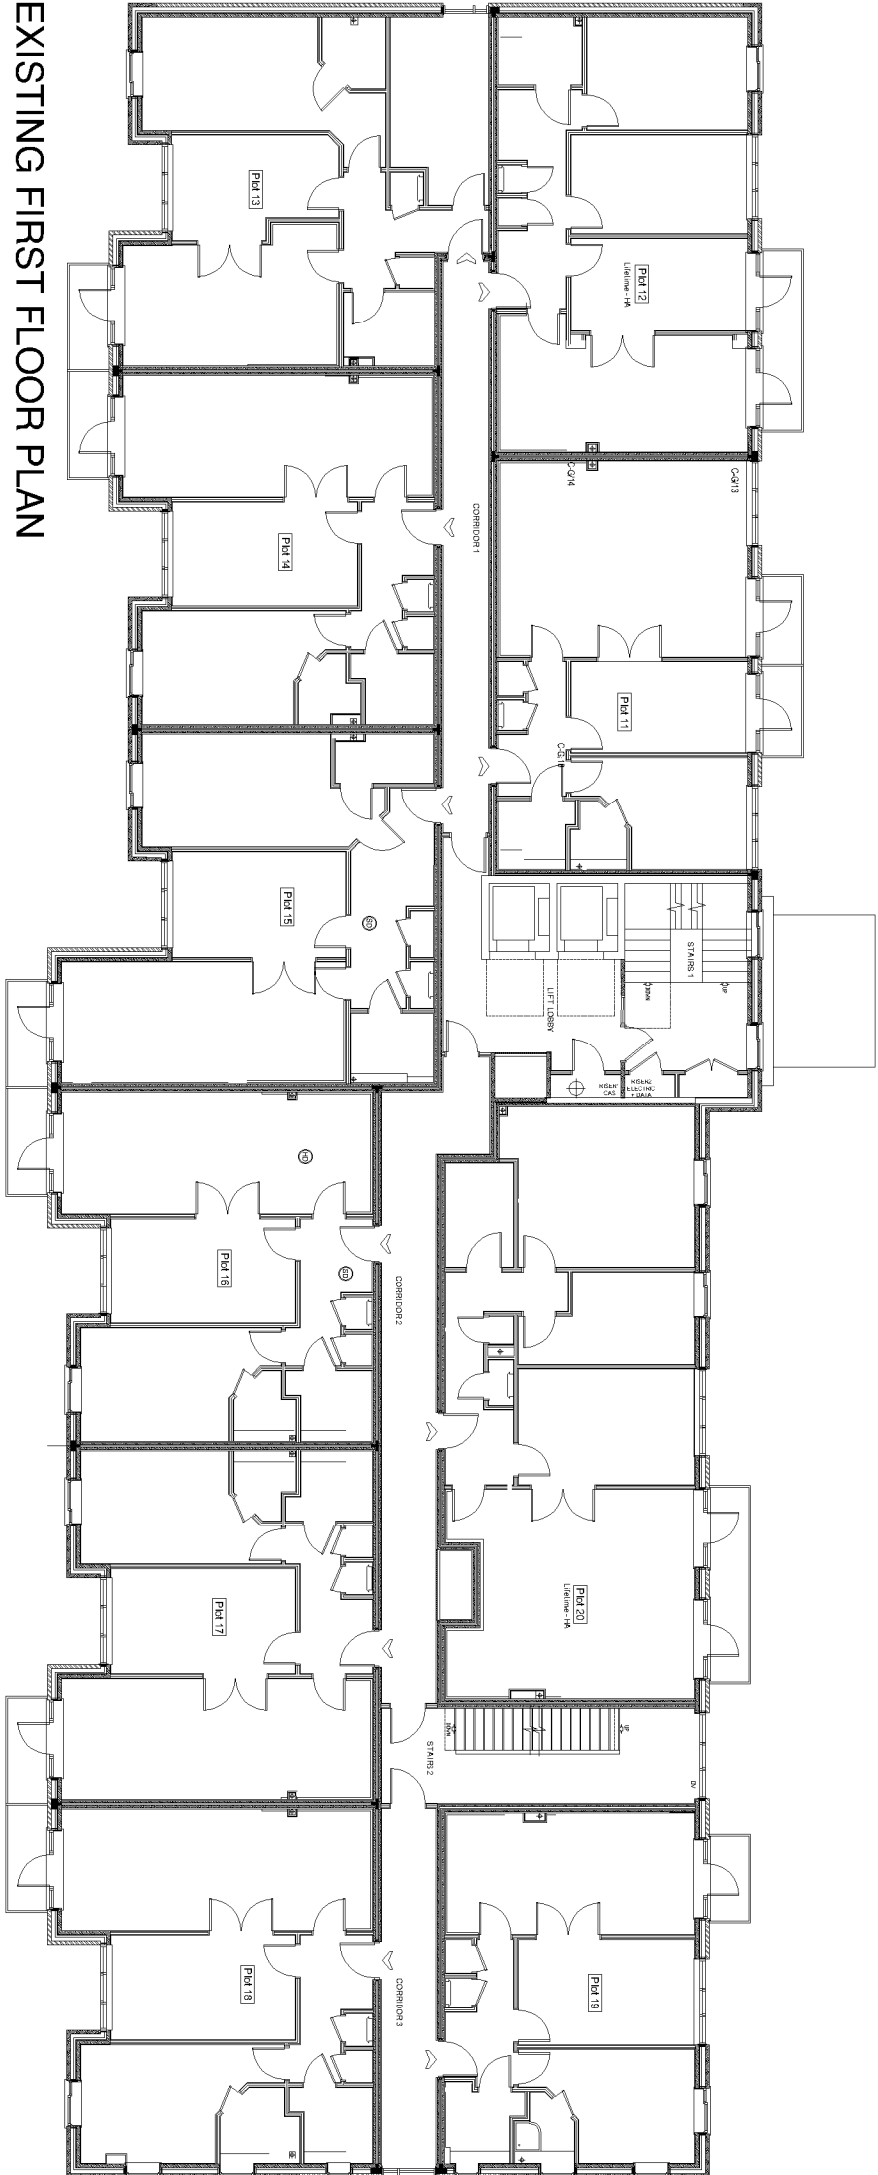

EXISTING FIRST FLOOR PLAN

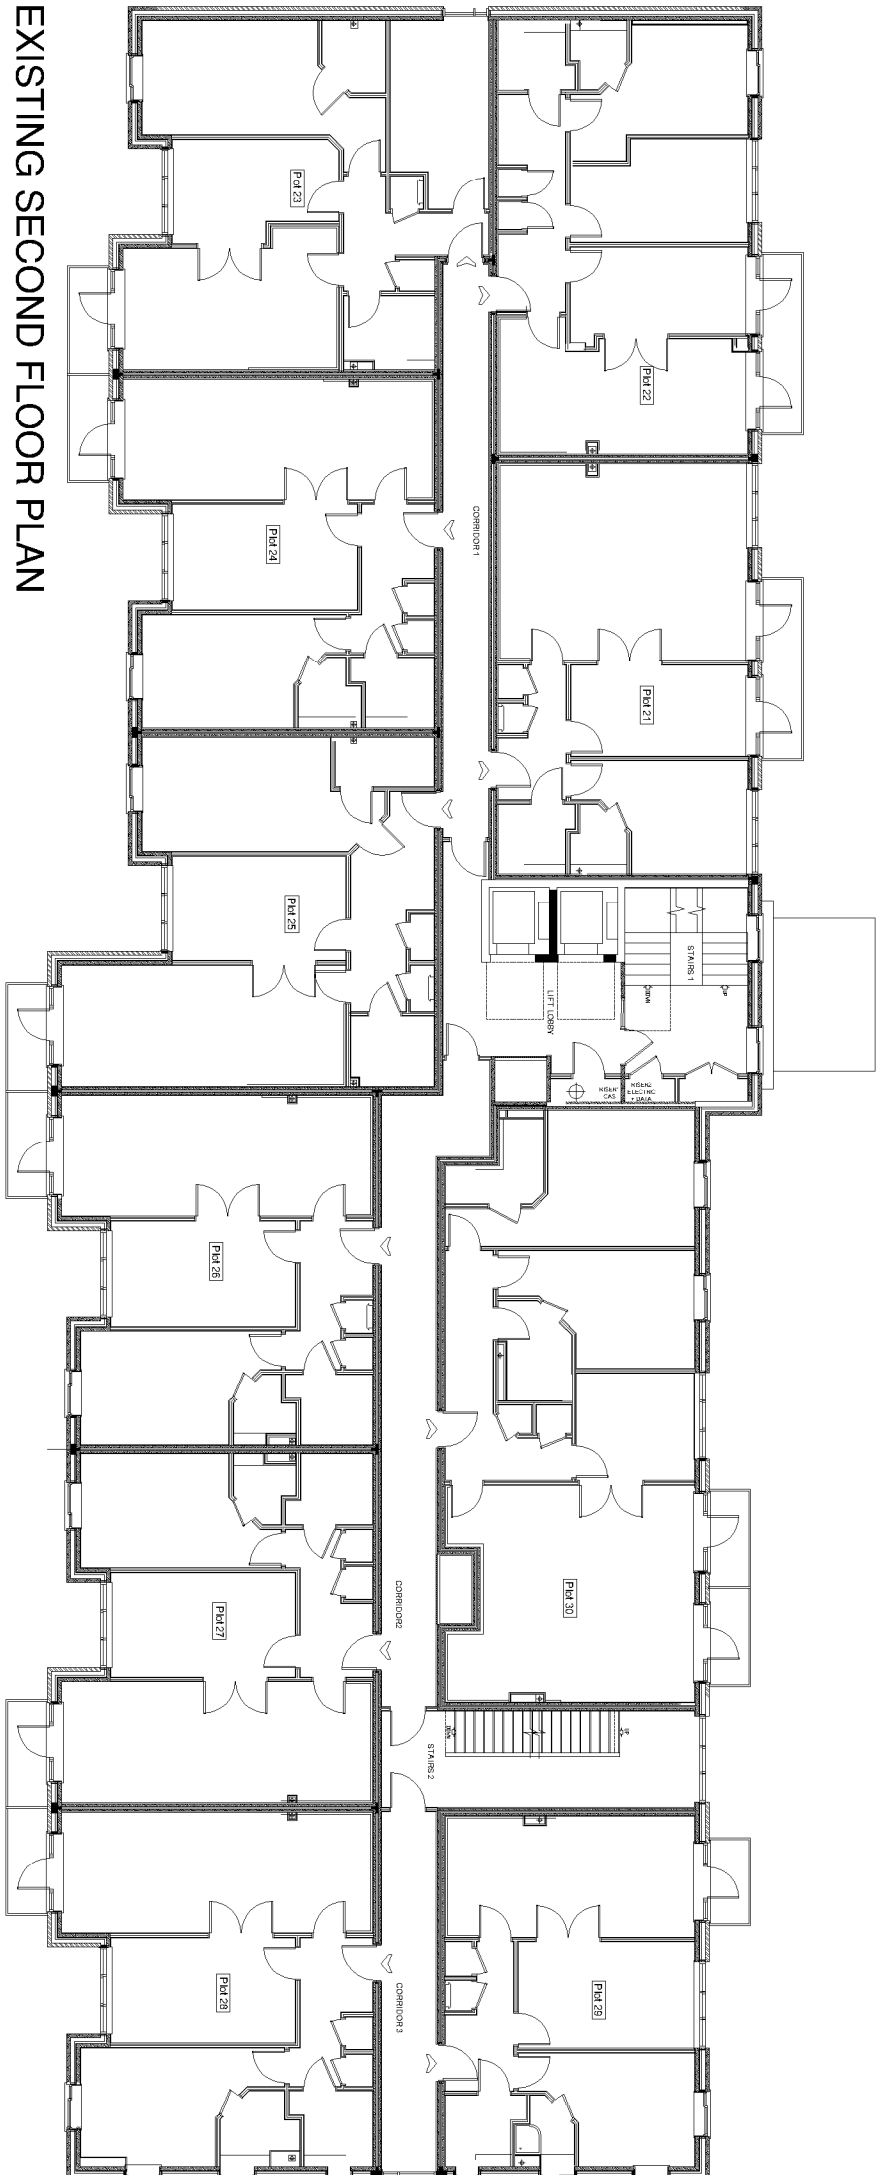

EXISTING SECOND FLOOR PLAN

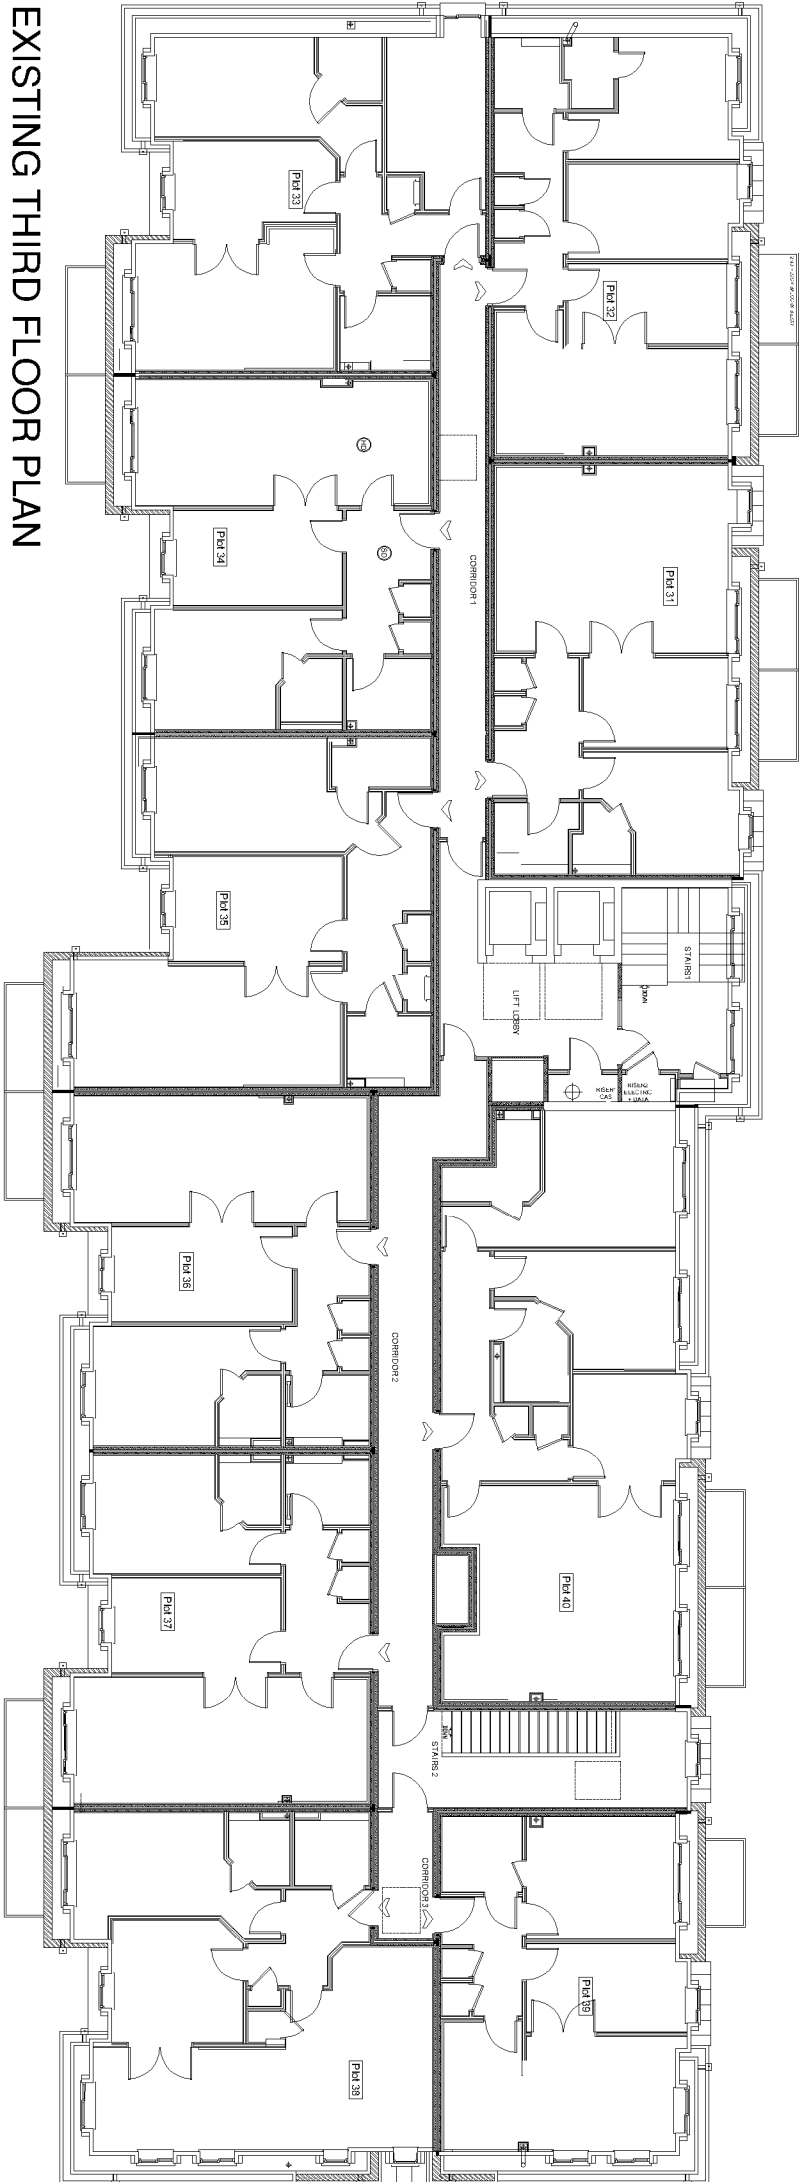

EXISTING THIRD FLOOR PLAN

NOTE

THIS DRAWING IS THE COPYRIGHT OF AMASIA ARCHITECTS LTD AND MAY NOT BE COPIED, ALTERED OR REPRODUCED IN ANY FORM, OR PASSED TO A THIRD PARTY WITHOUT THE WRITTEN CONSENT OF AMASIA ARCHITECTS LTD. DIMENSIONS SHOULD BE CHECKED AND VERIFIED ON SITE AND ANY DISCREPANCIES SHOULD BE REPORTED TO THE ARCHITECT. USE FIGURED DIMENSIONS ONLY.
IF IN DOUBT ASK FOR CONFIRMATION.

REV	DESCRIPTION	DRAWN	DATE
REVISIONS			

PROPOSALS
TYPE ADDRESS
CONSTABULARY CLOSE
WEST DRAYTON
GREATER LONDON
UB7 7GE

CLIENT
KEARNS PREMIER HOMES

SCALE | SHEET SIZE | DRAWN | DATE
1:200 | A1 | SG | JULY 22
DRAWING TITLE
EXISTING PLANS & ELEVATIONS

