

X01

- Main Residential Entrance Door**
- Access: residents, visitors, management, postman, fire brigade
- Fob & video entry, push button for exit
- Locking to suit security rating
- Glass to suit security rating

X02

- Secondary Residential Entrance Door (Rear Access)**
- Access: residents, visitors, management, fire escape
- Fob & audio entry, push button for exit
- Locking to suit security rating
- Glass to suit security rating

X03

- Refuse & Cycle Store Door**
- Access: residents, management, fire brigade, fire escape
- Fob door entry, push button for exit
- Locking mechanism to suit security rating

X05

- Private Terrace Door (Ground Floor)**
- Access: residents of individual units (from inside only)
- Cylinder operated multi-point lock. Lever & key internally, blank externally
- Lockable restricted opening to 100mm for night cooling
- Glass to security rating
- Friction stay

X06

- Upper Floor Balcony / Terrace Door**
- Access: residents of individual units (from inside only)
- Cylinder operated multi-point lock. Lever & key internally, lever only externally
- Friction stay

X09

- Opening Windows (Upper Floors)**
- Cylinder-operated lock

X10

- Opening Windows (Ground Floor)**
- Cylinder-operated lock
- Lockable restricted opening to 100mm for night cooling
- Glass to security rating

X11

- Roof Access Hatch**
- Access: management (trained / qualified personnel only)
- Cylinder-operated lock inside and out
- Retractable zip ladder with locking ceiling hatch
- Retractable handrail and guard on roof

X14

- External Gate to Side**
- Access: Tenants/visitors of storage/commercial unit, management, fire brigade
- Fob entry, push button for exit
- Magnetic locking mechanism

X15

- Commercial Store Door**
- Access: Commercial unit tenant
- High security cylinder lock inside and out
- Full specification to be confirmed

X16

- Roof Access Door**
- Access: Management, fire brigade
- Euro cylinder lock

A01

- Apartment Entry Door**
- Access: residents of individual units
- TS007 3 Star rated Cylinder-operated multi-point lock
- Thumbturn internally, key externally
- Door viewer
- No letterbox

C01

- Main Communal Door**
- Access: residents, visitors, management, postman, fire brigade, fire escape
- Fob & audio intercom door entry, push button for exit
- Magnetic locking mechanism

C02


- Secondary Communal Door (Core / Fire Stair)**
- Access: residents, management, fire brigade, fire escape
- Fob door entry, push button for exit
- Magnetic locking mechanism

C03

- Communal Ancillary / Plant Door**
- Access: management, fire brigade
- Euro cylinder lock

LIFTS GENERALLY


- Access: residents, visitors, management, firefighting access
- Fob & Audio intercom entry outside lift door at ground floor with selective landing control
- Without fob, only onward travel to ground possible

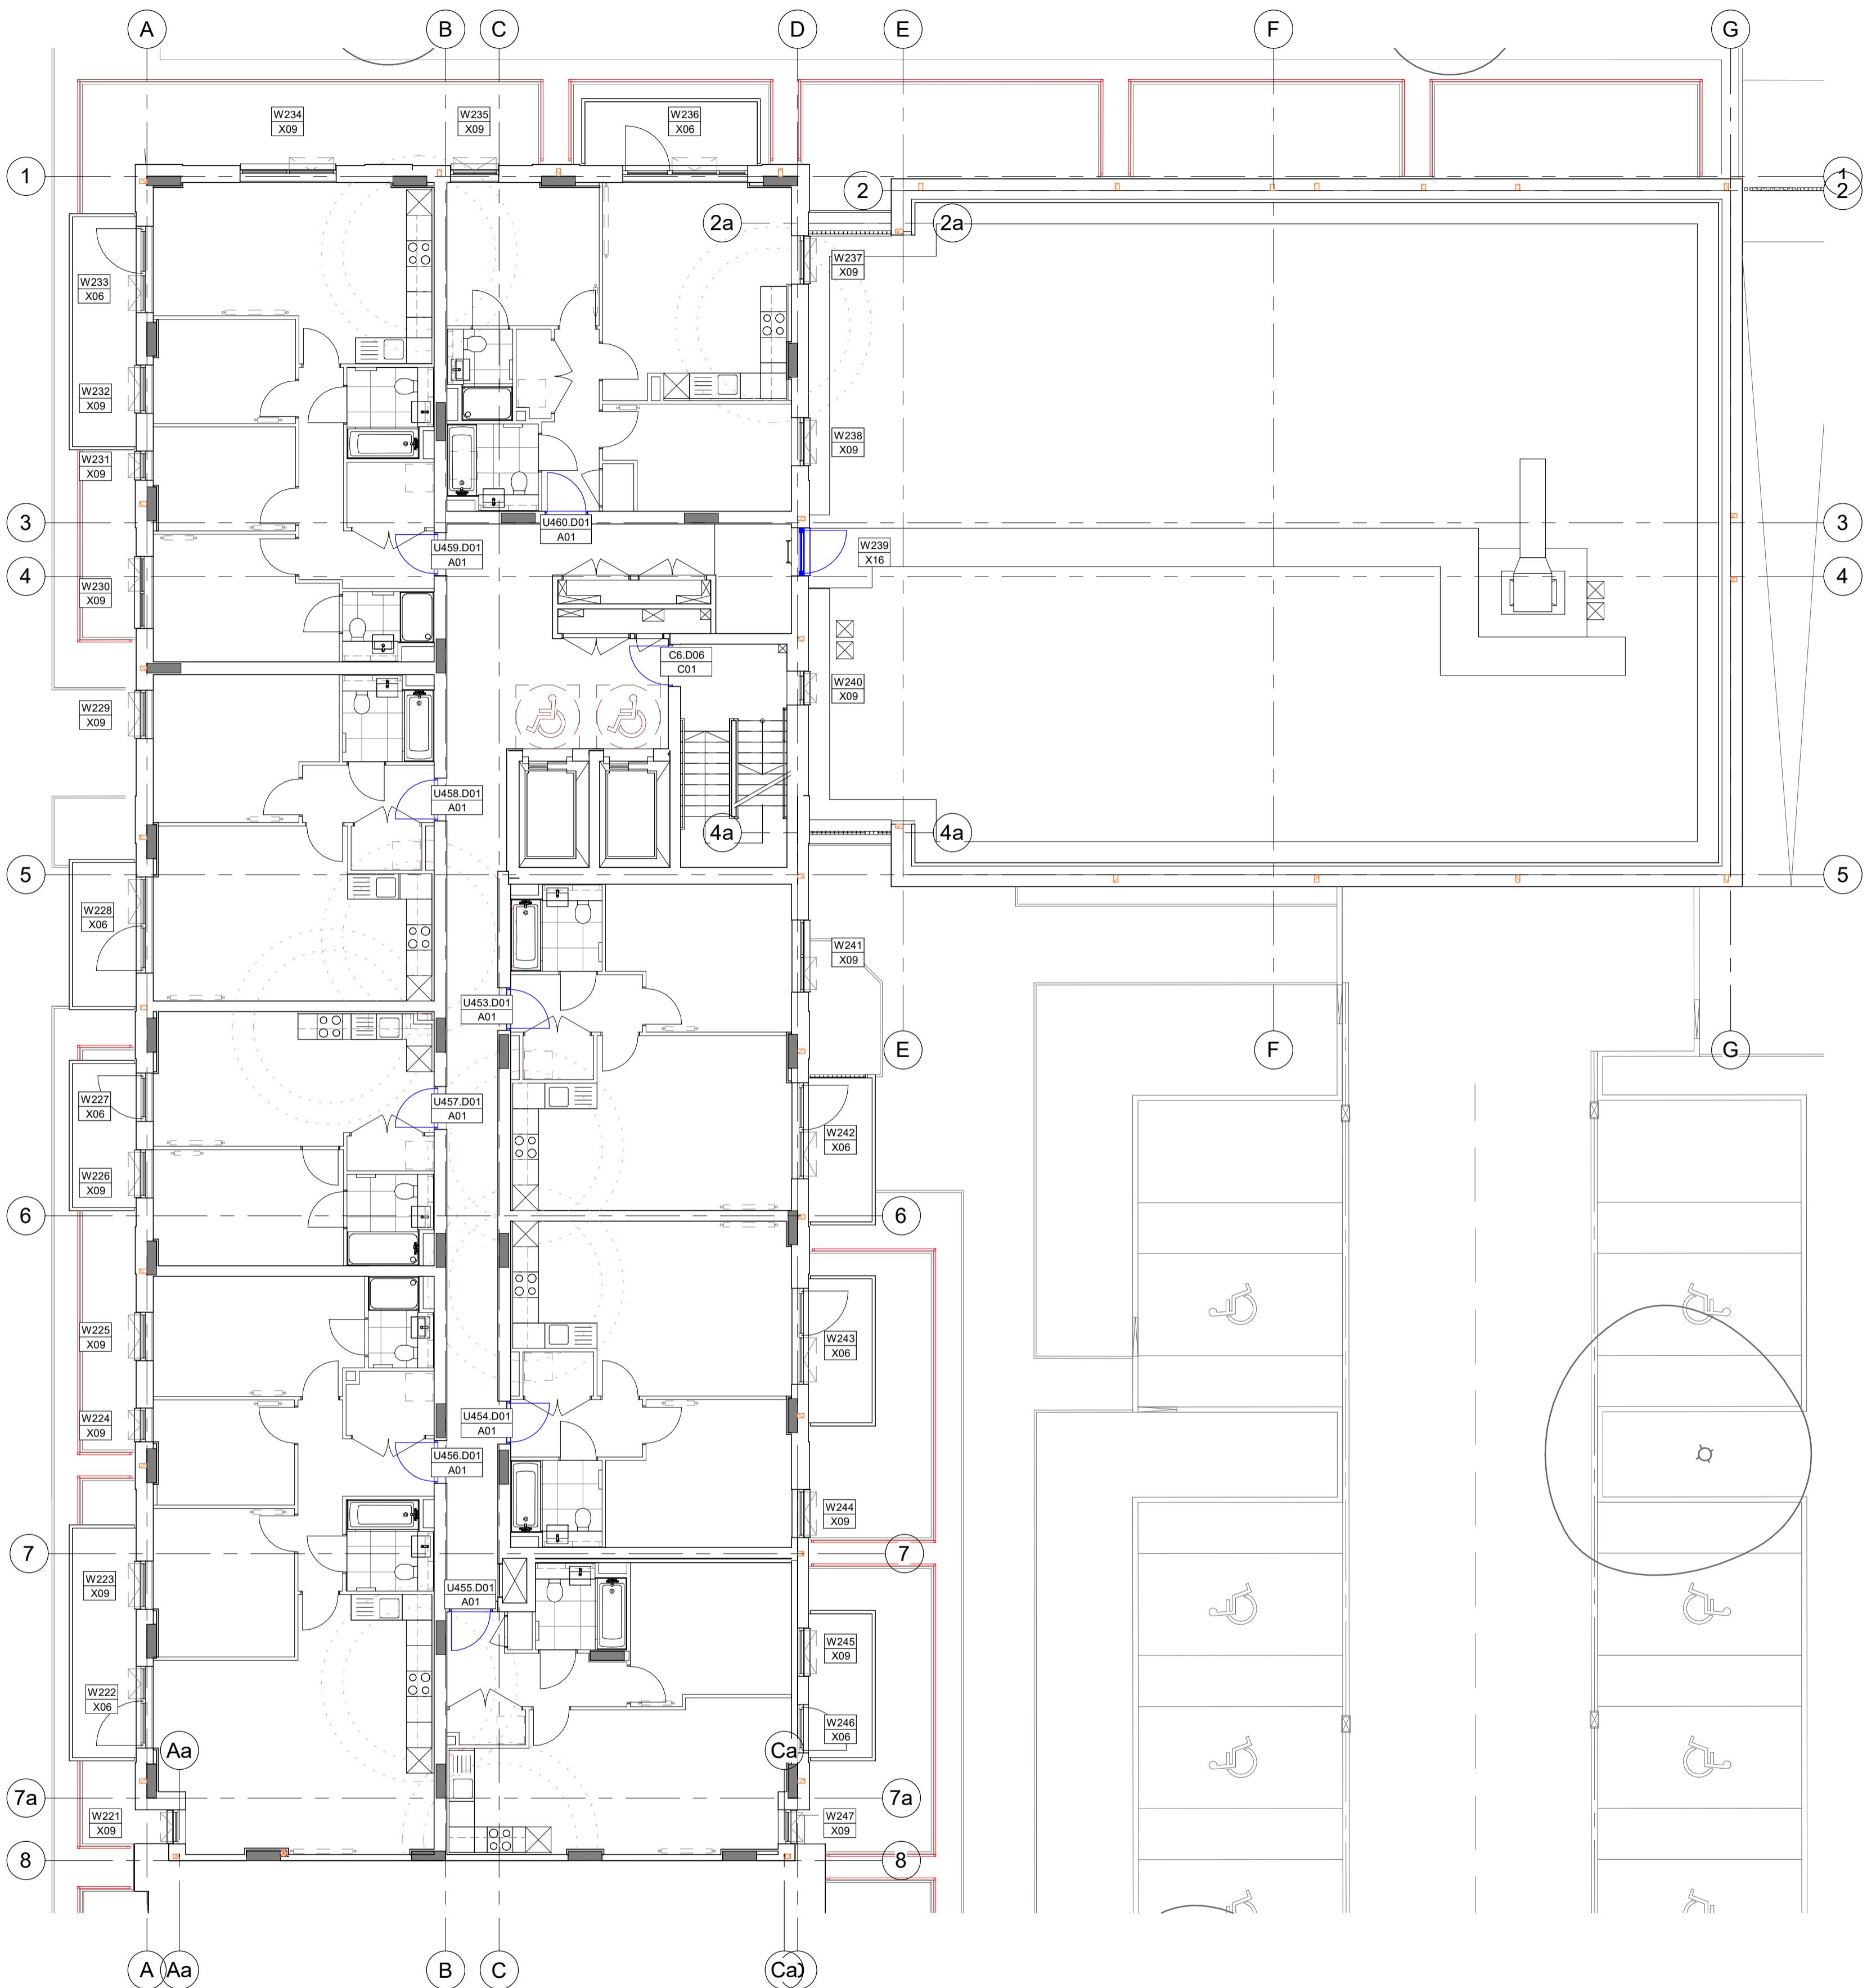

TO BE READ IN CONJUNCTION WITH:
 FNF-A-F3-dMFk-DR-02-100 - Site Plan - Ground Floor
 B875 BRIEFING NOTE DN-004, Access Control

date rev revisions
 26.09.22 C1 For Construction
 09.06.23 C2 Record Drawings

keyplan

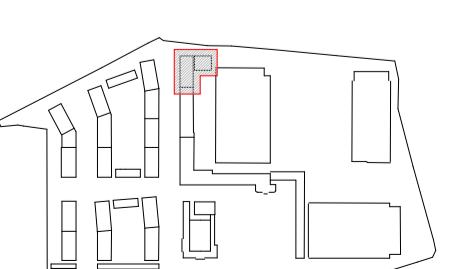

notes

DMFK Architects Ltd take no responsibility for dimensions obtained by scaling from this drawing. If no dimension is shown the recipient must ascertain the dimension specifically from the architect or by site measurement and may not rely on the drawing. Supply of the drawing in digital form is solely for convenience and no reliance may be placed on any data in digital form. All data must be checked against hard copy. This drawing is issued for design intent only and should not be used for construction unless stated.

copyright
 This drawing is the property of dMFk Architects Ltd. No disclosure or copy of it may be made without the written permission of dMFk Architects Ltd.

scale at A1 scale at A3
 1 : 100 1 : 200
 Drawn by Checked by
 LS TC
 project drawing title
 Nestlé Factory, F3
 project no. client drawing no.
 2177 Barratt London FNF-A-F3-dMFk-DR-68-106
 revision