


- X01 Main Residential Entrance Door**
- Access: residents, visitors, management, postman, fire brigade
 - Fob & video entry, push button for exit
 - Locking to suit security rating
 - Glass to suit security rating
- X02 Secondary Residential Entrance Door (Rear Access)**
- Access: residents, visitors, management, fire escape
 - Fob & audio entry, push button for exit
 - Locking to suit security rating
 - Glass to suit security rating
- X03 Refuse & Cycle Store Door**
- Access: residents, management, fire brigade, fire escape
 - Fob door entry, push button for exit
 - Locking mechanism to suit security rating
- X05 Private Terrace Door (Ground Floor)**
- Access: residents of individual units (from inside only)
 - Cylinder operated multi-point lock. Lever & key internally, blank externally
 - Lockable restricted opening to 100mm for night cooling
 - Glass to security rating
 - Friction stay
- X06 Upper Floor Balcony / Terrace Door**
- Access: residents of individual units (from inside only)
 - Cylinder operated multi-point lock. Lever & key internally, lever only externally
 - Friction stay
- X09 Opening Windows (Upper Floors)**
- Cylinder-operated lock
- X10 Opening Windows (Ground Floor)**
- Cylinder-operated lock
 - Lockable restricted opening to 100mm for night cooling
 - Glass to security rating
- X11 Roof Access Hatch**
- Access: management (trained / qualified personnel only)
 - Cylinder-operated lock inside and out
 - Retractable zip ladder with locking ceiling hatch
 - Retractable handrail and guard on roof
- X14 External Gate to Side**
- Access: Tenants/visitors of storage/commercial unit, management, fire brigade
 - Fob entry, push button for exit
 - Magnetic locking mechanism
- X15 Commercial Store Door**
- Access: Commercial unit tenant
 - High security cylinder lock inside and out
 - Full specification to be confirmed
- X16 Roof Access Door**
- Access: Management, fire brigade
 - Euro cylinder lock
- A01 Apartment Entry Door**
- Access: residents of individual units
 - TS007 3 Star rated Cylinder-operated multi-point lock
 - Thumbturn internally, key externally
 - Door viewer
 - No letterbox
- C01 Main Communal Door**
- Access: residents, visitors, management, postman, fire brigade, fire escape
 - Fob & audio intercom door entry, push button for exit
 - Magnetic locking mechanism
- C02 Secondary Communal Door (Core / Fire Stair)**
- Access: residents, management, fire brigade, fire escape
 - Fob door entry, push button for exit
 - Magnetic locking mechanism
- C03 Communal Ancillary / Plant Door**
- Access: management, fire brigade
 - Euro cylinder lock
- LIFTS GENERALLY**
- Access: residents, visitors, management, firefighting access
 - Fob & Audio intercom entry outside lift door at ground floor with selective landing control
 - Without fob, only ownward travel to ground possible
- CCTV Camera: Dome Type**
- Security Rating: PAS 24:2016**
- Security Rating: LPS 1175/Issue 7 SR2, STS 202 BR2, or LPS 2081/SRB**

TO BE READ IN CONJUNCTION WITH:


FNF-A-F3-dMFK-DR-02-100 - Site Plan - Ground Floor
B875 BRIEFING NOTE DN-004_Access Control

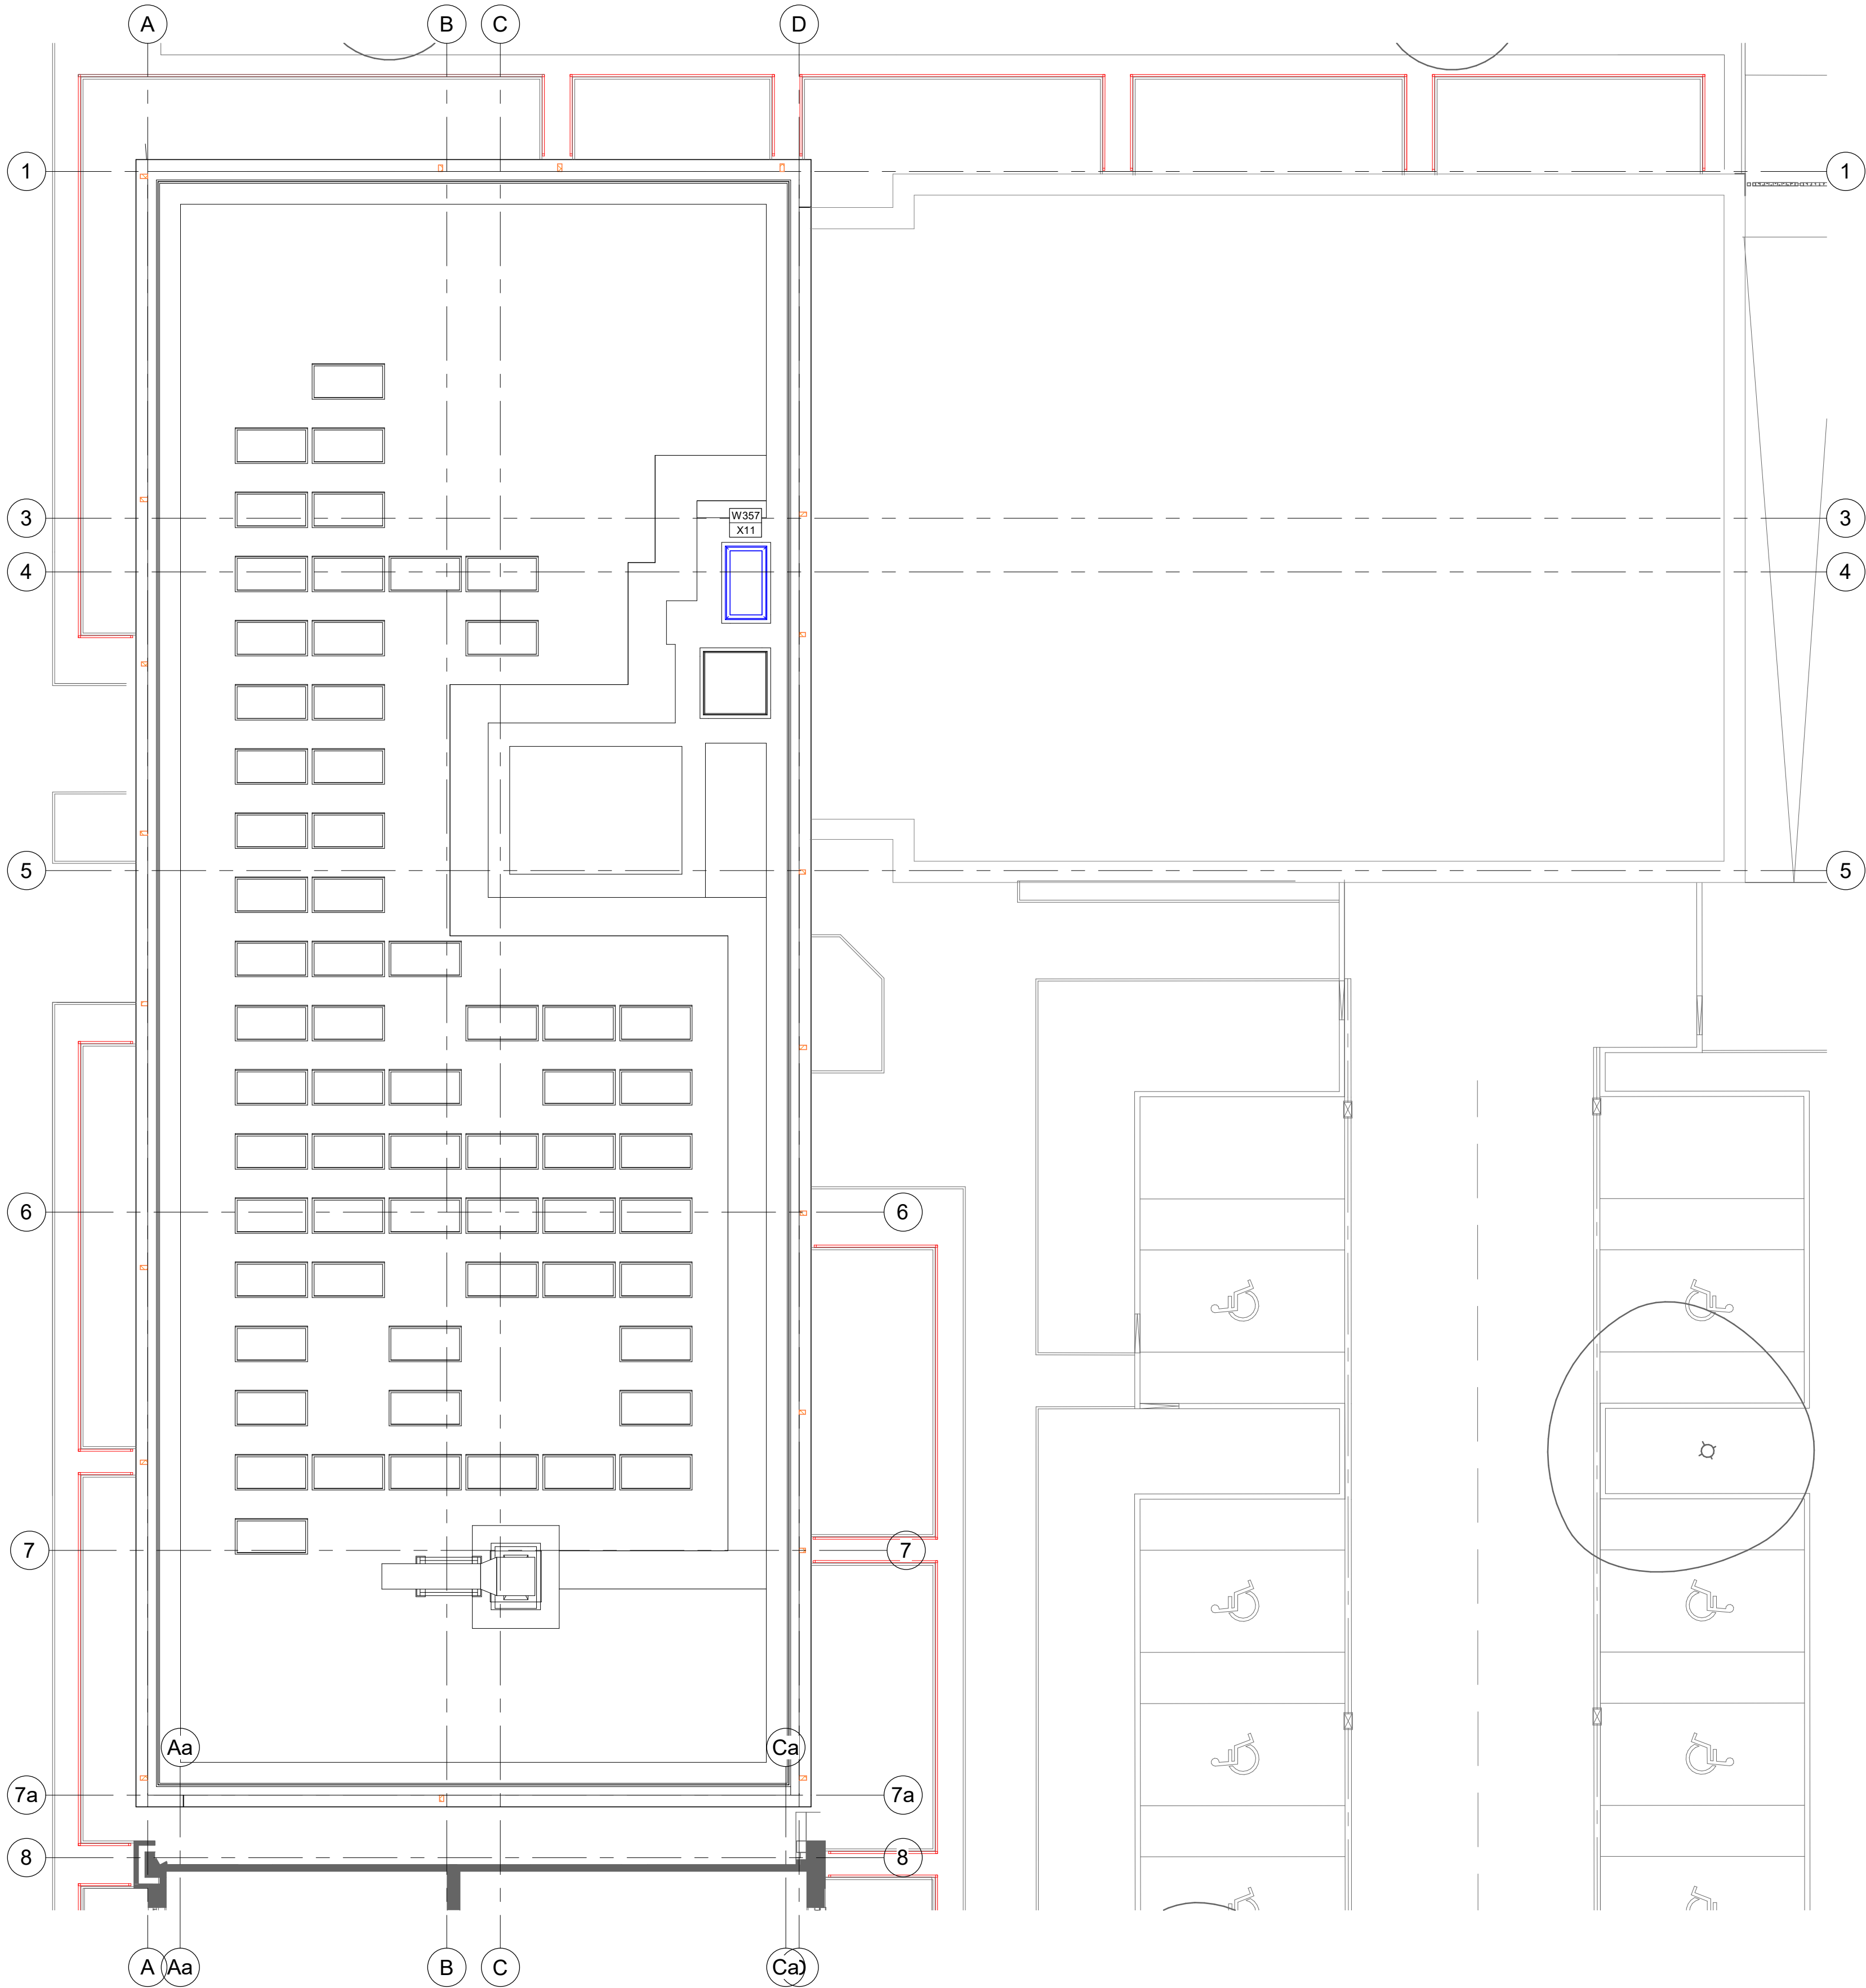

date rev revisions

28.09.22 C1 For Construction
09.08.23 C2 Record Drawings


keyplan

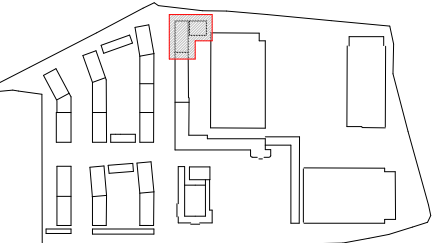

notes

DMFK Architects Ltd take no responsibility for dimensions obtained by scaling from this drawing. If no dimension is shown the recipient must ascertain the dimension specifically from the architect or by site measurement and may not rely on the drawing. Supply of the drawing in digital form is solely for convenience and no reliance may be placed on any data in digital form. All data must be checked against hard copy. This drawing is issued for design intent only and should not be used for construction unless stated.

copyright
This drawing is the property of dMFK Architects Ltd. No disclosure or copy of it may be made without the written permission of dMFK Architects Ltd.

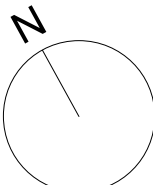

dMFK
DE METZ FORBES KNIGHT ARCHITECTS

the old library 119 chainley gardens london nw6 1aa

t 020 7425 1144

f 020 7425 0884

mail info@dmfk.co.uk

scale at A1

scale at A2

project

drawing title

1 : 100

1 : 200

Nestlé Factory, F3

Access and Security - Roof Plan

Drawn by

Checked by

project no.

client

drawing no.

revision

2177 Barratt London

FNF-A-F3-dMFK-DR-68-111

C2