



① **As Built Second Floor Plan**
Scale: 1:100

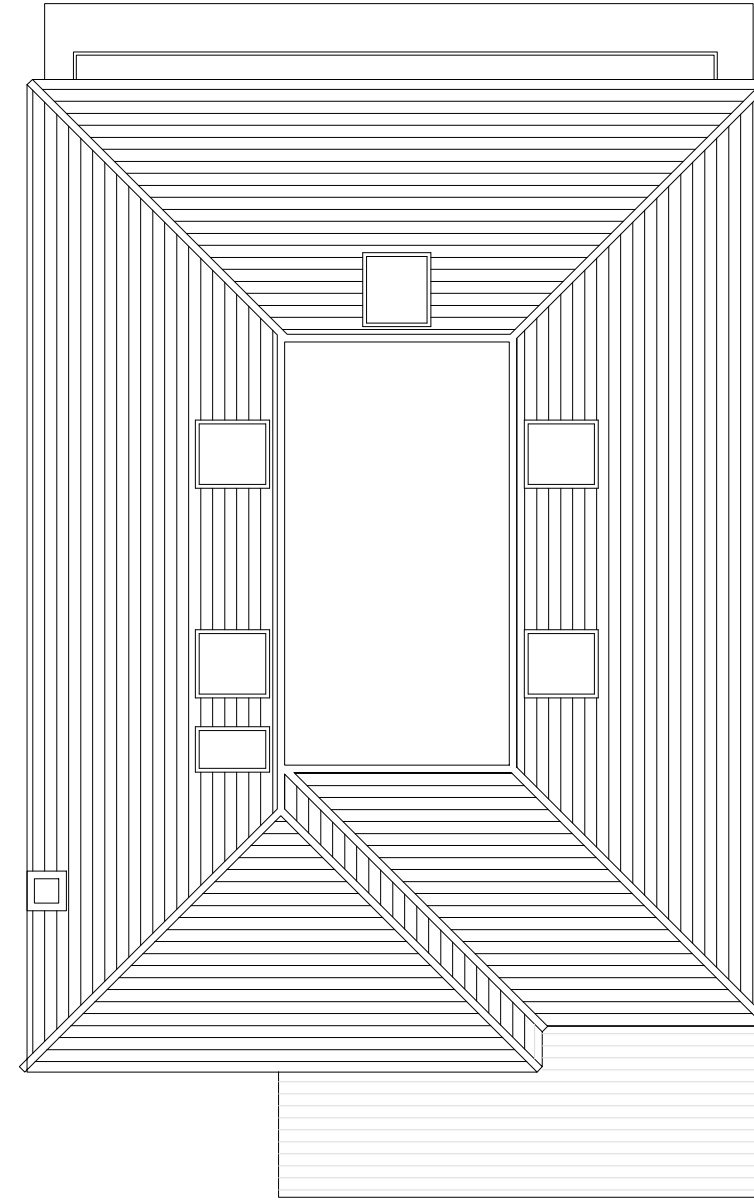

② **As Built Roof Plan**
Scale: 1:100

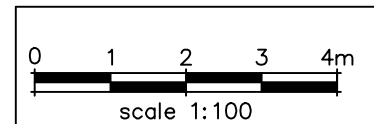

PROJECT:	61 WARREN ROAD, ICKENHAM, UB10 8AD		
CLIENT:	MR PANESAR		
DRAWING:	AS BUILT FLOOR PLANS		
SCALE:	1:100@A3	DRAWN:	AS
DATE:	May 2025	CHECKED:	AS
DRAWING NO:	25007-ZZ-ZZ-DR-T-2001	REV:	C01