



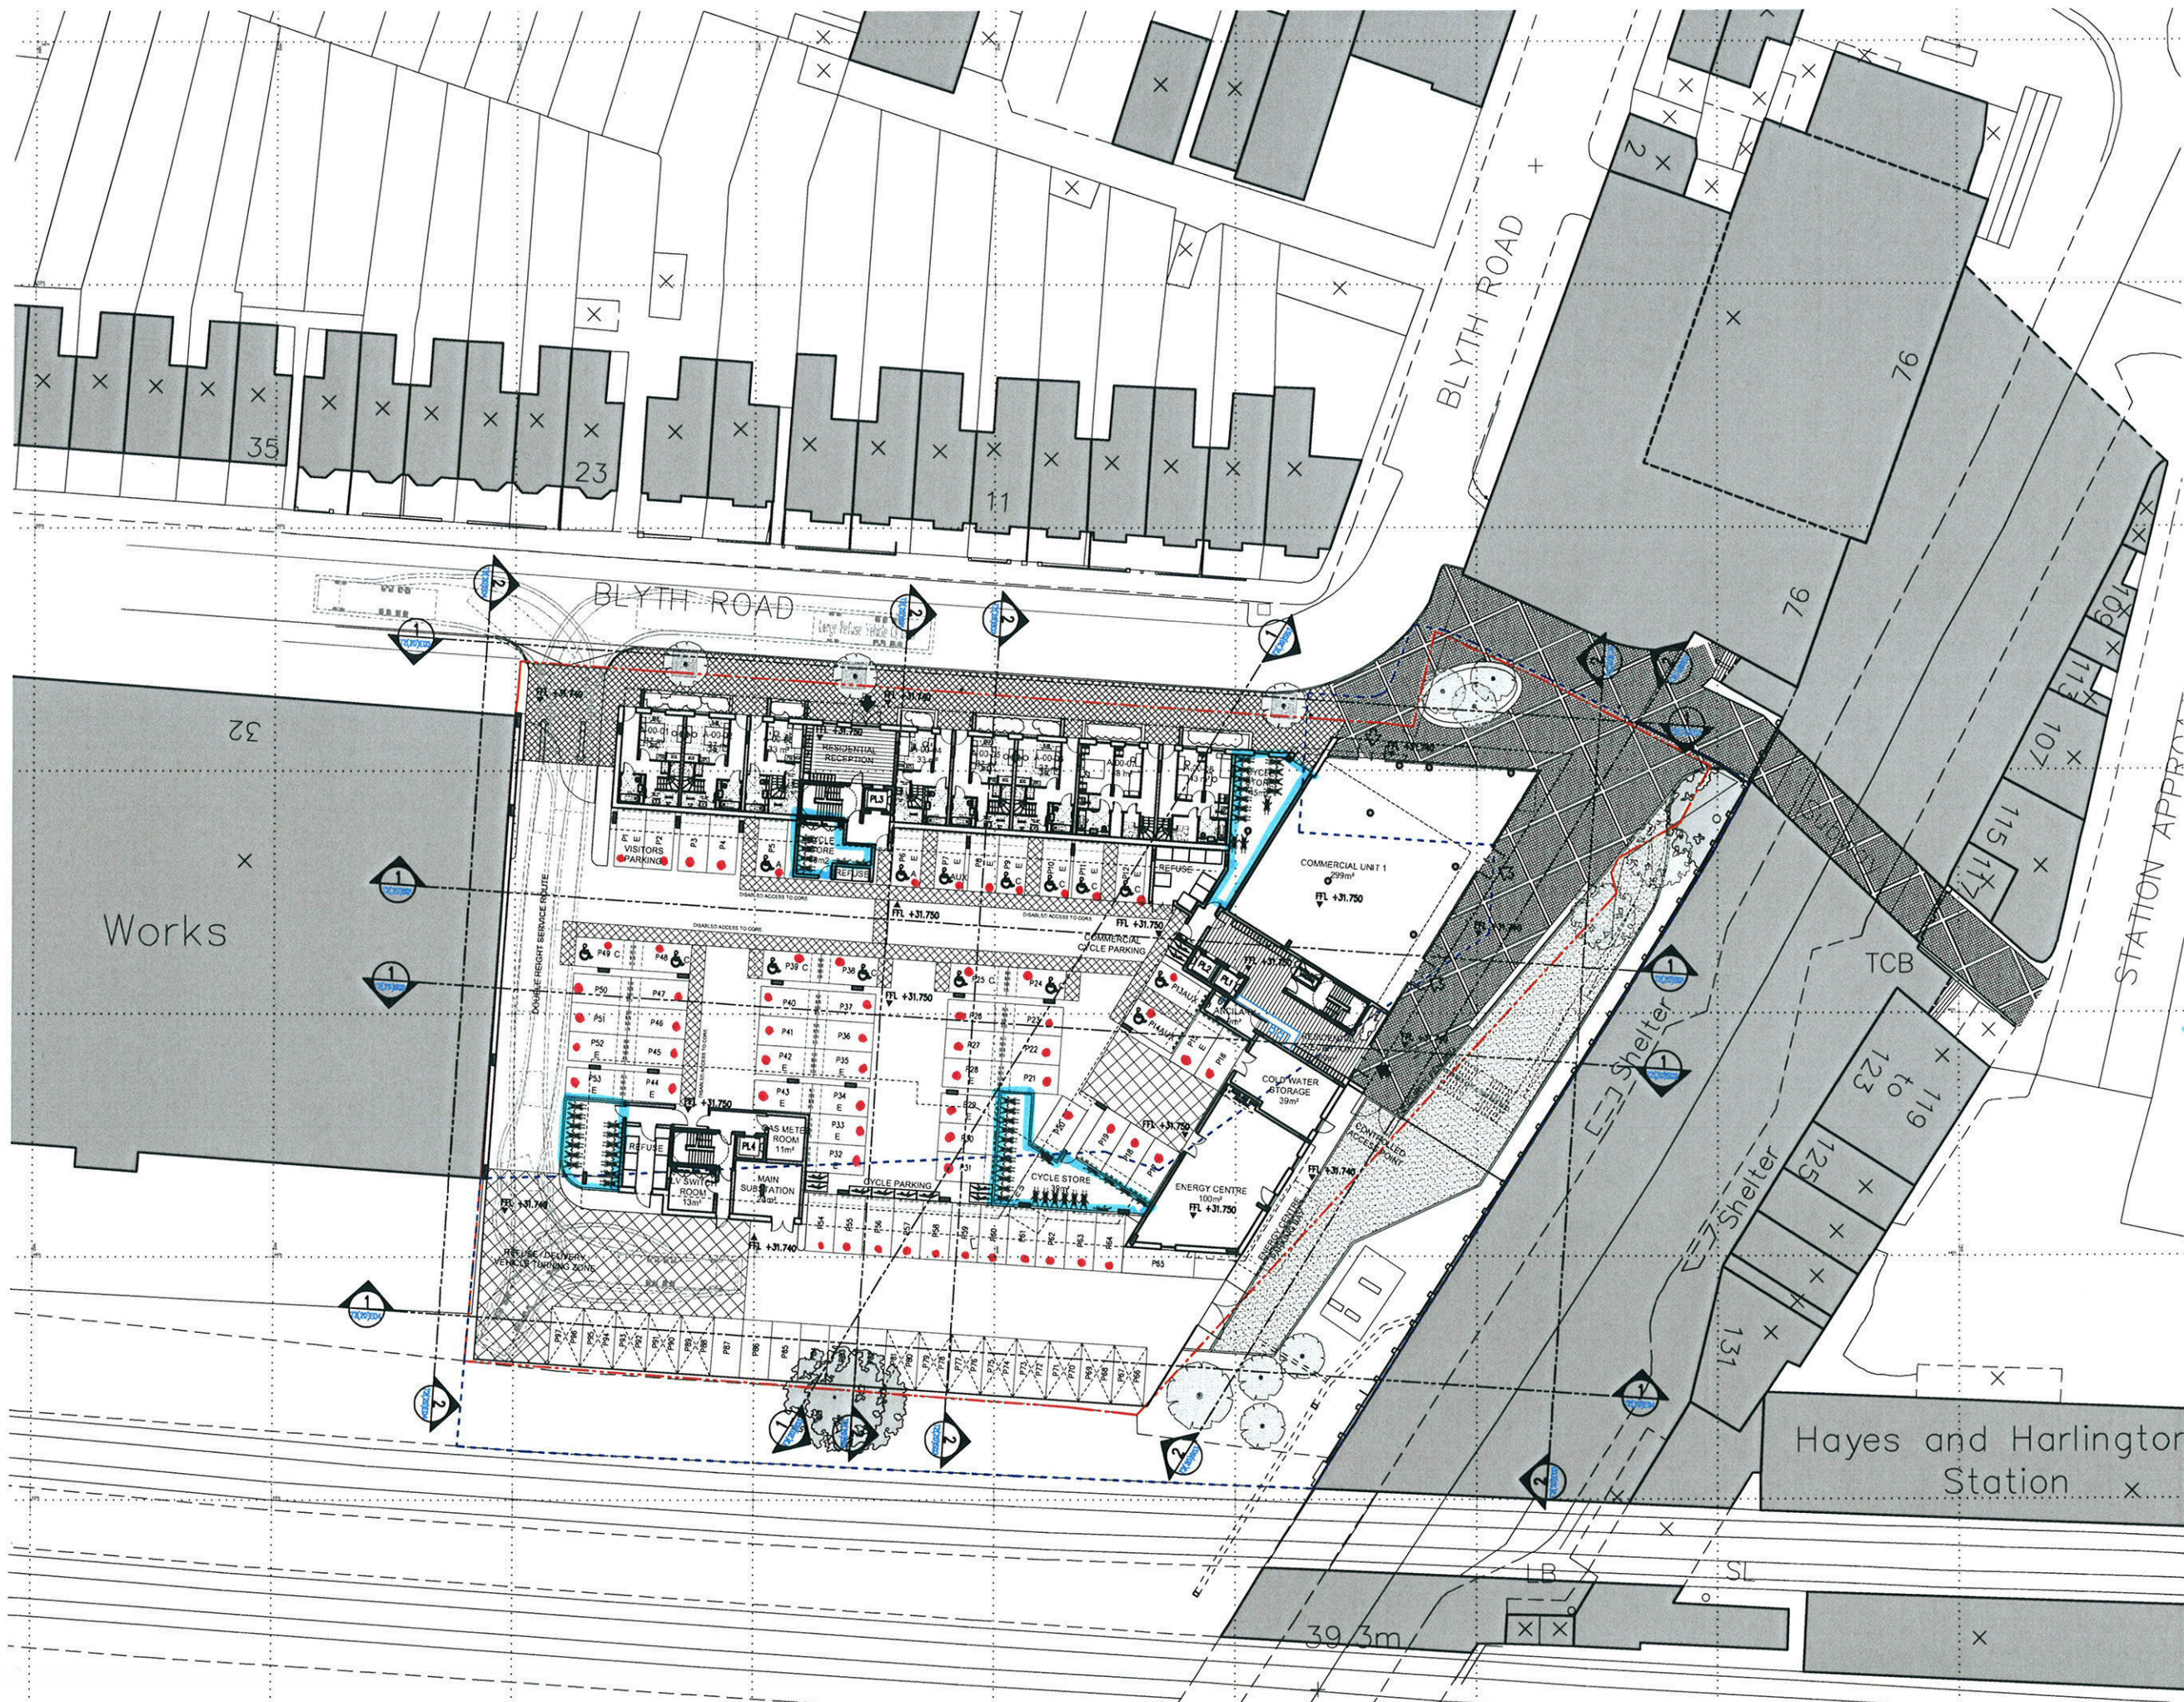

- NOTES
- 1 The Contractor must check and confirm dimensions
 - 2 All discrepancies must be reported and resolved by the Architect before works commence
 - 3 This drawing is not to be scaled
 - 4 All work and materials to be in accordance with current applicable Statutory Legislation and to comply with all relevant Codes of Practice and British Standards.

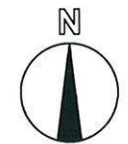

--- APPROXIMATE SITE BOUNDARY
--- NETWORK RAIL SAFEGUARDED AREA

CAR PARK PROVISION

PARKING BAYS	- 82
WHEELCHAIR ACCESSIBLE BAYS	- 15
IN TOTAL	- 97

NUMBER OF CYCLE SPACES

RESIDENTS	-179
COMMERCIAL	- 9
IN TOTAL	-188

- P56 PARKING BAY WITH SOFFIT MOUNTED CYCLE HANGER (1 CYCLE) - 64 SPACES
- P65 DOUBLE PARKING BAY LIFTING PLATFORM - 13x2 SPACES
- P24 E PARKING BAY FOR ELECTRIC VEHICLES - 20 SPACES (20% OF TOTAL NUMBER)
- P66 PARKING BAY WITH FLOOR MOUNTED CYCLE RACK (2 CYCLES) - 98 SPACES
- P67 PARKING BAY WITH FLOOR TO FLOOR MOUNTED CYCLE HANGERS (2 CYCLES STACKING) - 16 SPACES
- P68 CYCLE LOCKER (FRONT ACCESS) - 6 SPACES
- P69 CYCLE LOCKER (SIDE ACCESS) - 4 SPACES

Secure Access Control
Bike Store

P3 REVISED STREET TREE PLANTING	05/09/12
P2 REVISED PLANNING SUBMISSION	17/08/12
P1 REVISED PLANNING SUBMISSION	15/08/12
P PLANNING ISSUE	06/12/11

Client
DOMAINE DEVELOPMENTS Ltd

Project
BLYTH ROAD

Drawing
GROUND FLOOR PLAN

Scale 1:250 (A1)	Date SEP 11	Drawn MB
Drawing No 4710 / T2(20)P00	Revision P3	
CAD Ref No Q:\4710\T2_Series\T2_20\T2_20P00		

This scale is 100mm in length when printed at the size indicated in the title block.