




4 Proposed Front Elevation


Scale 1/1

Remains Unalt

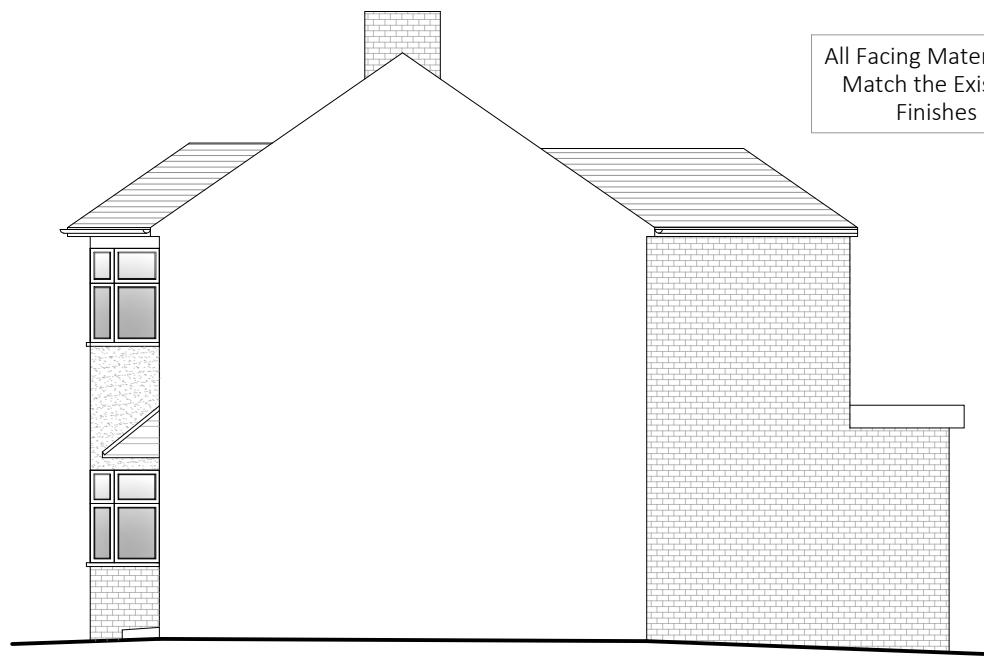

5 Proposed Side Elevation


Scale 1/1

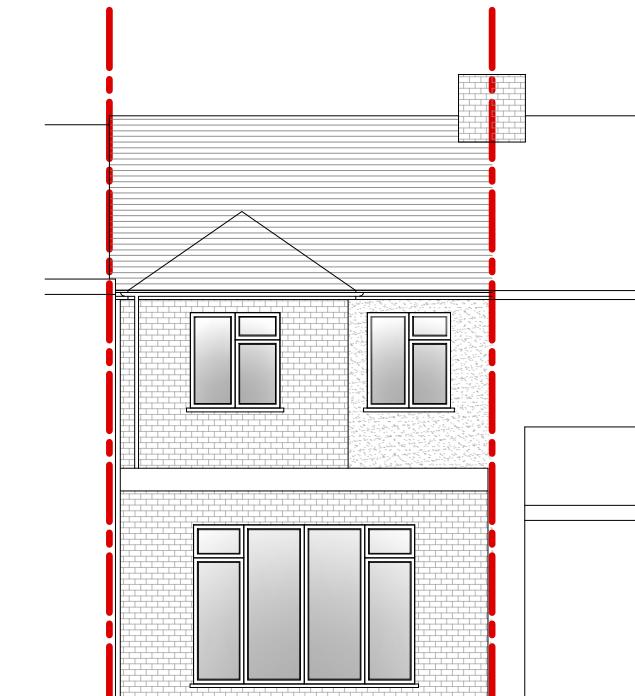

6 Proposed Rear Elevation


Scale 1

All Facing Materials to Match the Existing Finishes

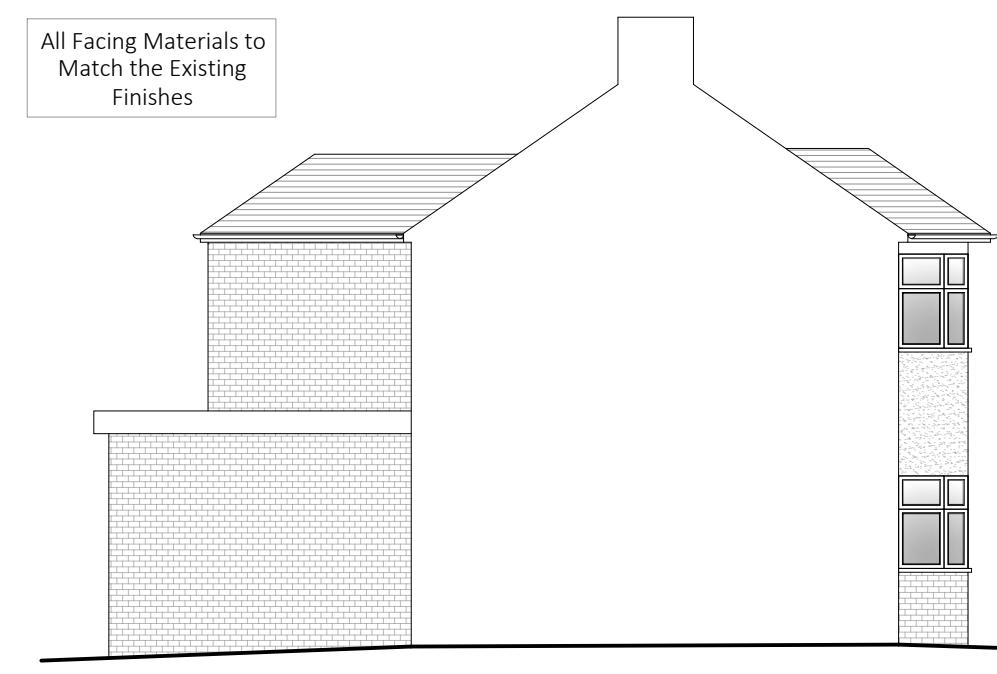

7 Proposed Side Elevation

Scale

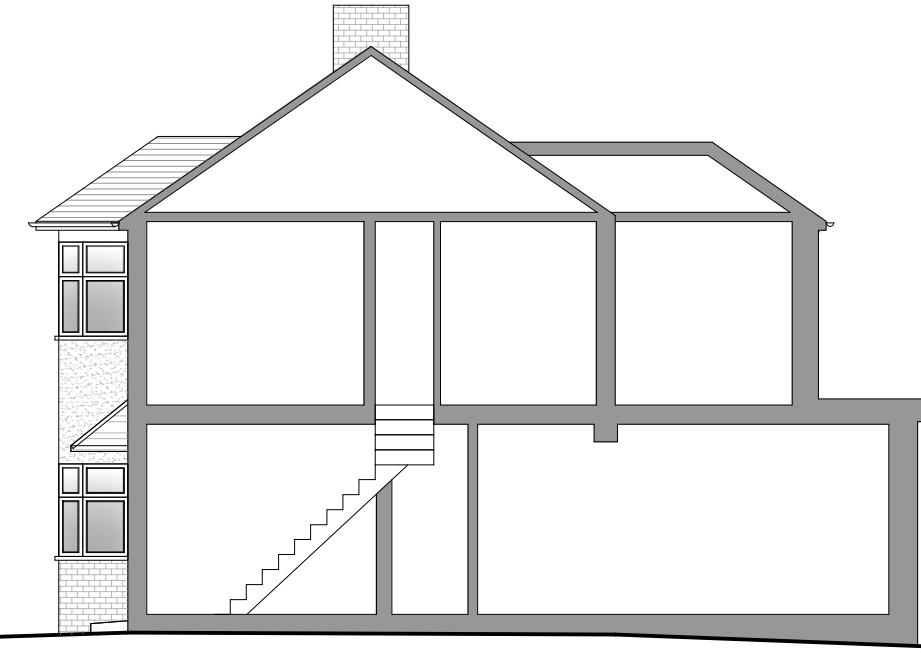

8 Proposed Side Section

Scale 1/100

Legend	Paving	Lawn	Proposed Extension	PARTY WALL ACT 1996 OWNER/S MUST ENSURE ALL PARTY WALL AGREEMENTS ARE IN PLACE BEFORE ANY BUILDING WORKS ARE TO COMMENCE	IMPORTANT GENERAL NOTE The specification is to be read in conjunction with the plans/section details, and other associated Structural details as may be provided. All work is to be carried out by the Local Authority Planning and Building Regulations Approval, and the Codes of Practice and British Standards as necessary. All dimensions, levels, sizes, positions and locations of particulars as indicated on drawings are to be verified by the appointed Contractor on site prior to engaging in works. Any discrepancies must be reported to the Architect/Surveyor/Engineer or responsible person/s immediately. The Contractor is responsible for ensuring compliance with the CDM Regulations, and appropriate Health & Safety on site precautions. The Client/Building Owner must obtain any necessary PARTY WALL AGREEMENTS, prior to engaging in the works on site.	Revision	Date	Description	Page Size	Drawn By	Checked By
Boundary Line					A	31.10.2025	As-Built Drawings	A3	AAP	AP	
Sound Separating Wall			Digital Scan Data					1:100	Drawing Status		