




As Built Front Elevation

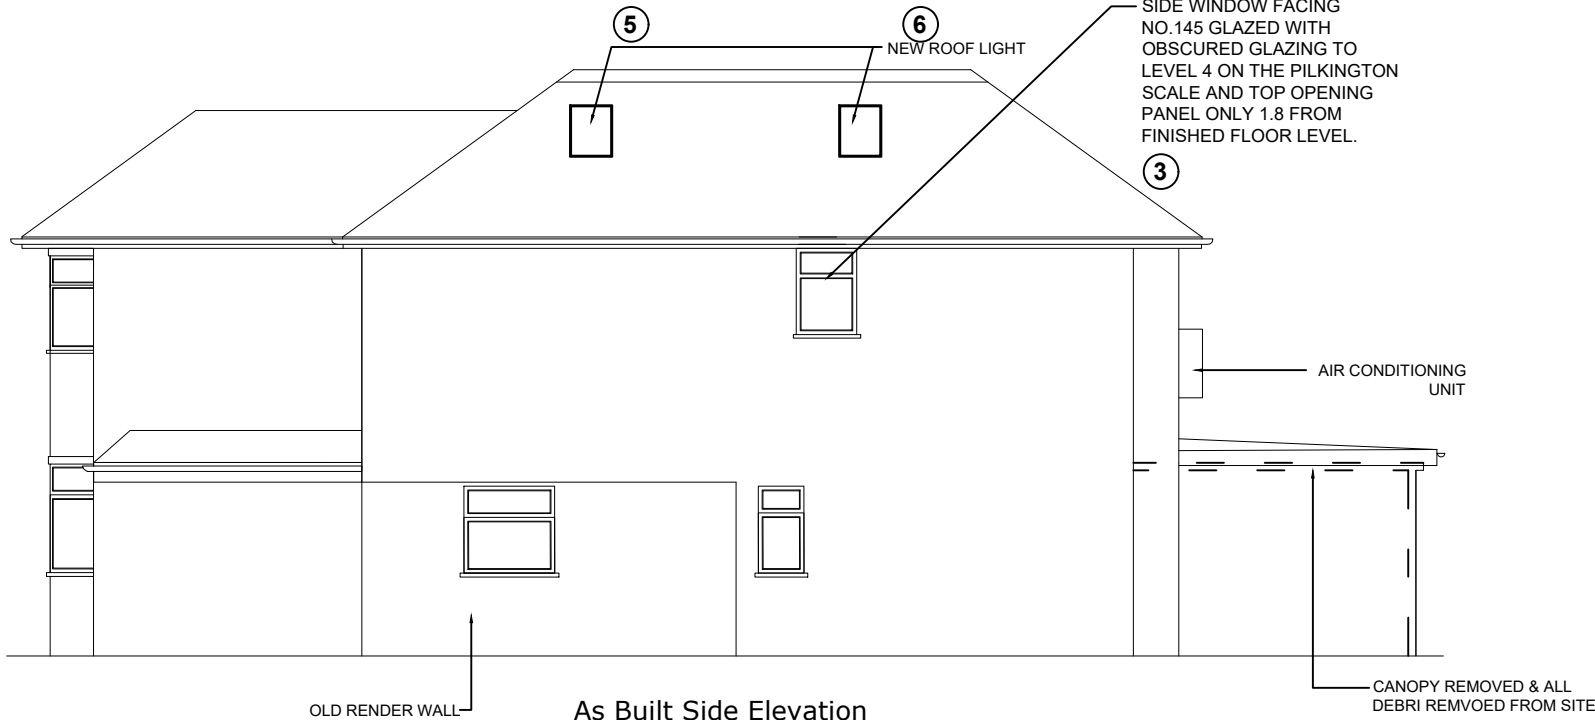


As Built Side Elevation





As Built Rear Elevation

FACING HOUSES 141 & 145
NEW & EXISTING ROOF LIGHTS/ GLAZED WITH OBSCURED GLAZING TO LEVEL 4 ON THE PILKINGTON SCALE AND FIXED SHUT AND NON OPENABLE.

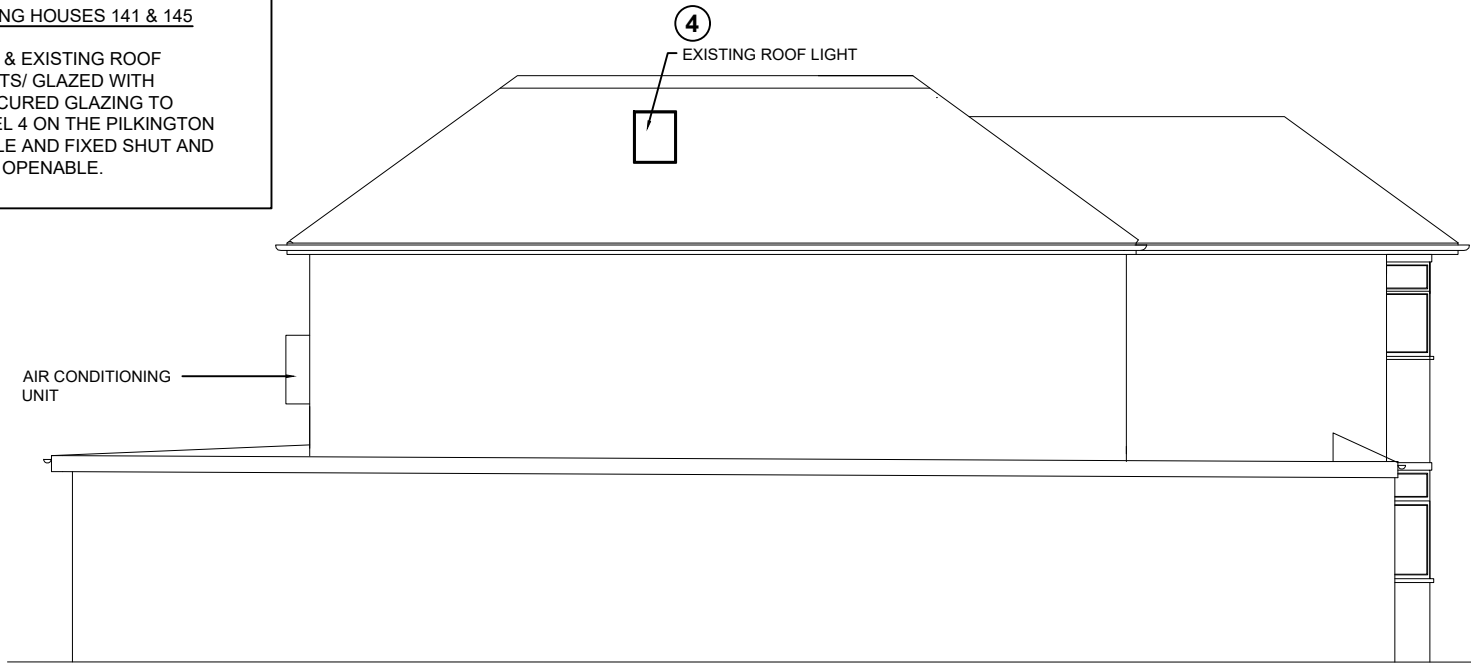

As Built Side Elevation

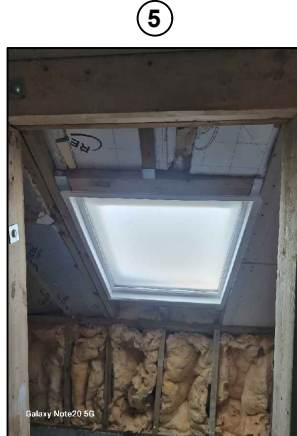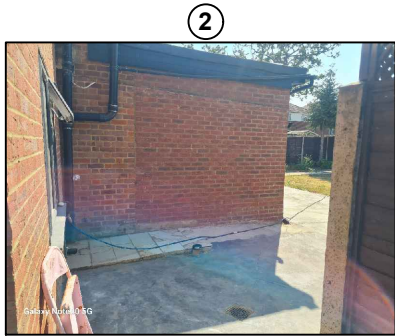

REV B - COUNCIL COMMENTS AUG 2026
REV A - COUNCIL COMMENTS MAY 2026

Project	143 Long Lane, Hillingdon, UB10 9JN		
Drawing Title	As Built Elevations		
Drawing Title	143 /P/F	Rev.	B
Rev.	Scale: 1/100	Date: Jan 2026	