





As Built Front Elevation



As Built Side Elevation

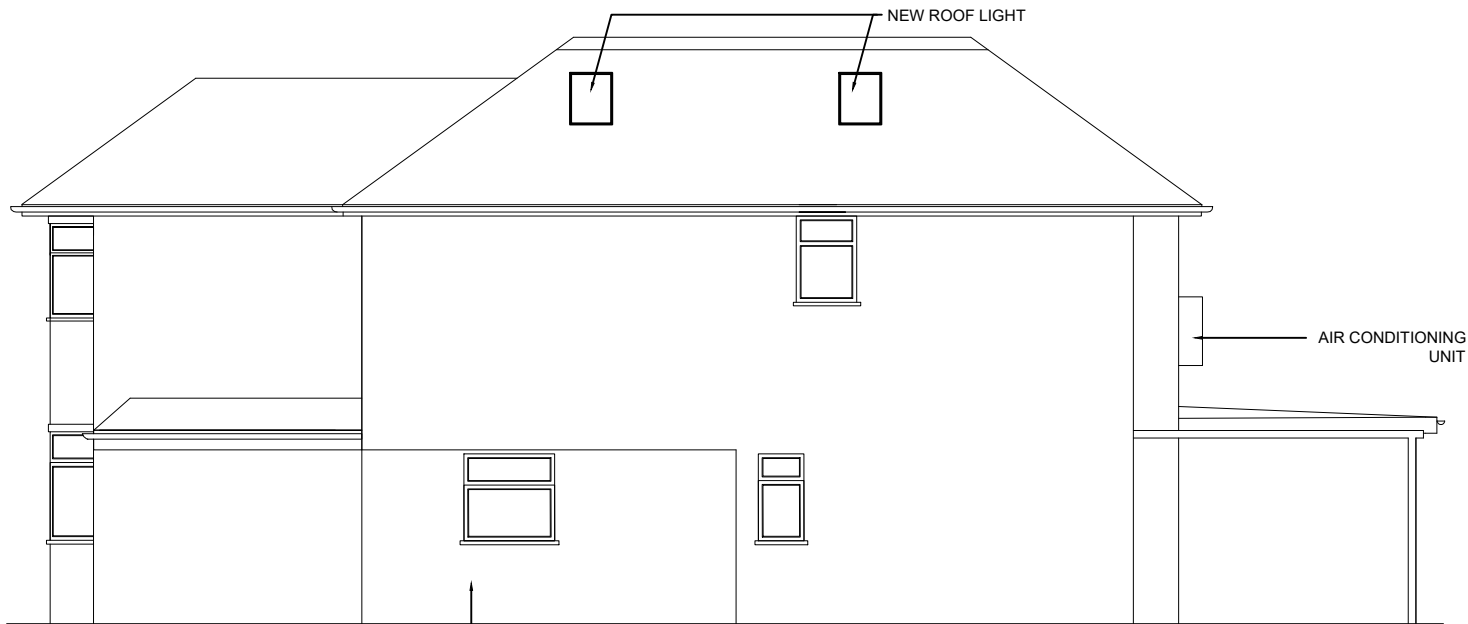

As Built Rear Elevation

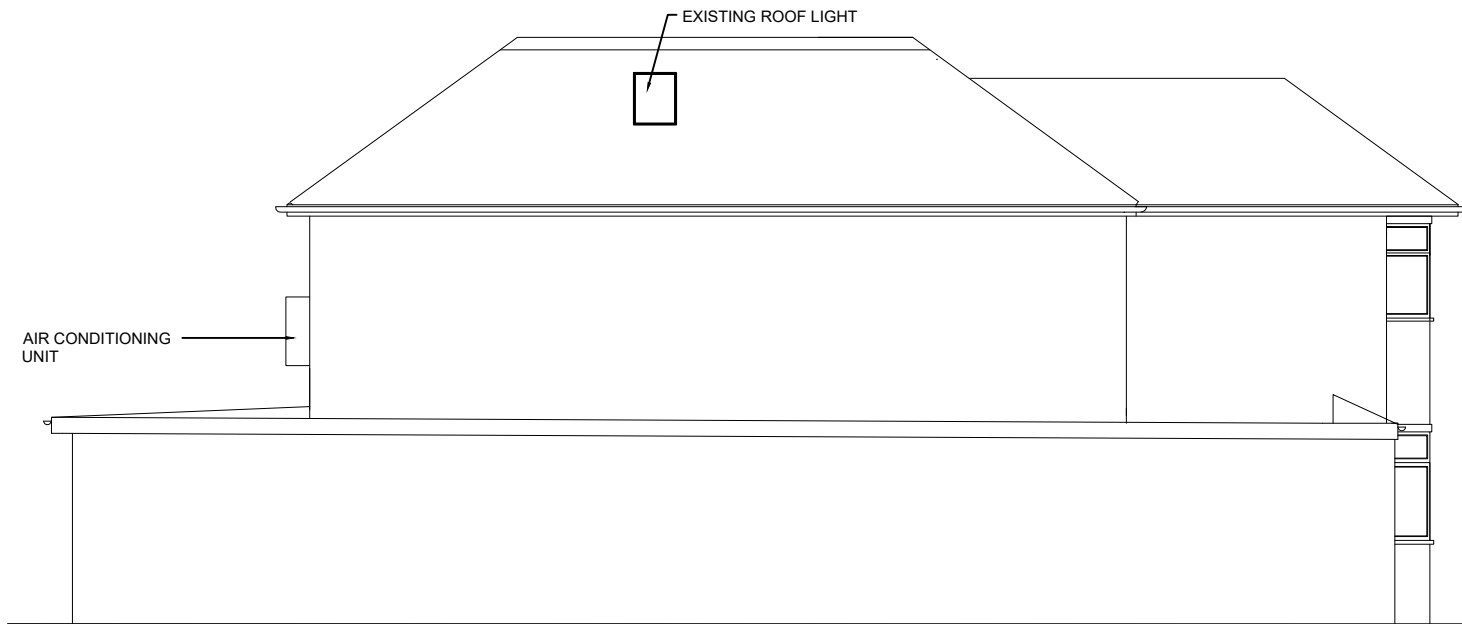

As Built Side Elevation

REV A - COUNCIL COMMENTS MAY 2026

Project	143 Long Lane, Hillingdon, UB10 9JN		
Drawing Title	As Built Elevations		
Drawing Title	143 /P/F	Rev.	A
Rev.	Scale: 1/100	Date: Jan 2026	