





As Built Front Elevation



As Built Side Elevation

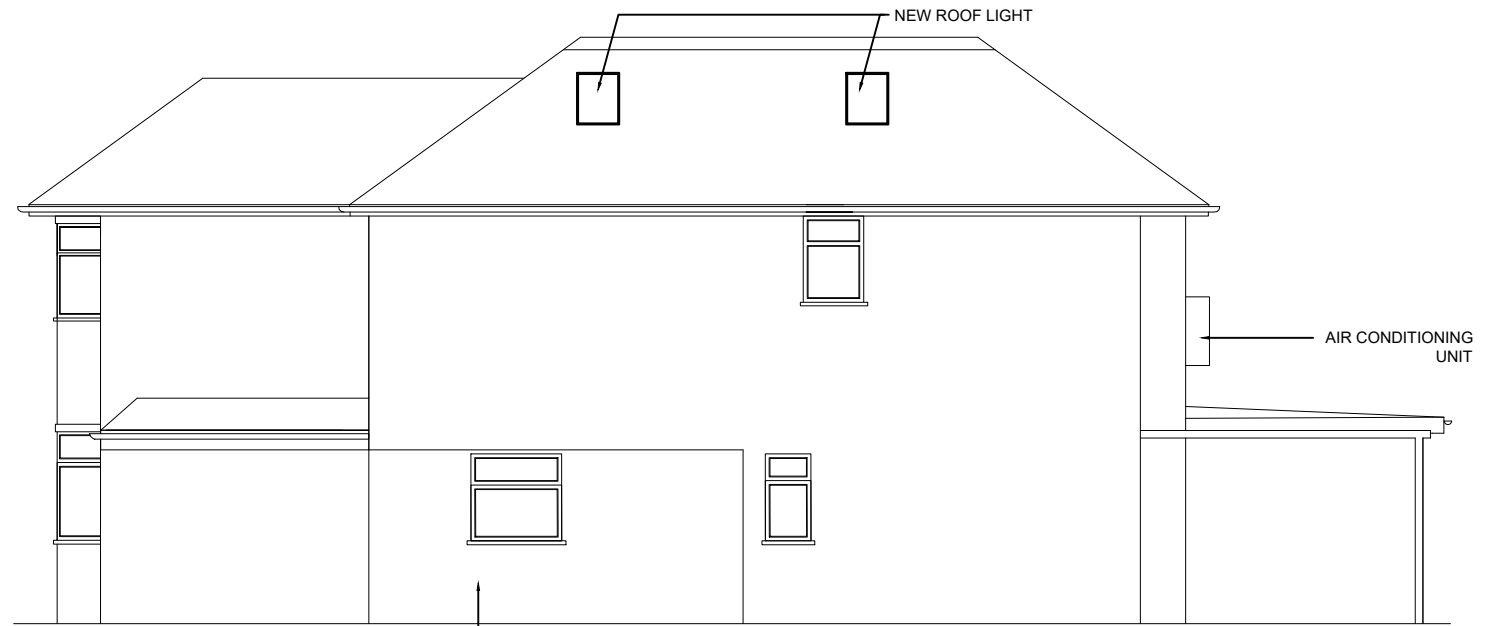

As Built Rear Elevation

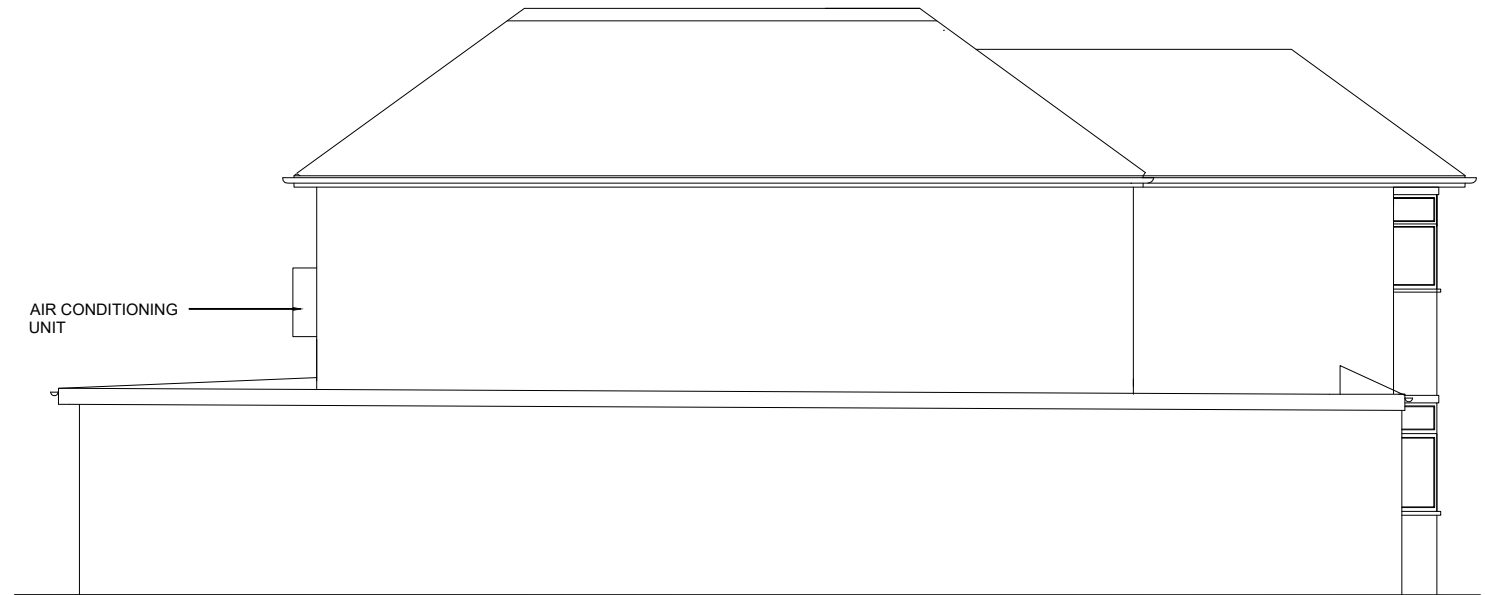

As Built Side Elevation

Project <b>143 Long Lane, Hillingdon, UB10 9JN</b>		
Drawing Title <b>As Built Elevations</b>		
Drawing Title	<b>143 /P/F</b>	Rev.
Rev.	Scale: <b>1/100</b>	Date: <b>Jan 2026</b>