



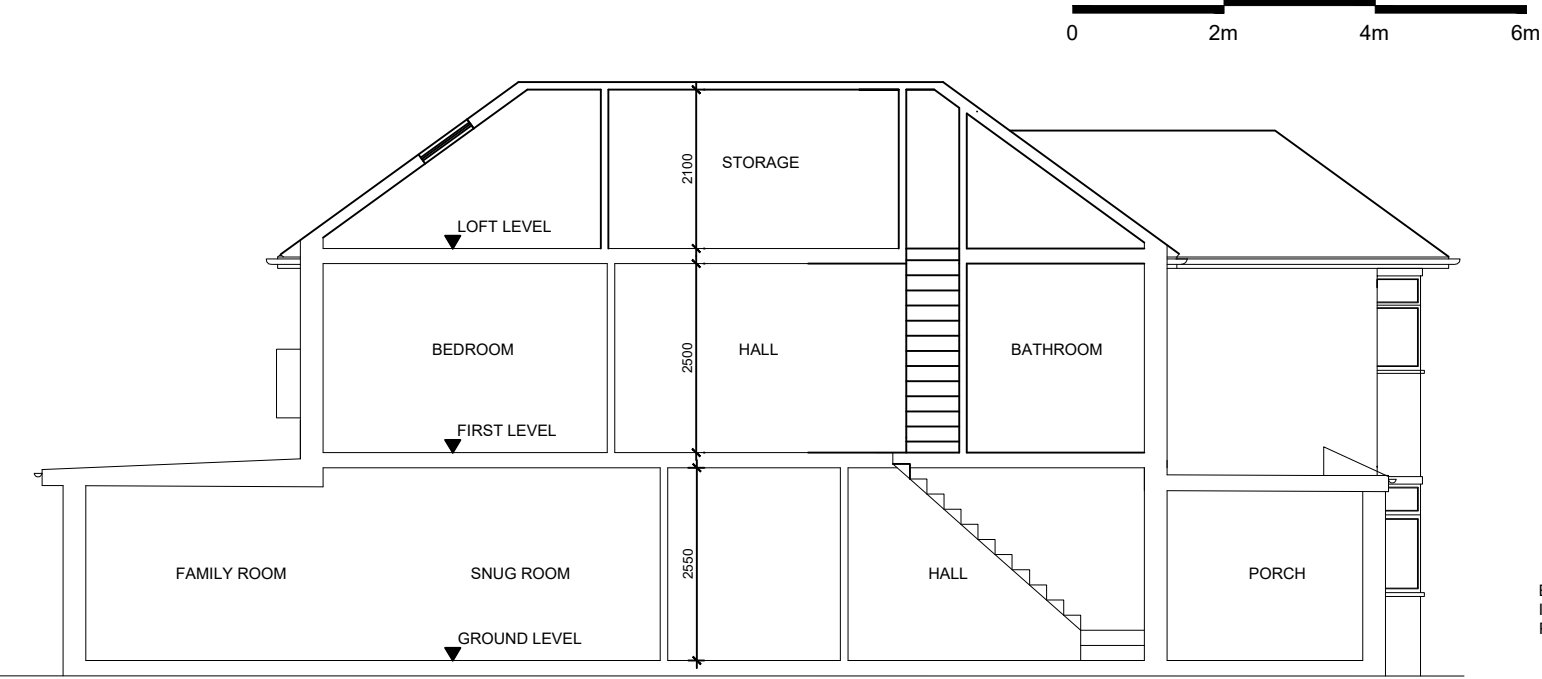

As Built Side Section

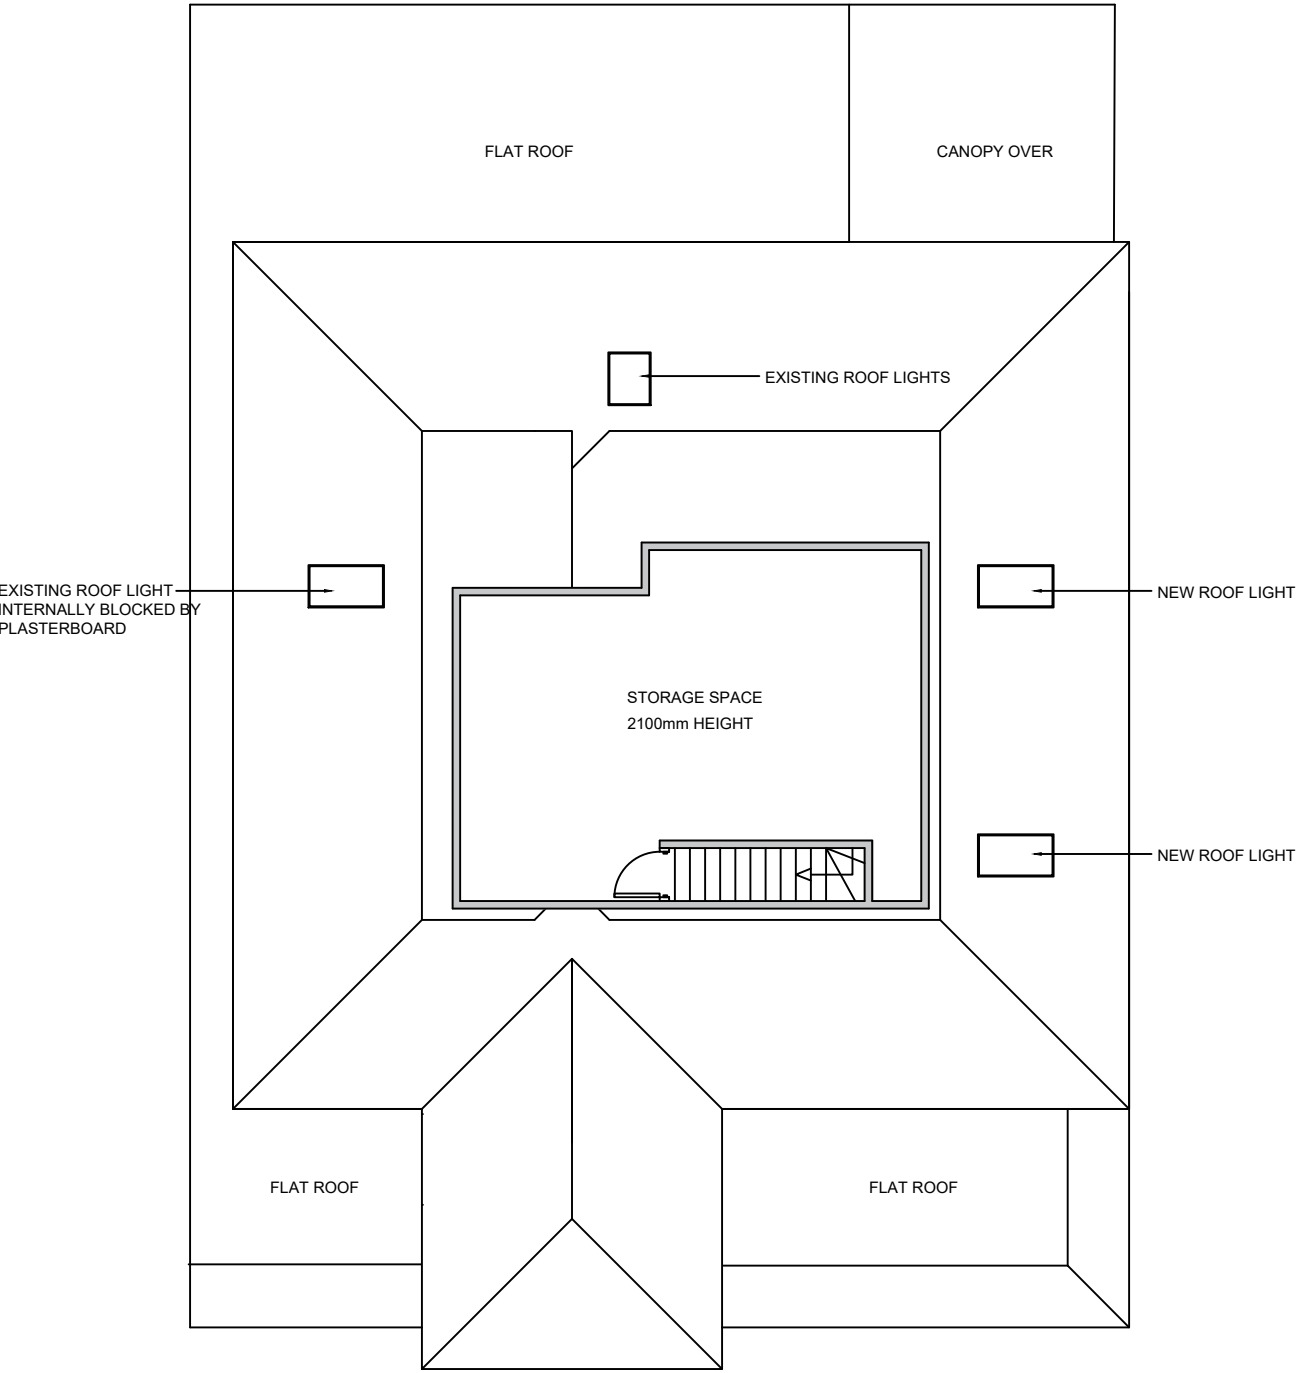

As Built Loft Plan

REV B - COUNCIL COMMENTS MAY 2026		
REV A	LOFT FLOOR & SECTION MAY 2026	
Project	143 Long Lane, Hillingdon, UB10 9JN	
Drawing Title	As Built Section & Loft Floor Plan	
Drawing Title	143 /P/K	Rev. B
	Scale: 1/100	Date: Jan 2026