


As Built Side Section

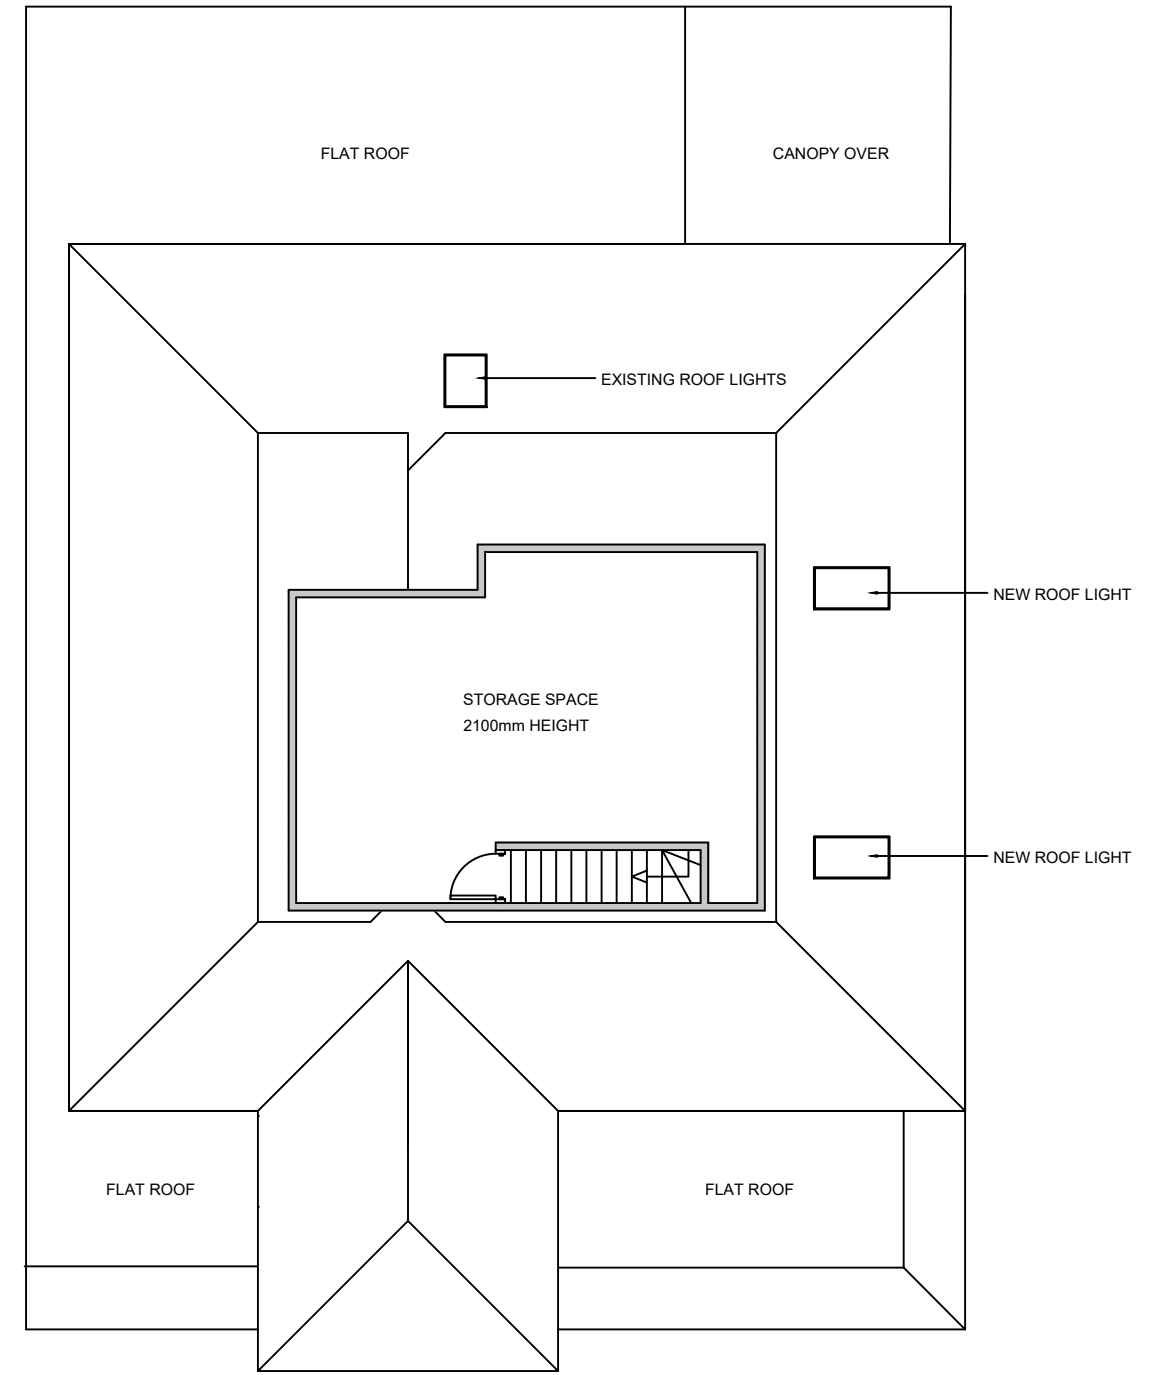

As Built Loft Plan

REV A	LOFT FLOOR & SECTION	
Project	143 Long Lane, Hillingdon, UB10 9JN	
Drawing Title	As Built Section & Loft Floor Plan	
Drawing Title	143 /P/K	Rev. A
Rev. A	Scale: 1/100	Date: Jan 2026