


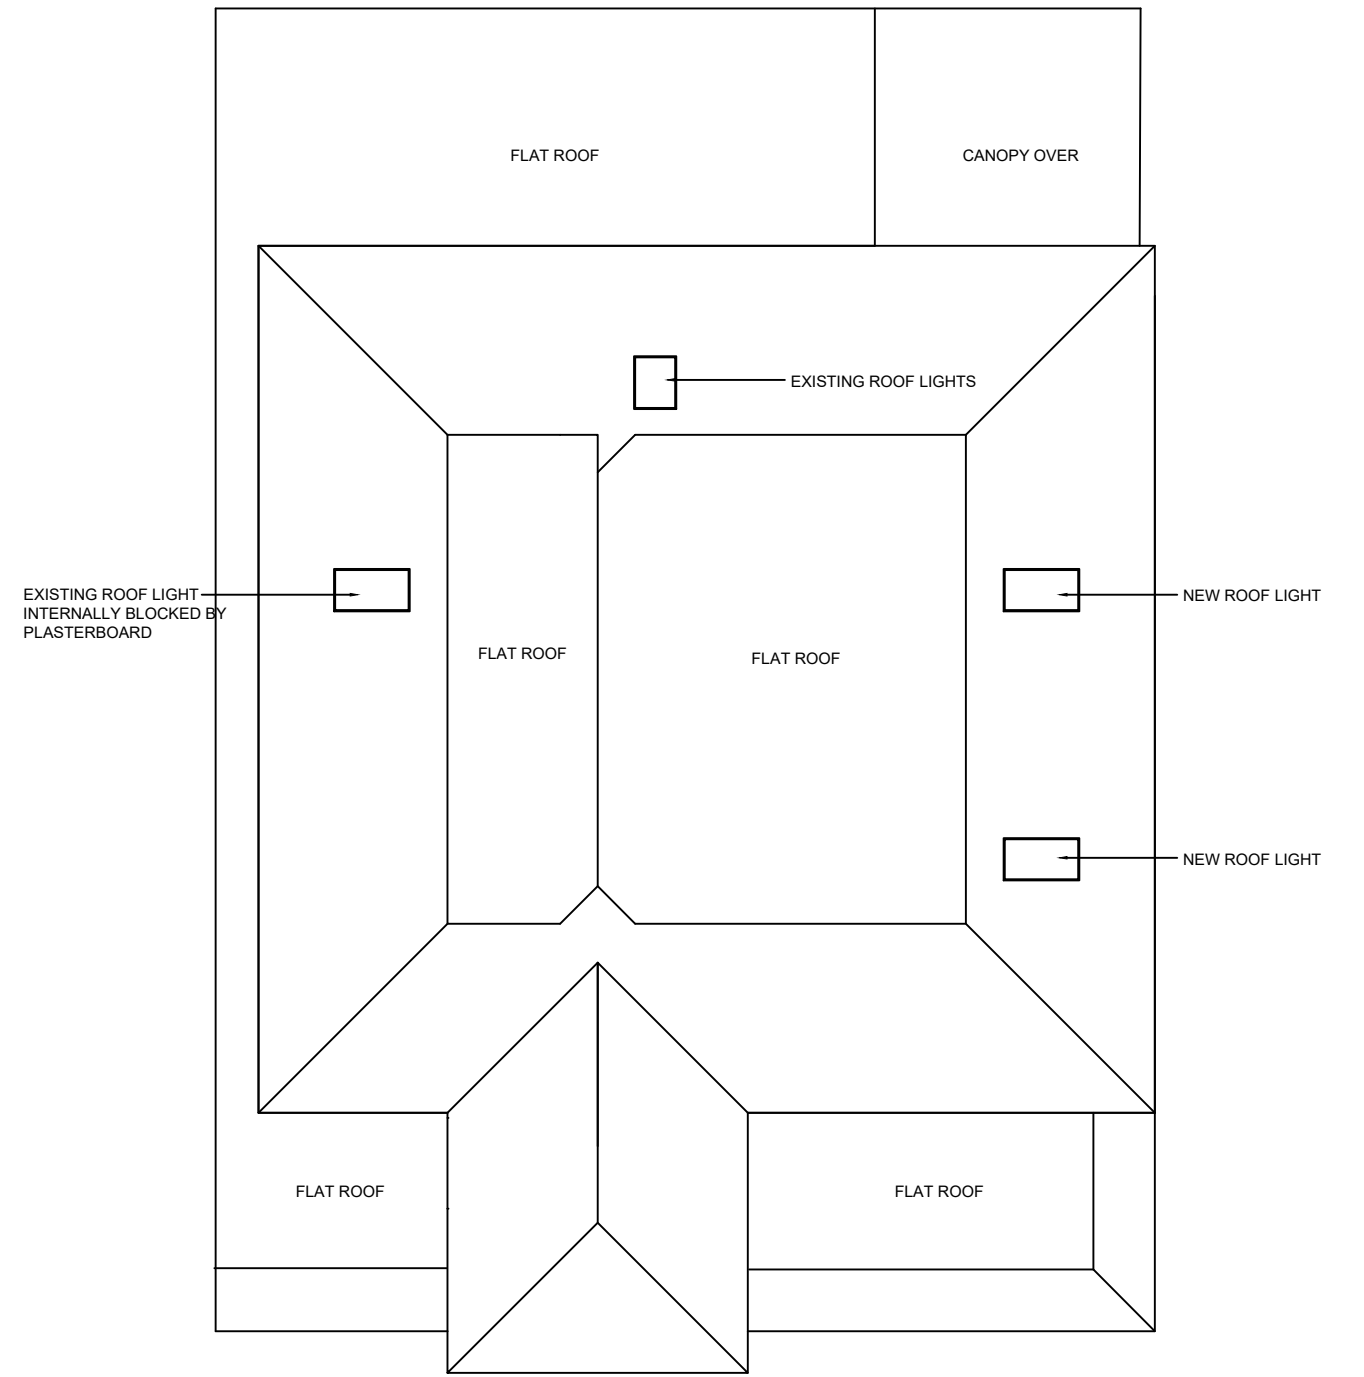

As Built Roof Plan



REV B - COUNCIL COMMENTS MAY 2026
REV A - COUNCIL COMMENTS MAY 2026

Project	143 Long Lane, Hillingdon, UB10 9JN		
Drawing Title	As Built Floor Plans		
Drawing Title	143 /P/E	Rev.	B
	Scale: 1/100	Date: Jan 2026	