




SITE LOCATION PLAN
AREA 2 HA
SCALE 1:1250 on A4
CENTRE COORDINATES: 507518, 183671



Supplied by Streetwise Maps Ltd
www.streetwise.net
 Licence No: 100047474
 06/02/2026 23:58

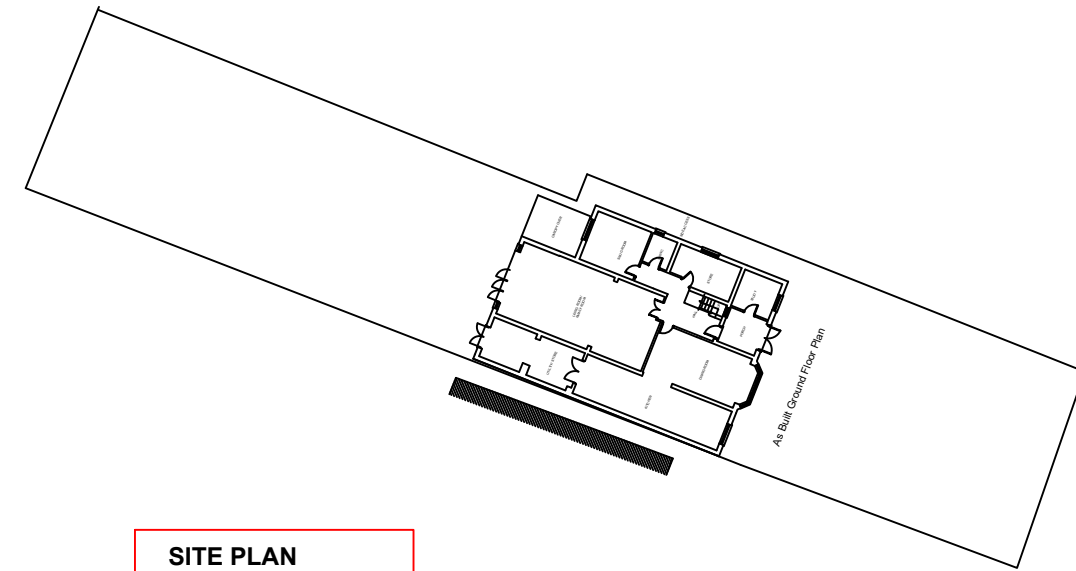

SITE PLAN
1:500 SCALE

LOCATION PLAN
1:1250 SCALE

Project 143 Long Lane, Hillingdon, UB10 9JN		
Drawing Title Location Plan & As Built Site Plan		
Drawing Title	143 /P/A	Rev.
Rev.	Scale: 1/1250 1: 500	Date: Jan 2026