


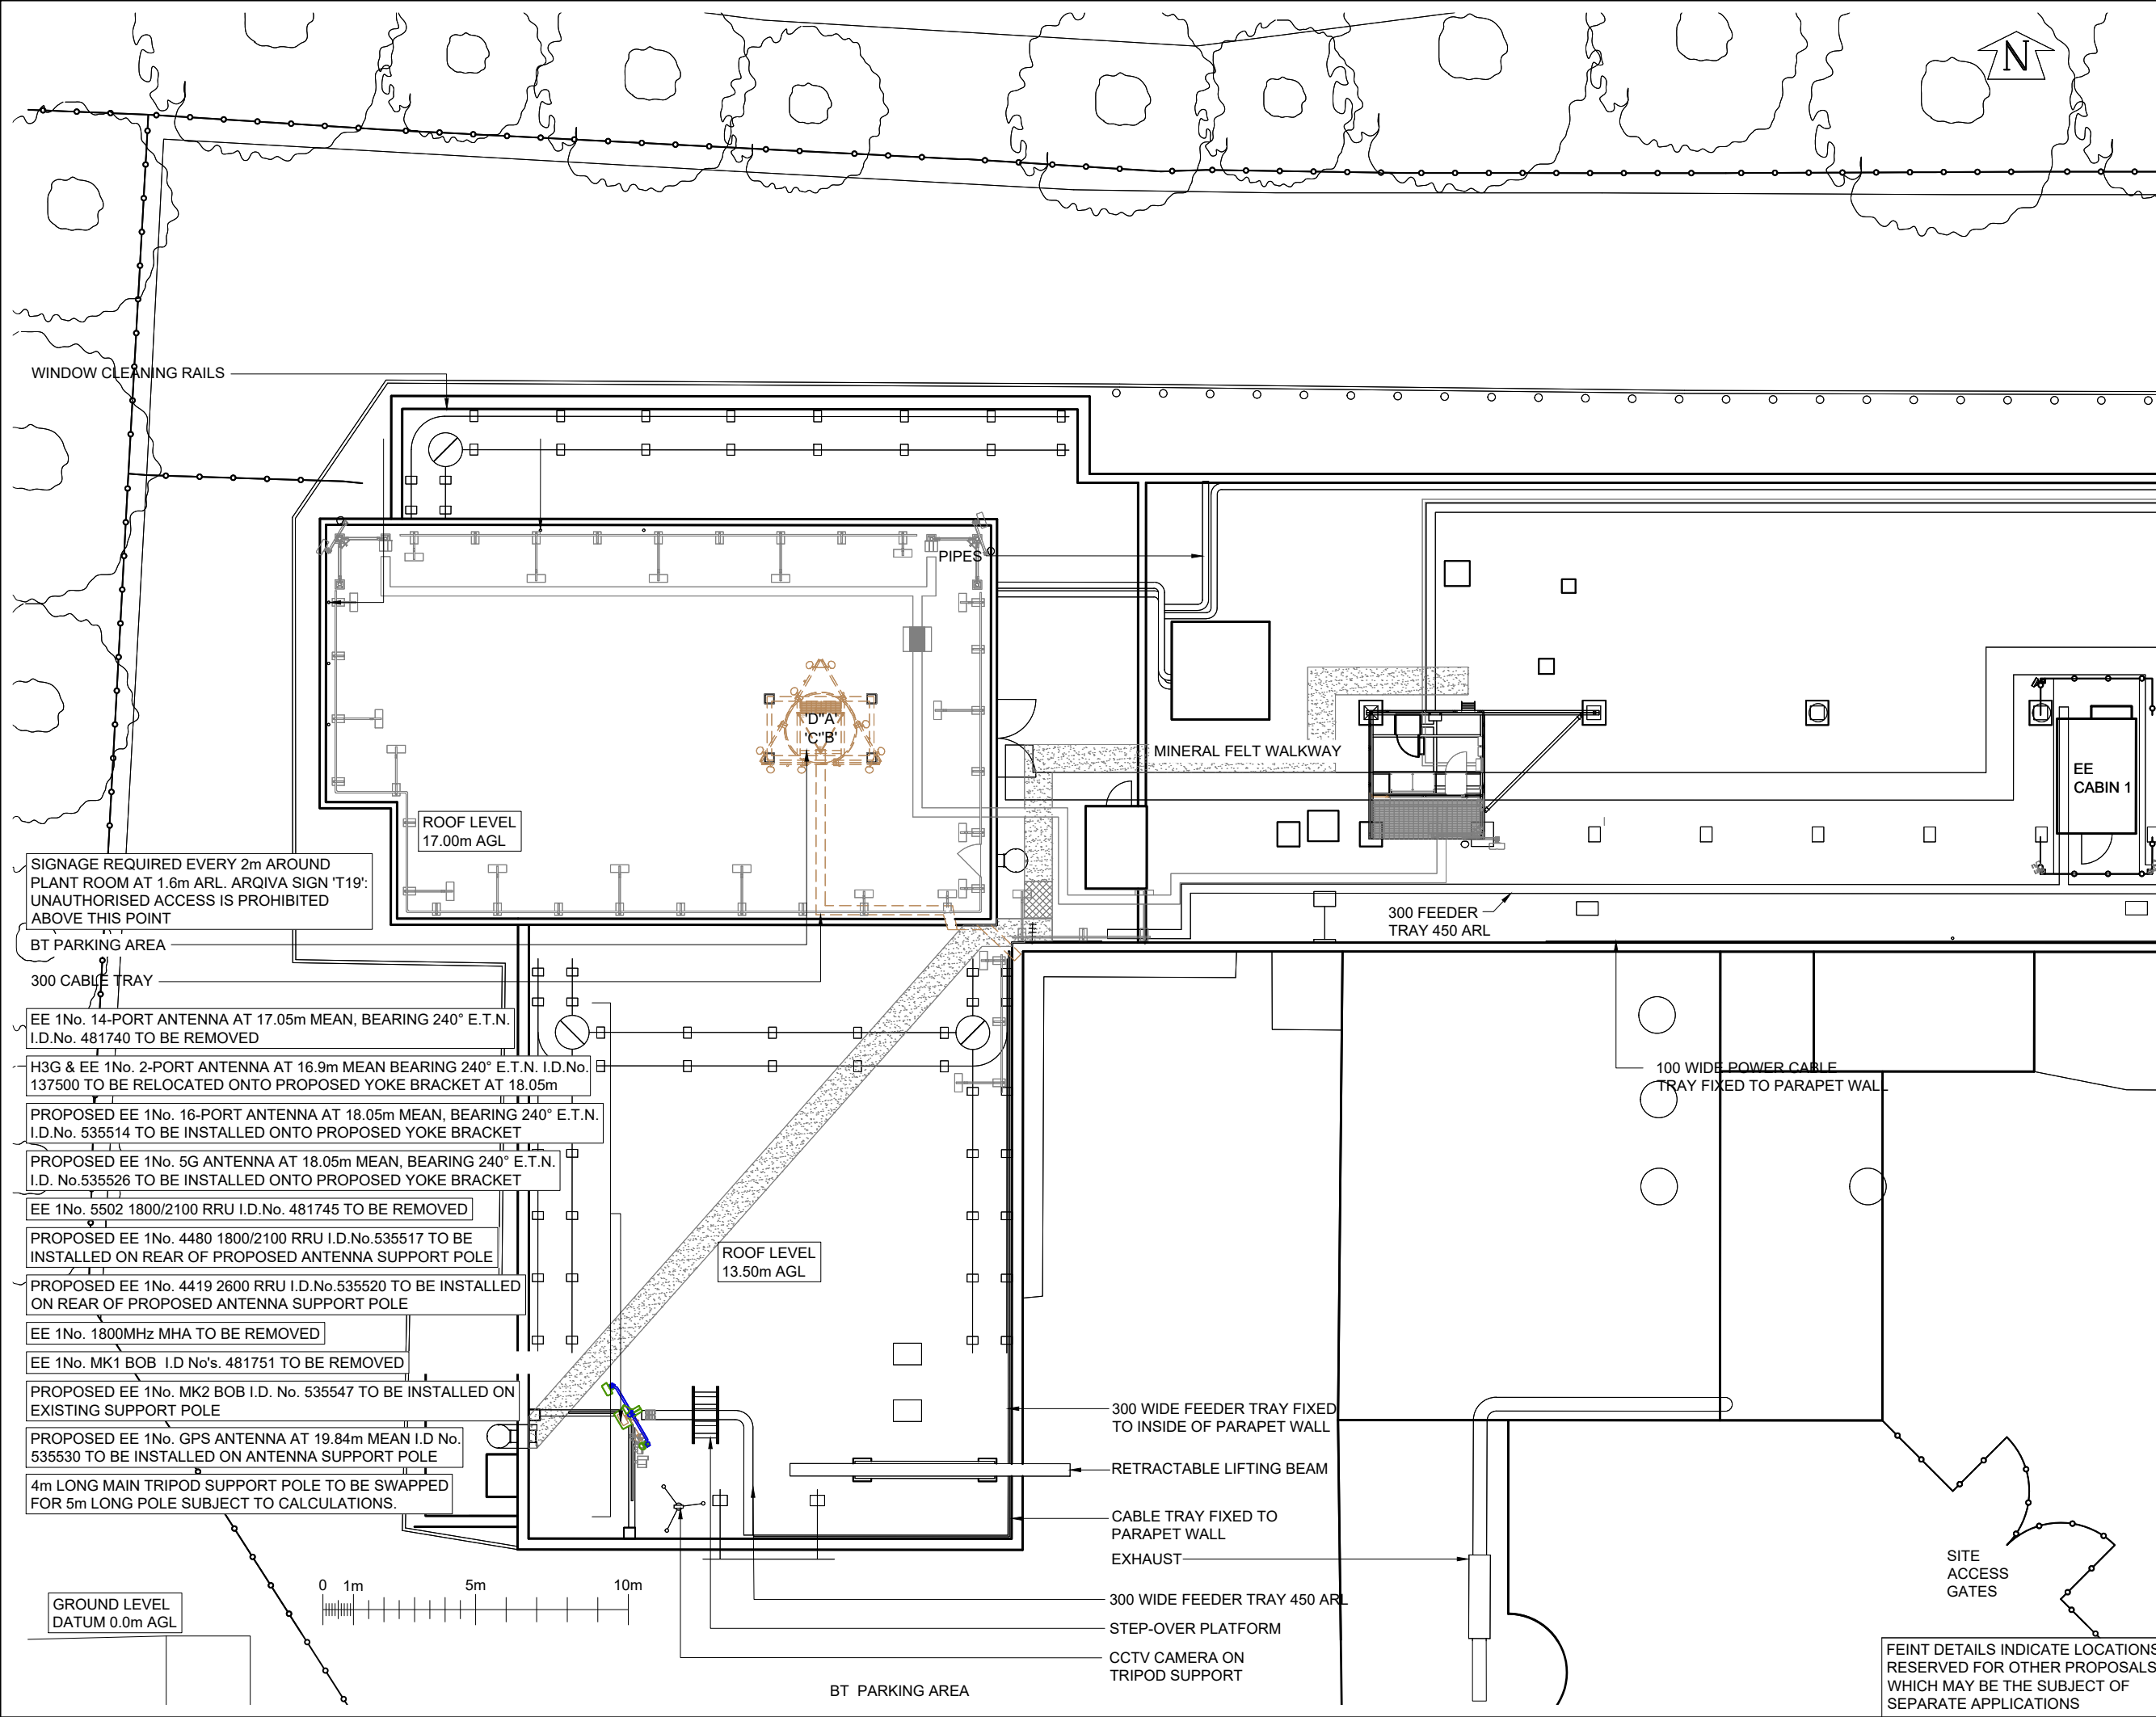

©2020 Cellnex
All rights reserved. No part of this publication may be reproduced, stored in a retrieval system or transmitted in any form or by any means (Electronic, Mechanical, Photocopying, Recording or otherwise), without the prior written consent of the Company.

NOTES

PROJECT No. 238825

CELL No. 98509

BT SKYLINE No. TW0007

31	PROJ No 238825				
	PLANNING	05/10/21	WHP	WHP	
30	PROJ No 212166				
	PLANNING AMEND	03/08/21	DAL	DAL	
29	PROJ No 229637				
	AS BUILT	09/06/21	WHP	MF	
28	PROJ No 212166				
	Planning Amend	21/05/21	DAL	DAL	
27	PROJ No 212166				
	Planning Amend	12/03/21	DAL	DAL	
ISS	REVISION	DATE	DRN	APP	

cellnex
driving telecom connectivity

CELLNEX UK
R+, 4TH FLOOR, 2 BLA GRAVE STREET, READING, RG1 1AZ
Tel. 020 4526 8553

SITE No 168646

SKYPORT TE

NEWALL ROAD

LONDON HEATHROW AIRPORT

HILLINGDON

GREATER LONDON 3

TW6 2RT

NGR TQ 08770 76810

OS GRID 508770 176810

TITLE

SITE PLAN 1

PROPOSED

H3G & EE LTD


SCALE 1:200

DRAWN IM 19/08/11

APPROVED WHP 05/10/21

DRG No. Sheet 1 of 2 Rev

168646-02-100-MD031 31

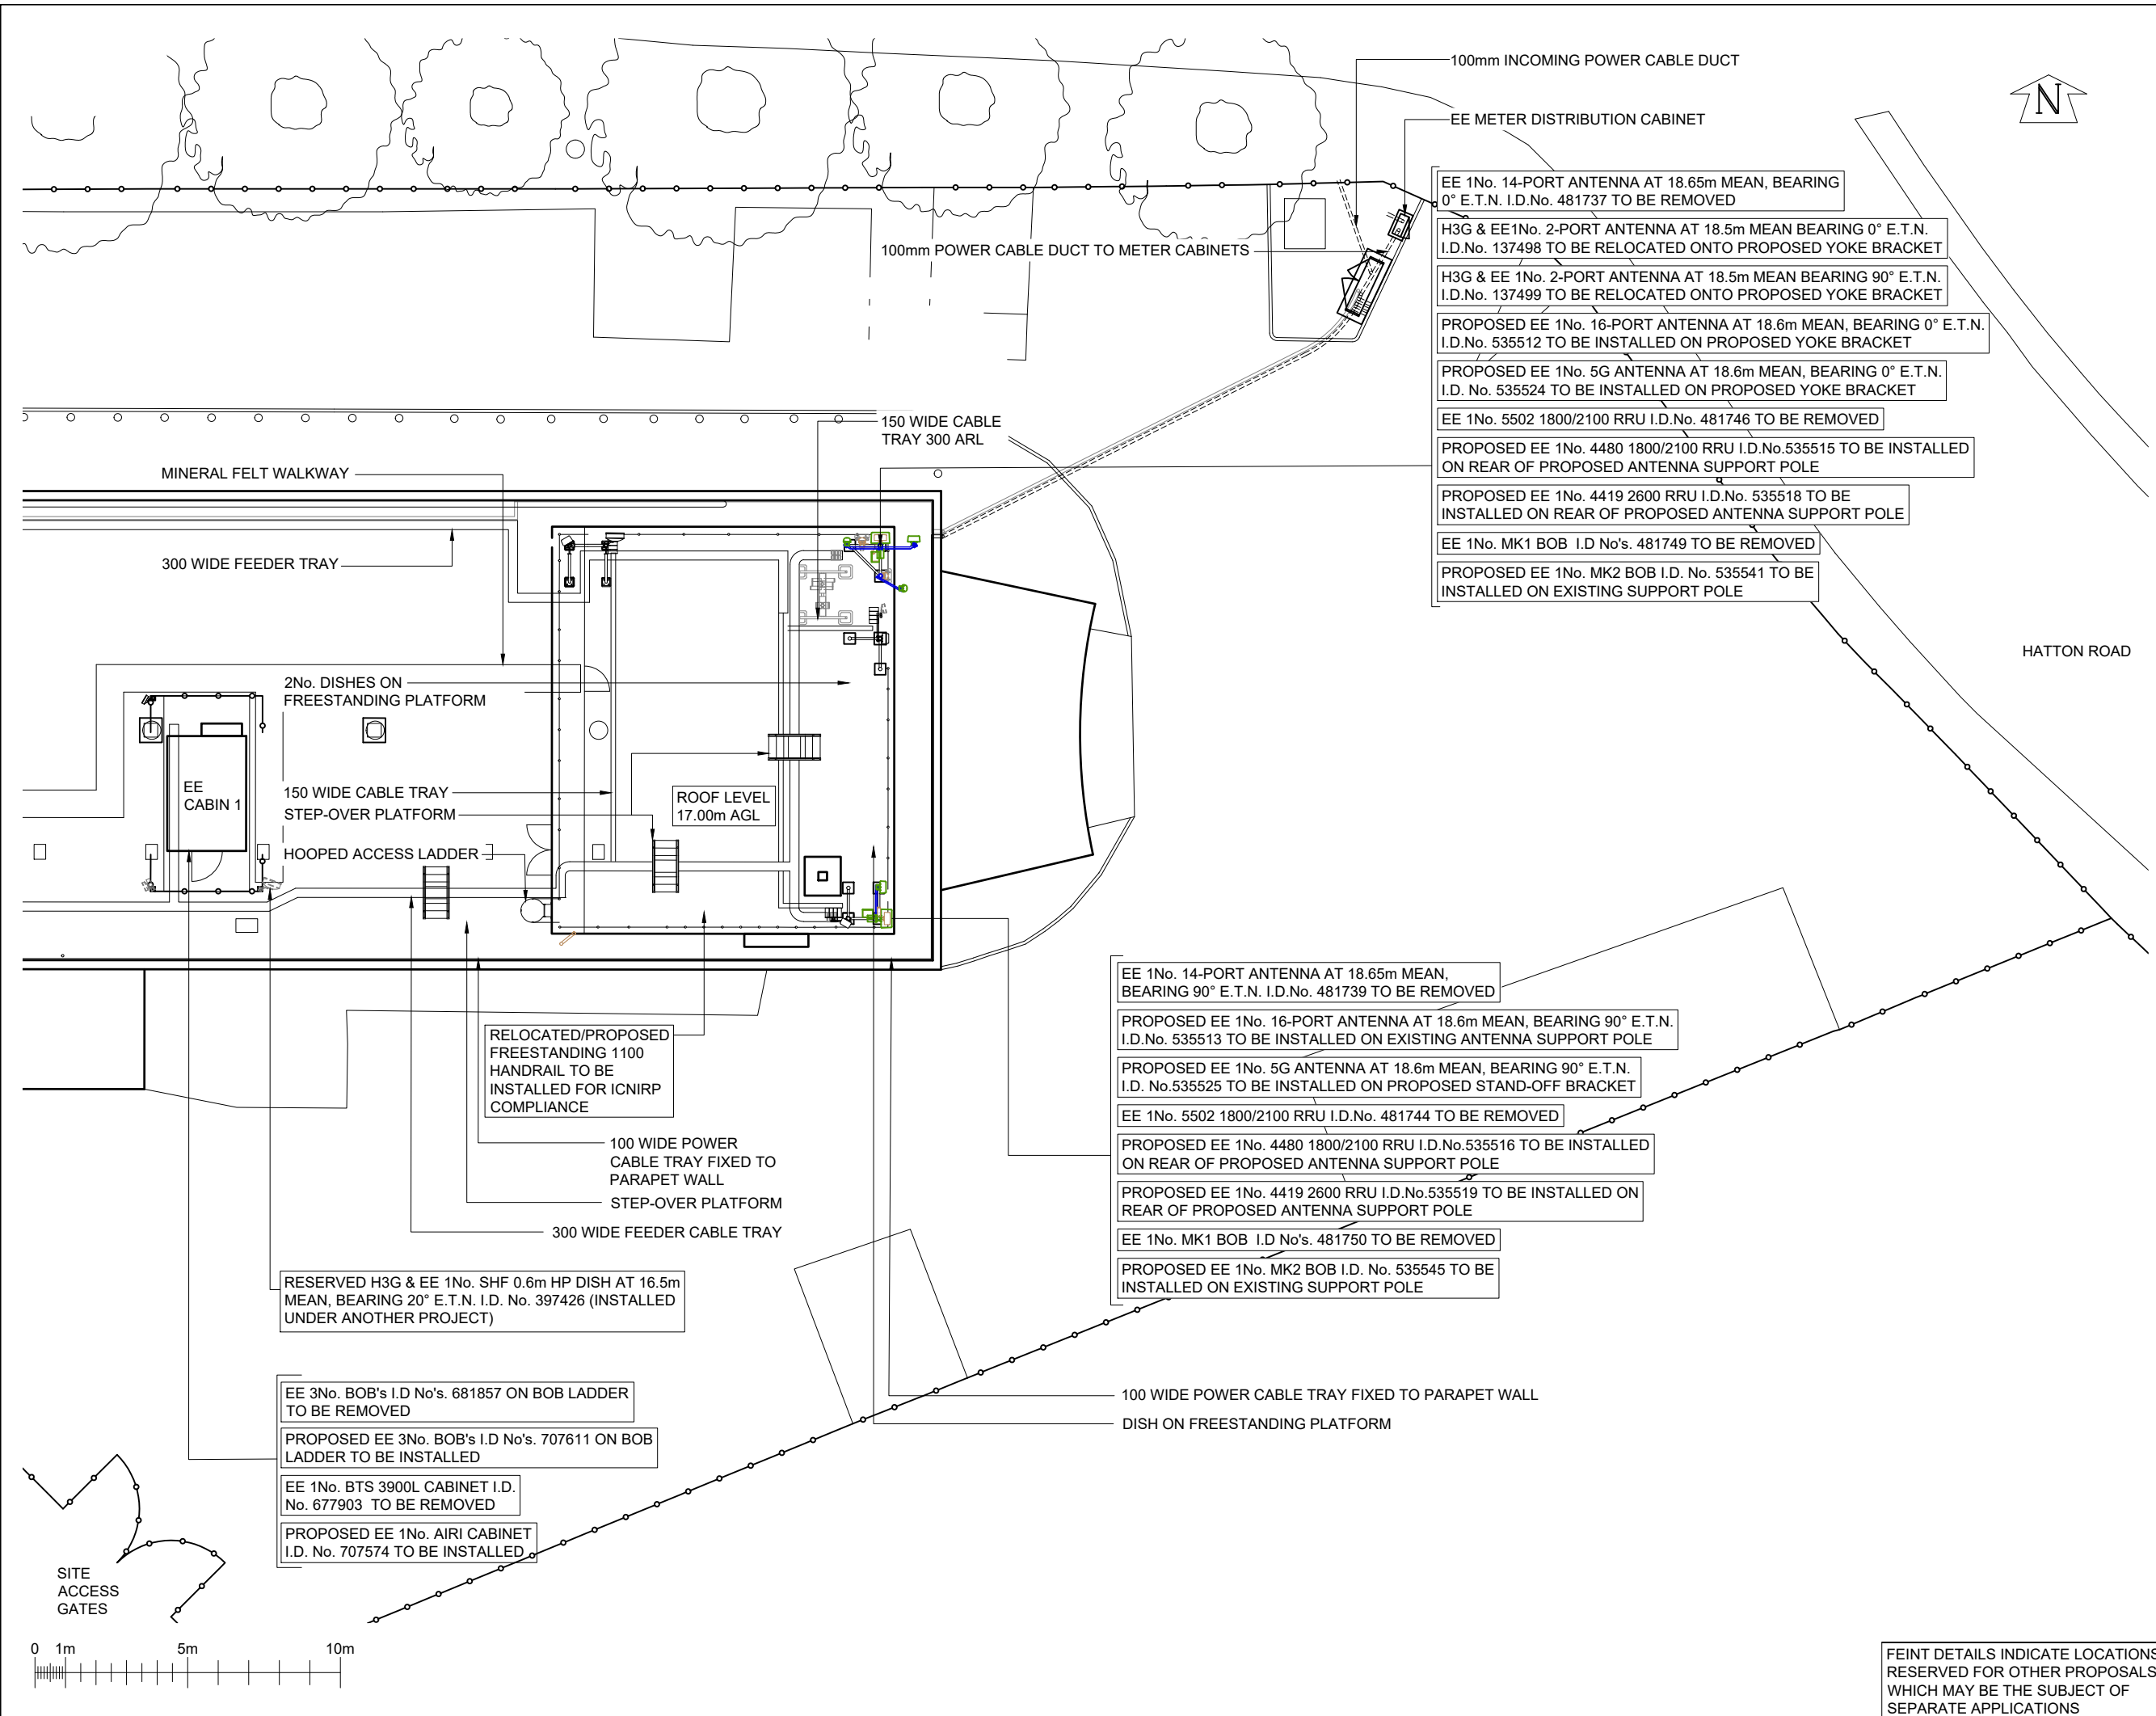

- EE 1No. 14-PORT ANTENNA AT 18.65m MEAN, BEARING 0° E.T.N. I.D.No. 481737 TO BE REMOVED
- H3G & EE1No. 2-PORT ANTENNA AT 18.5m MEAN BEARING 0° E.T.N. I.D.No. 137498 TO BE RELOCATED ONTO PROPOSED YOKE BRACKET
- H3G & EE 1No. 2-PORT ANTENNA AT 18.5m MEAN BEARING 90° E.T.N. I.D.No. 137499 TO BE RELOCATED ONTO PROPOSED YOKE BRACKET
- PROPOSED EE 1No. 16-PORT ANTENNA AT 18.6m MEAN, BEARING 0° E.T.N. I.D.No. 535512 TO BE INSTALLED ON PROPOSED YOKE BRACKET
- PROPOSED EE 1No. 5G ANTENNA AT 18.6m MEAN, BEARING 0° E.T.N. I.D. No. 535524 TO BE INSTALLED ON PROPOSED YOKE BRACKET
- EE 1No. 5502 1800/2100 RRU I.D.No. 481746 TO BE REMOVED
- PROPOSED EE 1No. 4480 1800/2100 RRU I.D.No.535515 TO BE INSTALLED ON REAR OF PROPOSED ANTENNA SUPPORT POLE
- PROPOSED EE 1No. 4419 2600 RRU I.D.No. 535518 TO BE INSTALLED ON REAR OF PROPOSED ANTENNA SUPPORT POLE
- EE 1No. MK1 BOB I.D No's. 481749 TO BE REMOVED
- PROPOSED EE 1No. MK2 BOB I.D. No. 535541 TO BE INSTALLED ON EXISTING SUPPORT POLE

- EE 1No. 14-PORT ANTENNA AT 18.65m MEAN, BEARING 90° E.T.N. I.D.No. 481739 TO BE REMOVED
- PROPOSED EE 1No. 16-PORT ANTENNA AT 18.6m MEAN, BEARING 90° E.T.N. I.D.No. 535513 TO BE INSTALLED ON EXISTING ANTENNA SUPPORT POLE
- PROPOSED EE 1No. 5G ANTENNA AT 18.6m MEAN, BEARING 90° E.T.N. I.D. No.535525 TO BE INSTALLED ON PROPOSED STAND-OFF BRACKET
- EE 1No. 5502 1800/2100 RRU I.D.No. 481744 TO BE REMOVED
- PROPOSED EE 1No. 4480 1800/2100 RRU I.D.No.535516 TO BE INSTALLED ON REAR OF PROPOSED ANTENNA SUPPORT POLE
- PROPOSED EE 1No. 4419 2600 RRU I.D.No.535519 TO BE INSTALLED ON REAR OF PROPOSED ANTENNA SUPPORT POLE
- EE 1No. MK1 BOB I.D No's. 481750 TO BE REMOVED
- PROPOSED EE 1No. MK2 BOB I.D. No. 535545 TO BE INSTALLED ON EXISTING SUPPORT POLE

©2020 Cellnex
All rights reserved. No part of this publication may be reproduced, stored in a retrieval system or transmitted in any form or by any means (Electronic, Mechanical, Photocopying, Recording or otherwise), without the prior written consent of the Company.

NOTES

PROJECT No. 238825

CELL No. 98509

BT SKYLINE No. TW0007

31	PROJ No 238825				
	PLANNING	05/10/21	WHP	VHF	
30	PROJ No 212166				
	PLANNING AMEND	03/08/21	DAL	DAL	
29	PROJ No 229637				
	AS BUILT	09/06/21	WHP	MF	
28	PROJ No 212166				
	Planning Amend	21/05/21	DAL	DAL	
27	PROJ No 212166				
	Planning Amend	12/03/21	DAL	DAL	
ISS	REVISION	DATE	DRN	APP	

cellnex
driving telecom connectivity

CELLNEX UK
R+, 4TH FLOOR, 2 BLA GRAVE STREET, READING, RG1 1AZ
Tel. 020 4526 8553

SITE No 168646

SKYPORT TE
NEWALL ROAD
LONDON HEATHROW AIRPORT
HILLINGDON
GREATER LONDON 3
TW6 2RT

NGR TQ 08770 76810

OS GRID 508770 176810

TITLE
SITE PLAN 2
PROPOSED
H3G & EE LTD

SCALE 1:200

DRAWN	IM	19/08/11
APPROVED	WHP	05/10/21

DRG No. Sheet 2 of 2 Rev

168646-02-100-MD031 31

FEINT DETAILS INDICATE LOCATIONS RESERVED FOR OTHER PROPOSALS WHICH MAY BE THE SUBJECT OF SEPARATE APPLICATIONS



©2020 Cellnex
All rights reserved. No part of this publication may be reproduced, stored in a retrieval system or transmitted in any form or by any means (Electronic, Mechanical, Photocopying, Recording or otherwise), without the prior written consent of the Company.

NOTES

PROJECT No. 238825

CELL No. 98509

BT SKYLINE No.
TW0007

31	PROJ No 238825 PLANNING	05/10/21	WHP	WHP
30	PROJ No 212166 PLANNING AMEND	03/08/21	DAL	DAL
29	PROJ No 229637 AS BUILT	09/06/21	WHP	MF
28	PROJ No 212166 Planning Amend	21/05/21	DAL	DAL
27	PROJ No 212166 Planning Amend	12/03/21	DAL	DAL
ISS	REVISION	DATE	DRN	APP



CELLNEX UK
R+, 4TH FLOOR, 2 BLA GRAVE STREET, READING, RG1 1AZ
Tel. 020 4526 8553

SITE No **168646**
SKYPORT TE
NEWALL ROAD
LONDON HEATHROW AIRPORT
HILLINGDON
GREATER LONDON 3
TW6 2RT

NGR TQ 08770 76810


OS GRID 508770 176810

TITLE
EQUIPMENT LAYOUT
PROPOSED
H3G & EE LTD

SCALE 1:50


DRAWN	IM	19/08/11
APPROVED	WHP	05/10/21

DRG No.	Sheet 1 of 1	Rev
168646-02-101-MD031		31

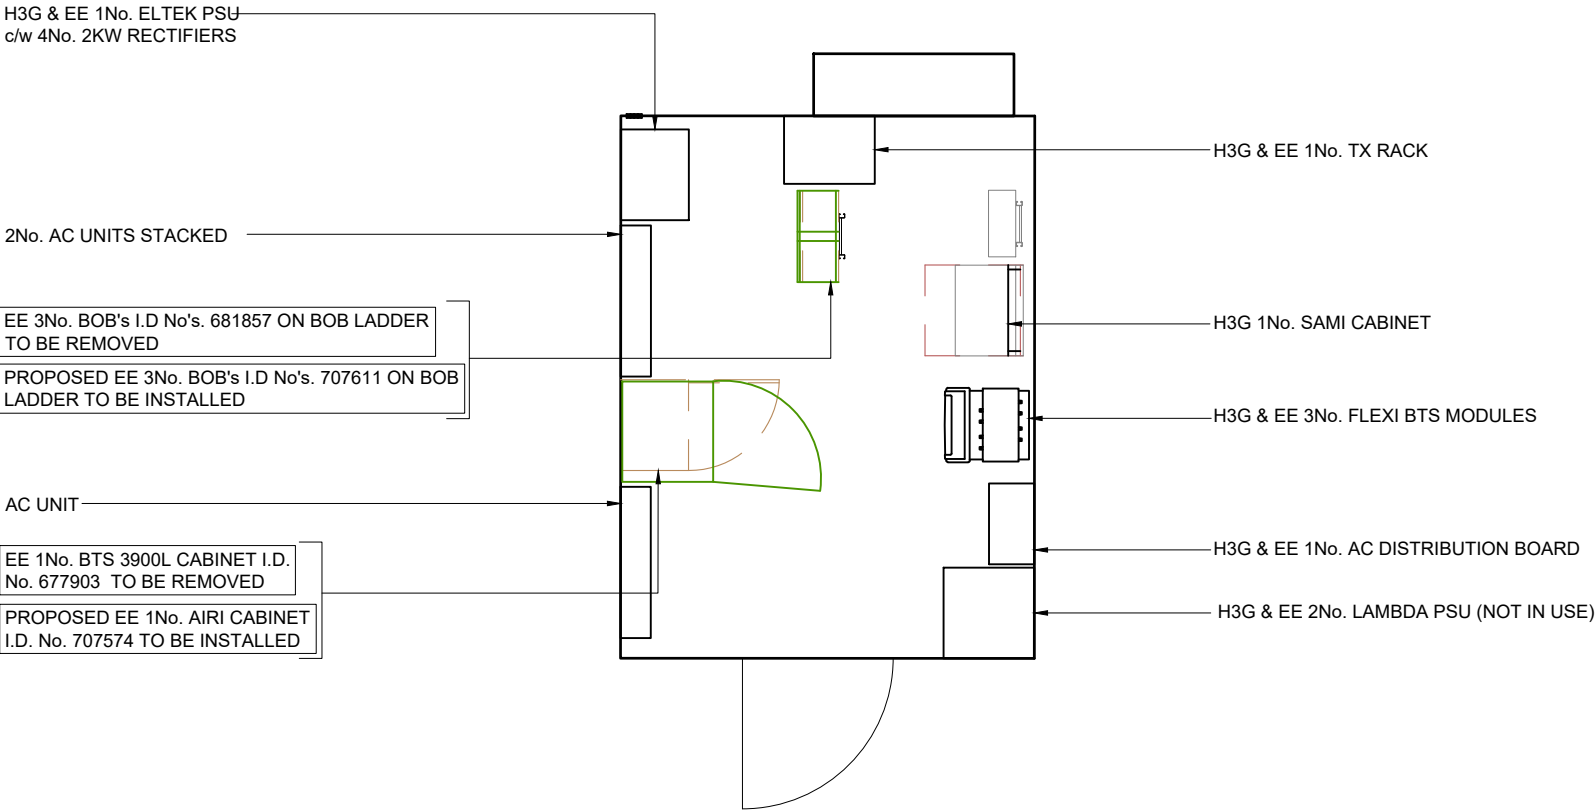

CABIN 1 EQUIPMENT LAYOUT
SCALE 1:50

FEINT DETAILS INDICATE LOCATIONS
RESERVED FOR OTHER PROPOSALS
WHICH MAY BE THE SUBJECT OF
SEPARATE APPLICATIONS

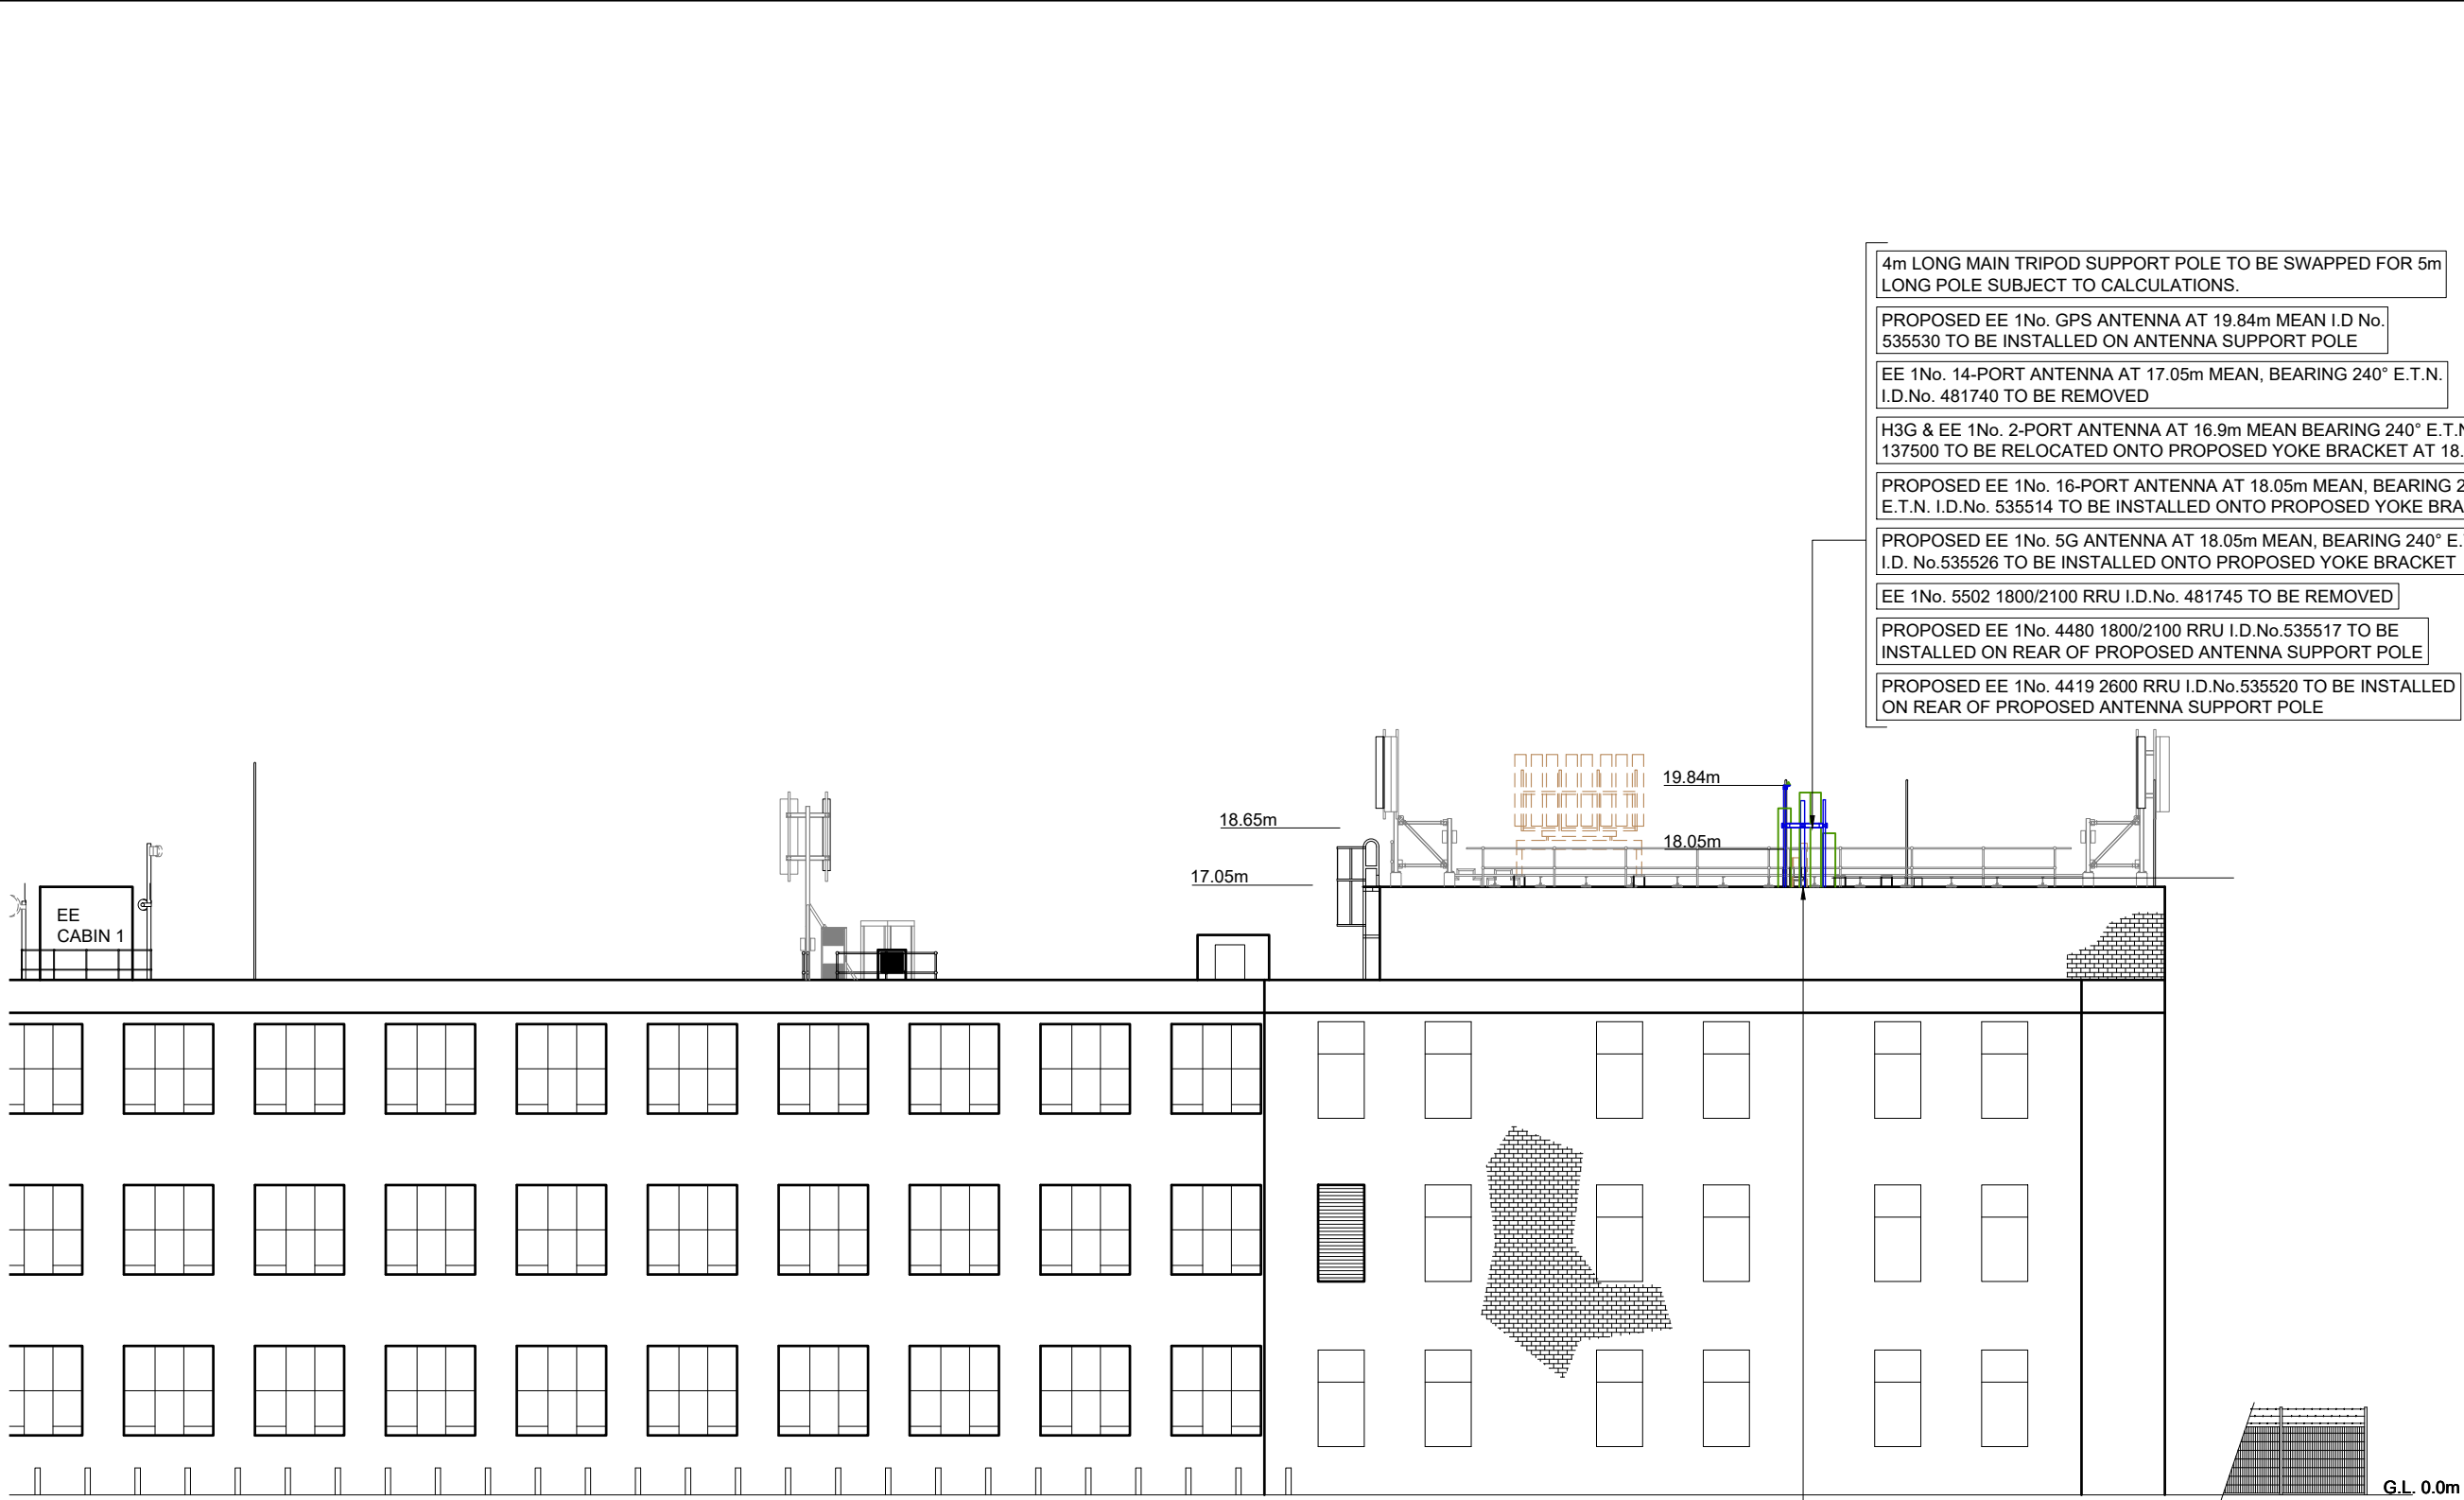

EE 1No. 1800MHz MHA TO BE REMOVED

EE 1No. MK1 BOB I.D No's. 481751 TO BE REMOVED

PROPOSED EE 1No. MK2 BOB I.D. No. 535547 TO BE INSTALLED ON EXISTING SUPPORT POLE

4m LONG MAIN TRIPOD SUPPORT POLE TO BE SWAPPED FOR 5m LONG POLE SUBJECT TO CALCULATIONS.

PROPOSED EE 1No. GPS ANTENNA AT 19.84m MEAN I.D No. 535530 TO BE INSTALLED ON ANTENNA SUPPORT POLE

EE 1No. 14-PORT ANTENNA AT 17.05m MEAN, BEARING 240° E.T.N. I.D.No. 481740 TO BE REMOVED

H3G & EE 1No. 2-PORT ANTENNA AT 16.9m MEAN BEARING 240° E.T.N. ID No 137500 TO BE RELOCATED ONTO PROPOSED YOKE BRACKET AT 18.05m

PROPOSED EE 1No. 16-PORT ANTENNA AT 18.05m MEAN, BEARING 240° E.T.N. I.D.No. 535514 TO BE INSTALLED ONTO PROPOSED YOKE BRACKET

PROPOSED EE 1No. 5G ANTENNA AT 18.05m MEAN, BEARING 240° E.T.N. I.D. No.535526 TO BE INSTALLED ONTO PROPOSED YOKE BRACKET

EE 1No. 5502 1800/2100 RRU I.D.No. 481745 TO BE REMOVED

PROPOSED EE 1No. 4480 1800/2100 RRU I.D.No.535517 TO BE INSTALLED ON REAR OF PROPOSED ANTENNA SUPPORT POLE

PROPOSED EE 1No. 4419 2600 RRU I.D.No.535520 TO BE INSTALLED ON REAR OF PROPOSED ANTENNA SUPPORT POLE

H3G & EE 6No. LDF5-50 FEEDERS & 3No. HYBRID FIBRES/DC TO BE REUSED (SUBJECT TO TESTING). EE 6No. LDF5-50 FEEDERS TO BE REMOVED. PROPOSED EE 3No. SINGLE MODE TRUNK & 3No. POWER ONLY TRUNK TO BE INSTALLED

PROPOSED 2No. TRIPLE YOKE BRACKETS C/W 2No. Ø60.3x5mm, 2.5m LONG SUPPORT POLES & 2No. STAND-OFF BRACKET C/W 2No. Ø60.3x5mm, 2.5m LONG SUPPORT POLES TO BE INSTALLED



NORTH (WEST END) ELEVATION
SCALE 1:200

FEINT DETAILS INDICATE LOCATIONS RESERVED FOR OTHER PROPOSALS WHICH MAY BE THE SUBJECT OF SEPARATE APPLICATIONS

©2020 Cellnex
All rights reserved. No part of this publication may be reproduced, stored in a retrieval system or transmitted in any form or by any means (Electronic, Mechanical, Photocopying, Recording or otherwise), without the prior written consent of the Company.

NOTES

PROJECT No. 238825

CELL No. 98509

BT SKYLINE No. TW0007

31	PROJ No 238825 PLANNING	05/10/21	WHP	WHP
30	PROJ No 212166 PLANNING AMEND	03/08/21	DAL	DAL
29	PROJ No 229637 AS BUILT	09/06/21	WHP	MF
28	PROJ No 212166 Planning Amend	21/05/21	DAL	DAL
27	PROJ No 212166 Planning Amend	12/03/21	DAL	DAL
ISS	REVISION	DATE	DRN	APP

CELLNEX UK
R+, 4TH FLOOR, 2 BLA GRAVE STREET, READING, RG1 1AZ
Tel. 020 4526 8553

SITE No 168646
SKYPORT TE
NEWALL ROAD
LONDON HEATHROW AIRPORT
HILLINGDON
GREATER LONDON 3
TW6 2RT

NGR TQ 08770 76810

OS GRID 508770 176810

TITLE
ELEVATION
PROPOSED
H3G & EE LTD

SCALE 1:200

DRAWN	IM	19/08/11
APPROVED	WHP	05/10/21

DRG No. 168646-02-150-MD031

Sheet 1 of 2

Rev 31

NOTES

PROJECT No. 238825

CELL No. 98509

BT SKYLINE No.
TW0007

31	PROJ No 238825 PLANNING	05/10/21	WHP	WHP
30	PROJ No 212166 PLANNING AMEND	03/08/21	DAL	DAL
29	PROJ No 229637 AS BUILT	09/06/21	WHP	MF
28	PROJ No 212166 Planning Amend	21/05/21	DAL	DAL
27	PROJ No 212166 Planning Amend	12/03/21	DAL	DAL
ISS	REVISION	DATE	DRN	APP



CELLNEX UK
R+, 4TH FLOOR, 2 BLA GRAVE STREET, READING, RG1 1AZ
Tel. 020 4526 8553

SITE No 168646

SKYPORT TE
NEWALL ROAD
LONDON HEATHROW AIRPORT
HILLINGDON
GREATER LONDON 3
TW6 2RT

NGR TQ 08770 76810

OS GRID 508770 176810

TITLE
ELEVATION
PROPOSED
H3G & EE LTD

SCALE 1:200

DRAWN IM 19/08/11

APPROVED WHP 05/10/21

DRG No. 168646-02-150-MD031 Sheet 2 of 2 Rev 31

EE 3No. BOB's I.D No's. 681857 ON BOB LADDER TO BE REMOVED

PROPOSED EE 3No. BOB's I.D No's. 707611 ON BOB LADDER TO BE INSTALLED

EE 1No. BTS 3900L CABINET I.D. No. 677903 TO BE REMOVED

PROPOSED EE 1No. AIRI CABINET I.D. No. 707574 TO BE INSTALLED

EE 1No. 14-PORT ANTENNA AT 18.65m MEAN, BEARING 0° E.T.N. I.D.No. 481737 TO BE REMOVED

H3G & EE1No. 2-PORT ANTENNA AT 18.5m MEAN BEARING 0° E.T.N. I.D.No. 137498 TO BE RELOCATED ONTO PROPOSED YOKE BRACKET

H3G & EE 1No. 2-PORT ANTENNA AT 18.5m MEAN BEARING 90° E.T.N. I.D.No. 137499 TO BE RELOCATED ONTO PROPOSED YOKE BRACKET

PROPOSED EE 1No. 16-PORT ANTENNA AT 18.6m MEAN, BEARING 0° E.T.N. I.D.No. 535512 TO BE INSTALLED ON PROPOSED YOKE BRACKET

PROPOSED EE 1No. 5G ANTENNA AT 18.6m MEAN, BEARING 0° E.T.N. I.D. No. 535524 TO BE INSTALLED ON PROPOSED YOKE BRACKET

EE 1No. 5502 1800/2100 RRU I.D.No. 481746 TO BE REMOVED

PROPOSED EE 1No. 4480 1800/2100 RRU I.D.No.535515 TO BE INSTALLED ON REAR OF PROPOSED ANTENNA SUPPORT POLE

PROPOSED EE 1No. 4419 2600 RRU I.D.No. 535518 TO BE INSTALLED ON REAR OF PROPOSED ANTENNA SUPPORT POLE

EE 1No. MK1 BOB I.D No's. 481749 TO BE REMOVED

PROPOSED EE 1No. MK2 BOB I.D. No. 535541 TO BE INSTALLED ON EXISTING SUPPORT POLE

EE 1No. 14-PORT ANTENNA AT 18.65m MEAN, BEARING 0° E.T.N. I.D.No. 481737 TO BE REMOVED

H3G & EE1No. 2-PORT ANTENNA AT 18.5m MEAN BEARING 0° E.T.N. I.D.No. 137498 TO BE RELOCATED ONTO PROPOSED YOKE BRACKET

H3G & EE 1No. 2-PORT ANTENNA AT 18.5m MEAN BEARING 90° E.T.N. I.D.No. 137499 TO BE RELOCATED ONTO PROPOSED YOKE BRACKET

PROPOSED EE 1No. 16-PORT ANTENNA AT 18.6m MEAN, BEARING 0° E.T.N. I.D.No. 535512 TO BE INSTALLED ON PROPOSED YOKE BRACKET

PROPOSED EE 1No. 5G ANTENNA AT 18.6m MEAN, BEARING 0° E.T.N. I.D. No. 535524 TO BE INSTALLED ON PROPOSED YOKE BRACKET

EE 1No. 5502 1800/2100 RRU I.D.No. 481746 TO BE REMOVED

PROPOSED EE 1No. 4480 1800/2100 RRU I.D.No.535515 TO BE INSTALLED ON REAR OF PROPOSED ANTENNA SUPPORT POLE

PROPOSED EE 1No. 4419 2600 RRU I.D.No. 535518 TO BE INSTALLED ON REAR OF PROPOSED ANTENNA SUPPORT POLE

EE 1No. MK1 BOB I.D No's. 481749 TO BE REMOVED

PROPOSED EE 1No. MK2 BOB I.D. No. 535541 TO BE INSTALLED ON EXISTING SUPPORT POLE

PROPOSED 100 WIDE COVERED & PAINTED POWER CABLE TRAY FIXED TO ELEVATION OF BUILDING

PROPOSED 100mm WIDE COVERED & PAINTED POWER CABLE TRAY TO PROPOSED CTIL CABINETS. EXACT ROUTE TBC

100 WIDE COVERED & PAINTED POWER CABLE TRAY FIXED TO ELEVATION OF BUILDING

METER CABINET 1 EE

ARQIVA 'CUTLER & HAMMER' MULTI-USER METER CABINET ON CONCRETE BASE

HIGH VOLTAGE TRANSFORMER

HOOPED ACCESS LADDER


18.6m 18.65m

17.05m

13.50m

H3G & EE 6No. LDF5-50 FEEDERS & 3No. HYBRID FIBRES/DC TO BE REUSED (SUBJECT TO TESTING). EE 6No. LDF5-50 FEEDERS TO BE REMOVED. PROPOSED EE 3No. SINGLE MODE TRUNK & 3No. POWER ONLY TRUNK TO BE INSTALLED

PROPOSED 2No. TRIPLE YOKE BRACKETS C/W 2No. Ø60.3x5mm, 2.5m LONG SUPPORT POLES & 2No. STAND-OFF BRACKET C/W 2No. Ø60.3x5mm, 2.5m LONG SUPPORT POLES TO BE INSTALLED

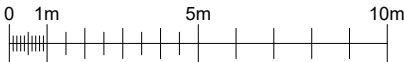

NORTH (EAST END) ELEVATION
SCALE 1:200

FEINT DETAILS INDICATE LOCATIONS RESERVED FOR OTHER PROPOSALS WHICH MAY BE THE SUBJECT OF SEPARATE APPLICATIONS



©2020 Cellnex
All rights reserved. No part of this publication may be reproduced, stored in a retrieval system or transmitted in any form or by any means (Electronic, Mechanical, Photocopying, Recording or otherwise), without the prior written consent of the Company.

NOTES

PROJECT No. 238825

CELL No. 98509

BT SKYLINE No.
TW0007

31	PROJ No. 238825 PLANNING	05/10/21	WHP	WHP
30	PROJ No. 212166 PLANNING AMEND	03/08/21	DAL	DAL
29	PROJ No. 229637 AS BUILT	09/06/21	WHP	MF
28	PROJ No. 212166 Planning Amend	21/05/21	DAL	DAL
27	PROJ No. 212166 Planning Amend	12/03/21	DAL	DAL
ISS	REVISION	DATE	DRN	APP



CELLNEX UK
R+, 4TH FLOOR, 2 BLA GRAVE STREET, READING, RG1 1AZ
Tel. 020 4526 8553

SITE No. 168646

SKYPORT TE
NEWALL ROAD
LONDON HEATHROW AIRPORT
HILLINGDON
GREATER LONDON 3
TW6 2RT

NGR TQ 08770 76810

OS GRID 508770 176810

TITLE
ELEVATION
PROPOSED
H3G & EE LTD

SCALE 1:50


DRAWN IM 19/08/11

APPROVED WHP 05/10/21


DRG No. Sheet 1 of 1 Rev

168646-02-151-MD031 31


FEINT DETAILS INDICATE LOCATIONS
RESERVED FOR OTHER PROPOSALS
WHICH MAY BE THE SUBJECT OF
SEPARATE APPLICATIONS

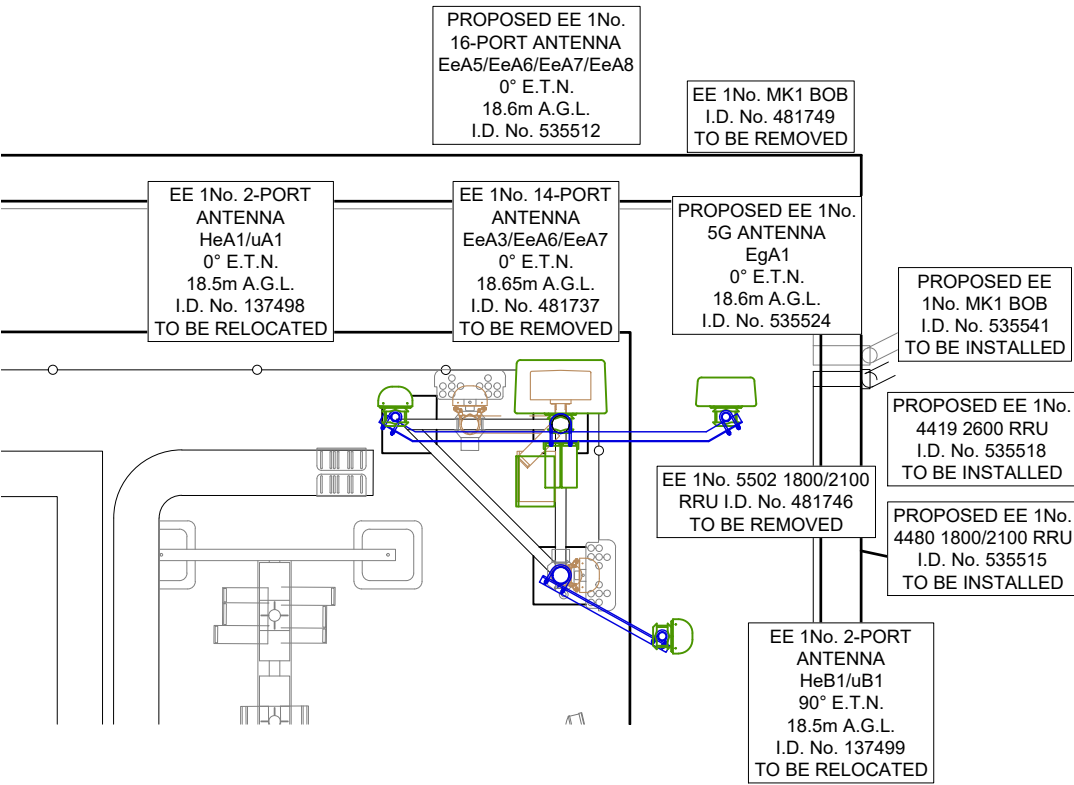

ANTENNA PLAN AT 18.65m
SCALE 1:50

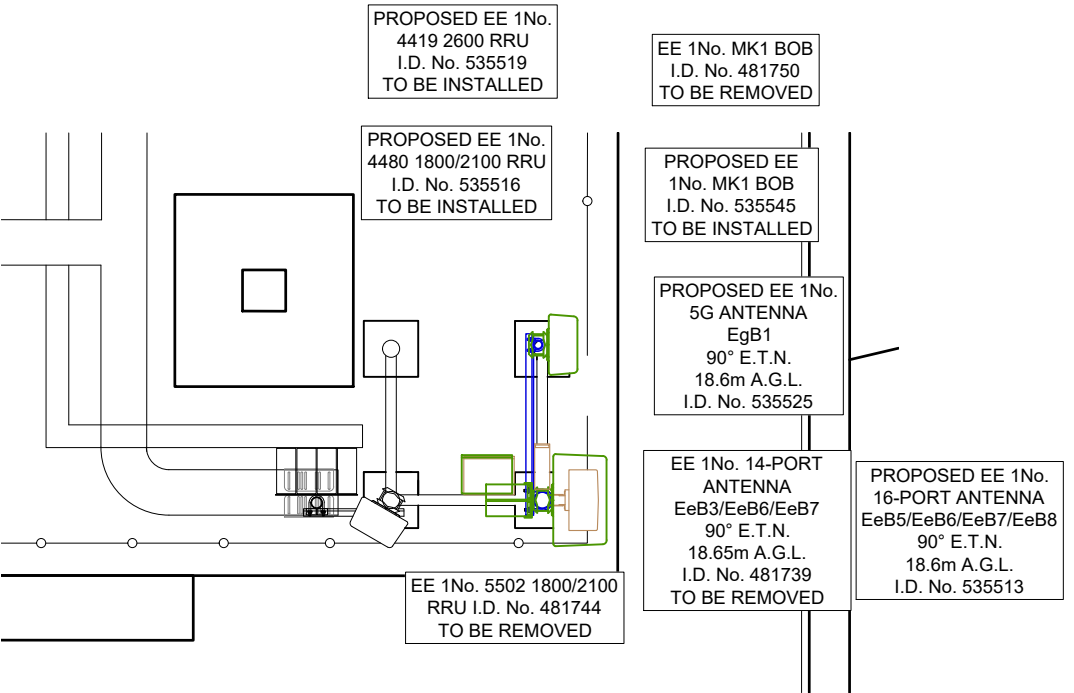

ANTENNA PLAN AT 18.65m
SCALE 1:50

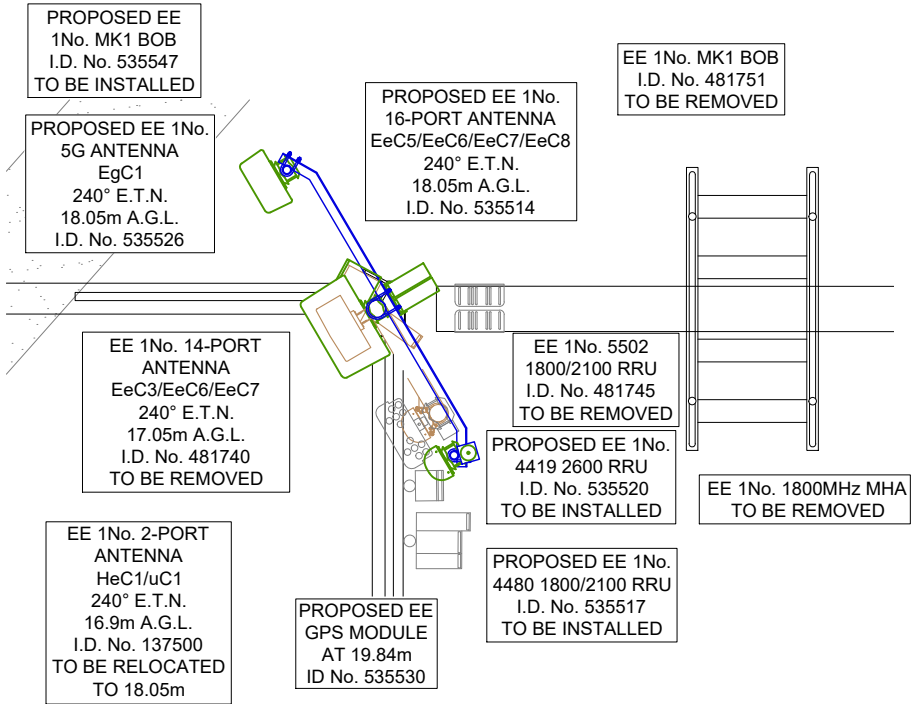

ANTENNA PLAN AT 18.05m
SCALE 1:50

