

A3

INDEX REVISION

DATE

THE THICKET




Scale 1:200

0 5 10 20m

KEY:

- APPLICATION BOUNDARY
- PROPOSED OUTBUILDING LOCATION (AS-BUILT)

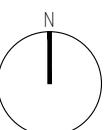

PROJECT
13 THE THICKET
WEST DRAYTON
UB7 8AS
TITLE
PROPOSED SITE BLOCK PLAN
AS-BUILT
STATUS
PLANNING
SCALE DATE DRAWN
1:200 08.01.26 KR
JOB/DRG NO REV
Y251203/P03 -

KOSMA RYBAK
KOSMA RYBAK LTD, 124 CITY ROAD, EC1V 2NX, LONDON
WWW.KOSMARYBAK.COM, M@KOSMARYBAK.COM, T:07719700256
THIS DRAWING IS © COPYRIGHT OF KOSMA RYBAK LTD
THIS DRAWING MAY BE SCALED OR COPIED FOR PLANNING
APPLICATION PURPOSES ONLY. DO NOT SCALE FOR ANY OTHER PURPOSE. USE FIGURED
DIMENSIONS ONLY. SUBJECT TO SITE SURVEY AND ALL NECESSARY CONSENTS. ALL
DIMENSIONS TO BE CHECKED BY USER AND ANY DISCREPANCIES, ERRORS OR OMISSIONS TO BE
REPORTED TO THE ARCHITECT BEFORE WORK COMMENCES. THIS DRAWING IS TO BE READ IN
CONJUNCTION WITH ALL OTHER RELEVANT MATERIALS.