



PAVEMENT



PROJECT			
I3 THE THICKET			
WEST DRAYTON			
UB7 8AS			
TITLE			
PROPOSED SITE PLAN			
AS-BUILT			
STATUS			
PLANNING			
SCALE	DATE	DRAWN	
1:100	08.01.26	KR	
JOB/DRG NO.	REV		
Y251203/P04	-		

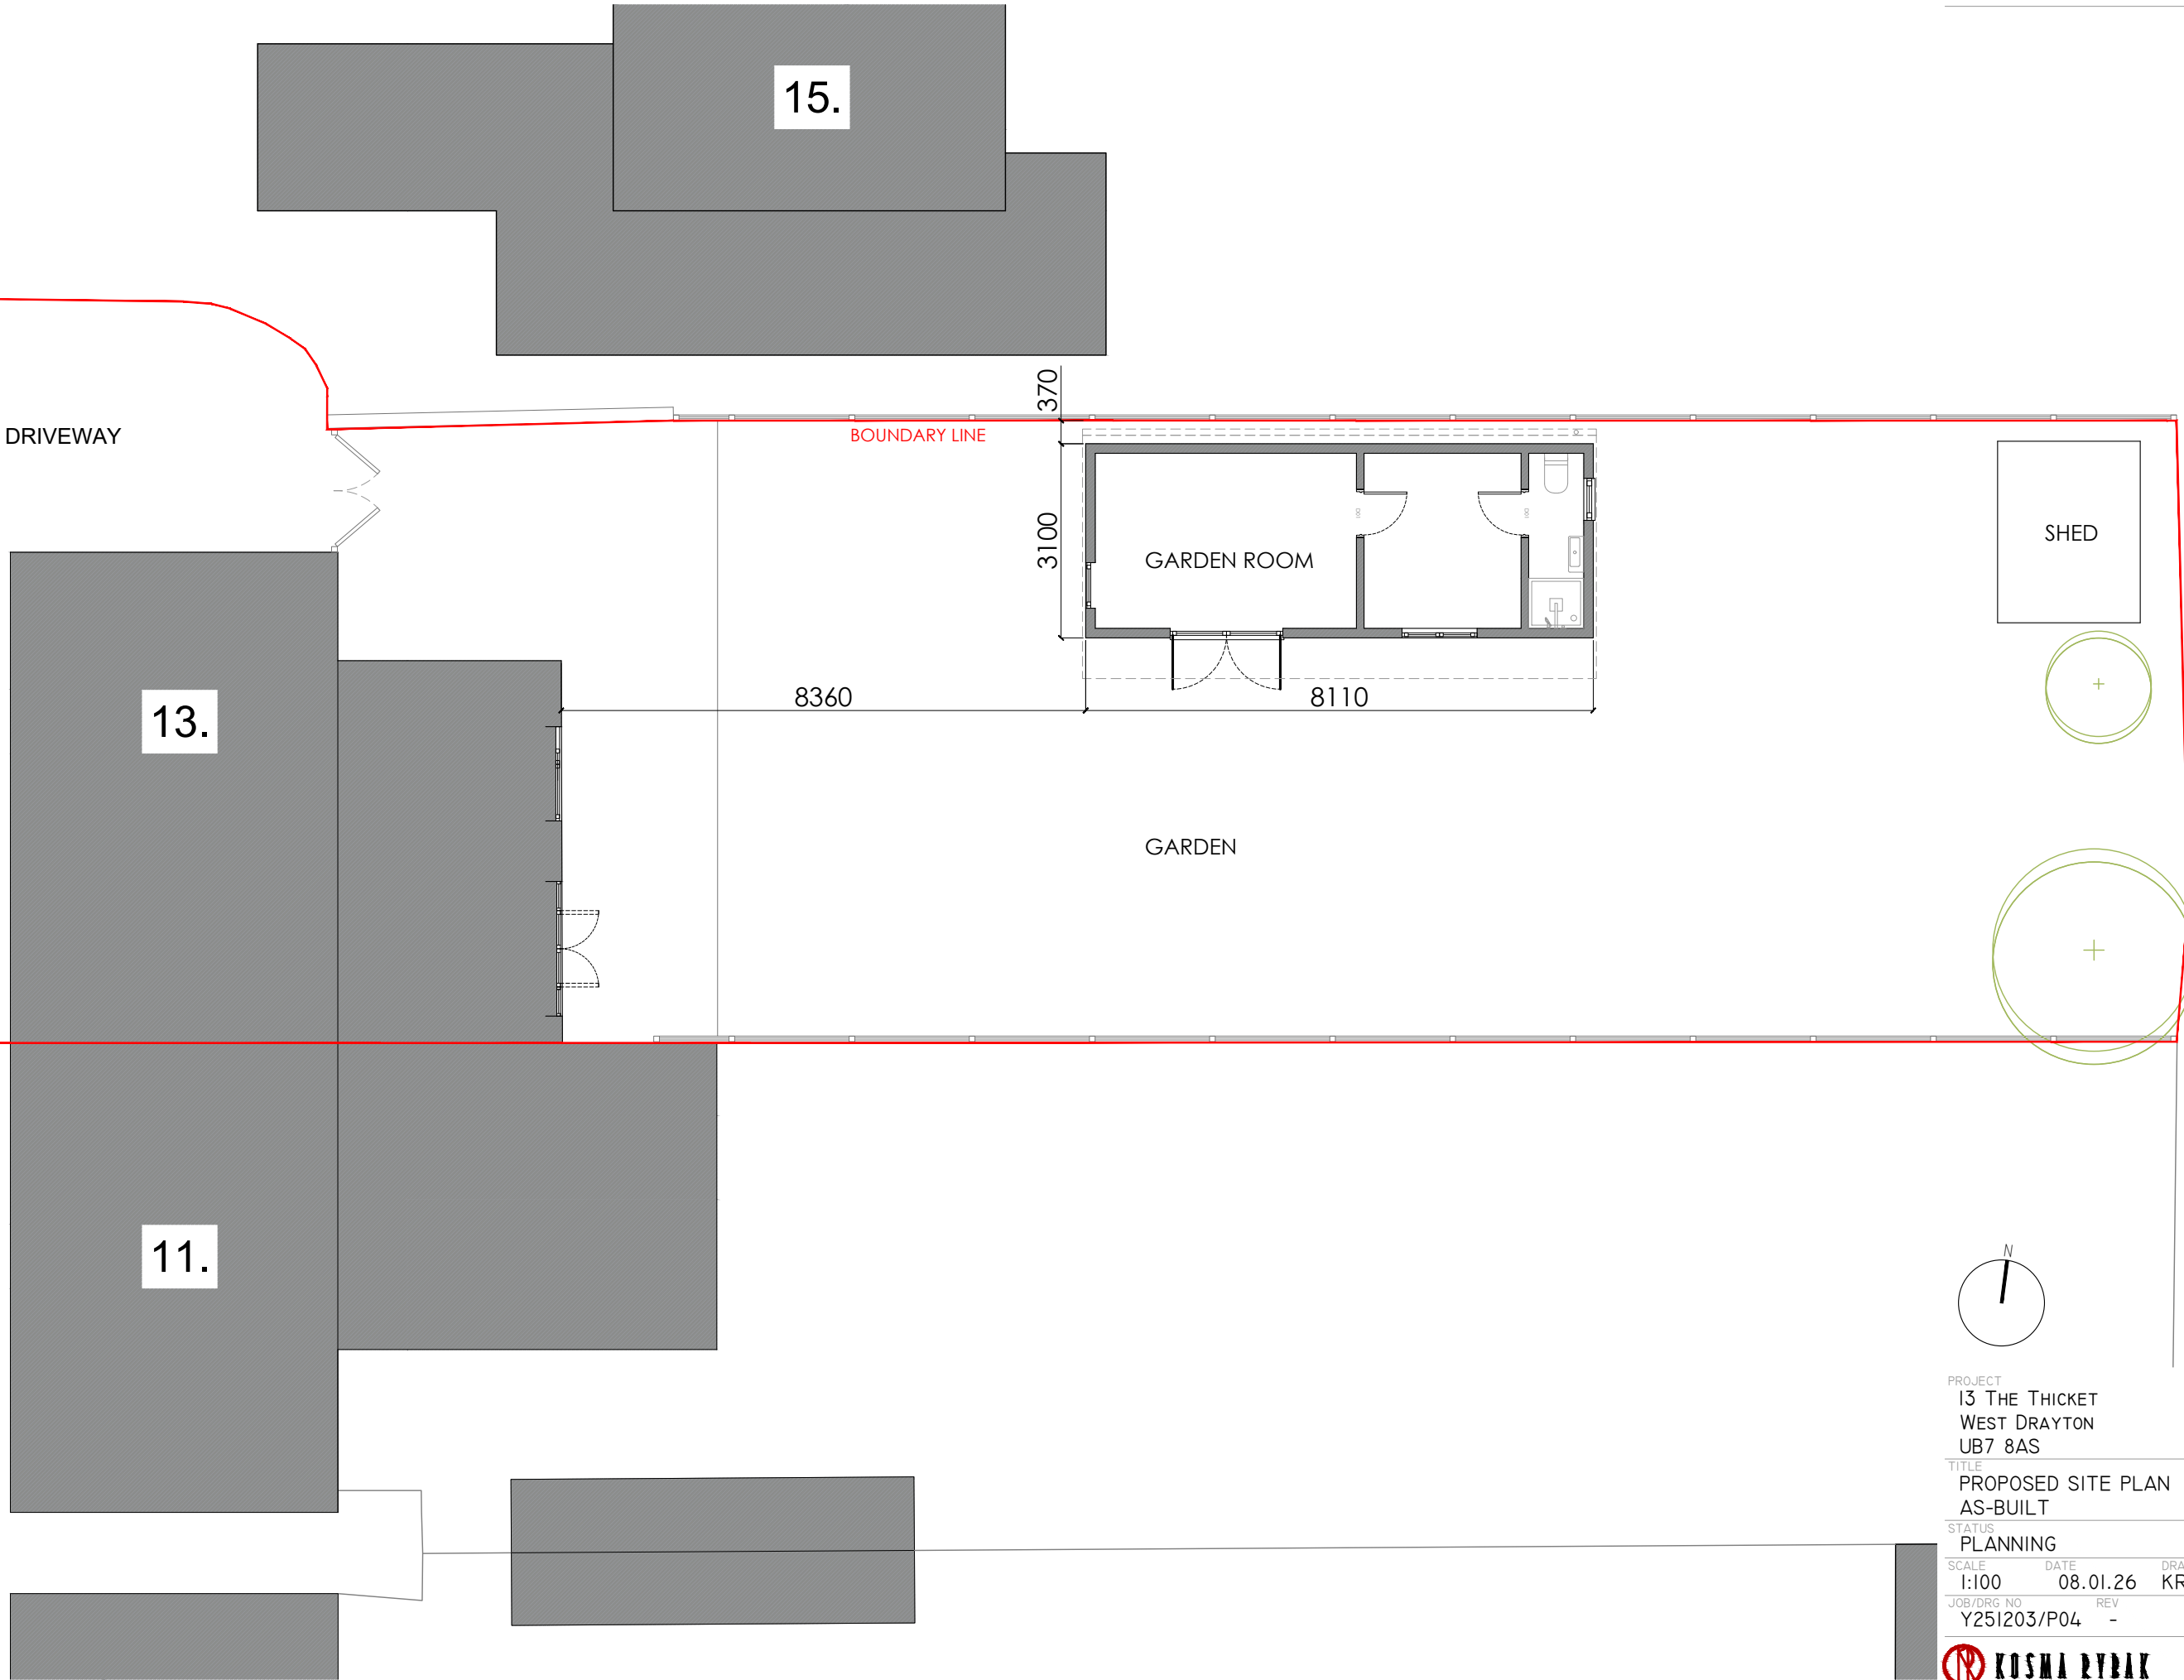

KOSMA RYBAK LTD.

124 CITY ROAD

EC1V 2NX

LONDON

WWW.KOSMARYBAK.COM

M@KOSMARYBAK.COM

T:07719700256

THIS DRAWING IS © COPYRIGHT OF KOSMA RYBAK LTD
THIS DRAWING MAY BE SCALED OR CROSS REFERENCED TO THE SCALE BAR FOR PLANNING APPLICATION PURPOSES ONLY. DO NOT SCALE FOR ANY OTHER PURPOSE. USE FIGURED DIMENSIONS ONLY. SUBJECT TO SITE SURVEY AND ALL NECESSARY CONSENTS. ALL DIMENSIONS TO BE CHECKED BY USER AND ANY DISCREPANCIES, ERRORS OR OMISSIONS TO BE REPORTED TO THE ARCHITECT BEFORE WORK COMMENCES. THIS DRAWING IS TO BE READ IN CONJUNCTION WITH ALL OTHER RELEVANT MATERIALS.

