




BEFORE BUILT  
GROUND FLOOR PLAN  
SCALE:-1:100

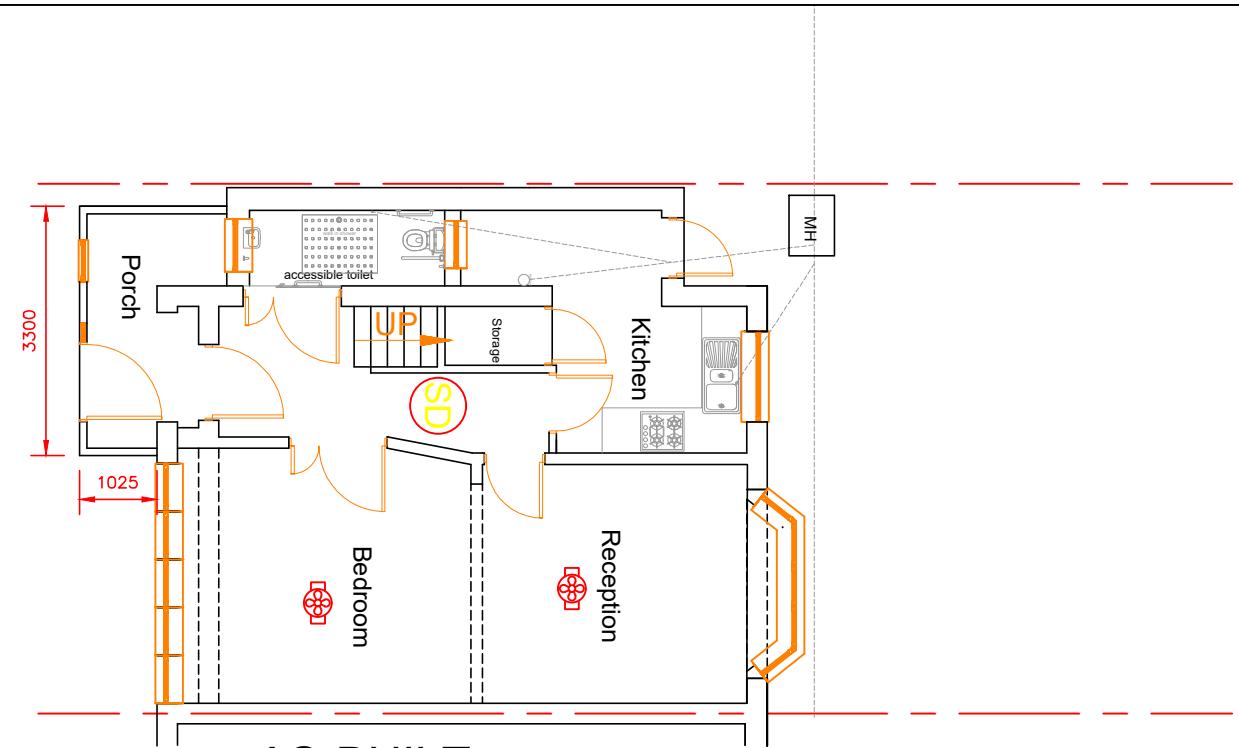

AS-BUILT  
GROUND FLOOR PLAN  
SCALE:-1:100

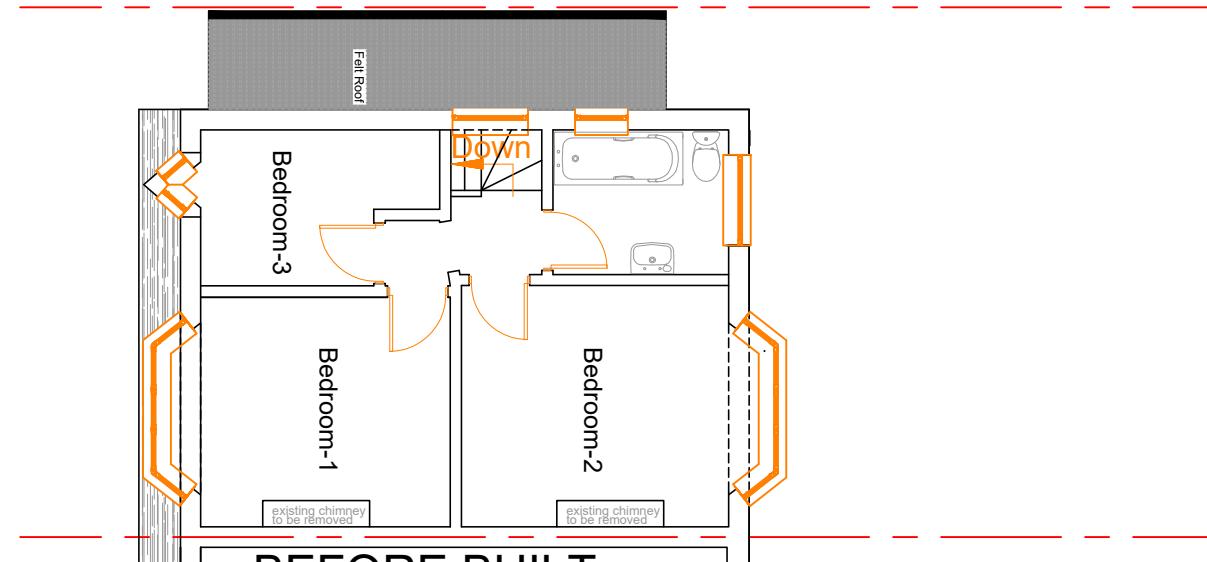

BEFORE BUILT  
FIRST FLOOR PLAN  
SCALE:-1:100

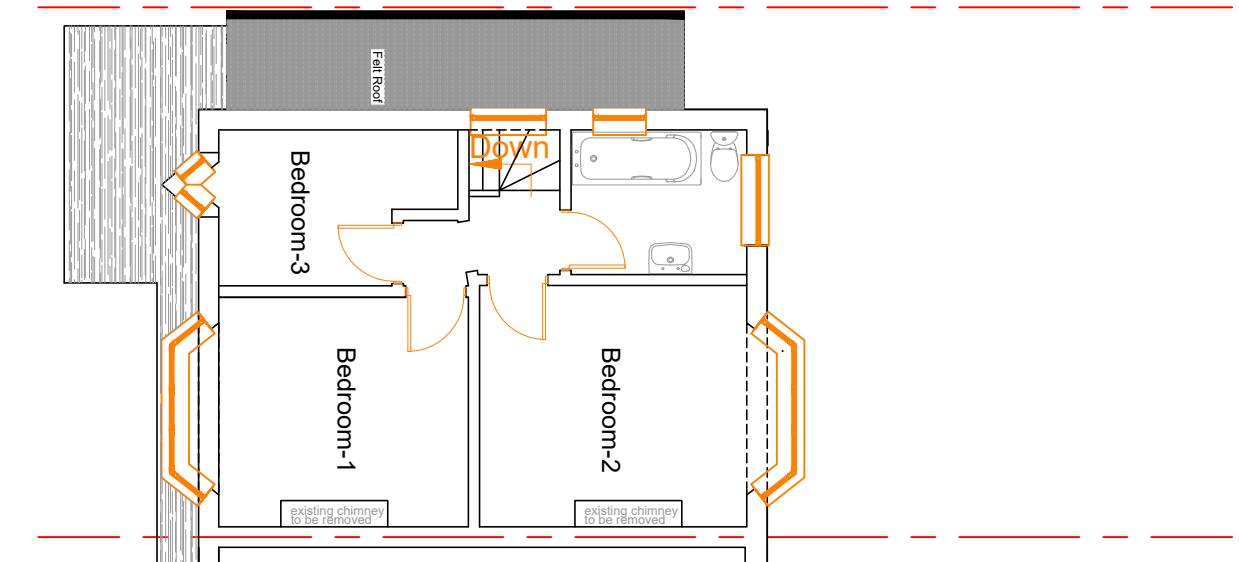

AS-BUILT  
FIRST FLOOR PLAN  
SCALE:-1:100

SCALE  
BAR  
1:100 0 1 2 3 4 5m

Client:-Mr.Ashokkumar Kugathasan

Drawing no:-56FA

Revision-A

Checked  
by:S.E

Title:- Proposed single storey front porch  
extension at No:56 Diamond Road,  
Ruislip, HA4 0PG.

Drawn by:-  
S.E 06/22

Scale:-1:100  
Org.size-A3