




**BEFORE BUILT FRONT ELEVATION**  
SCALE:-1:100

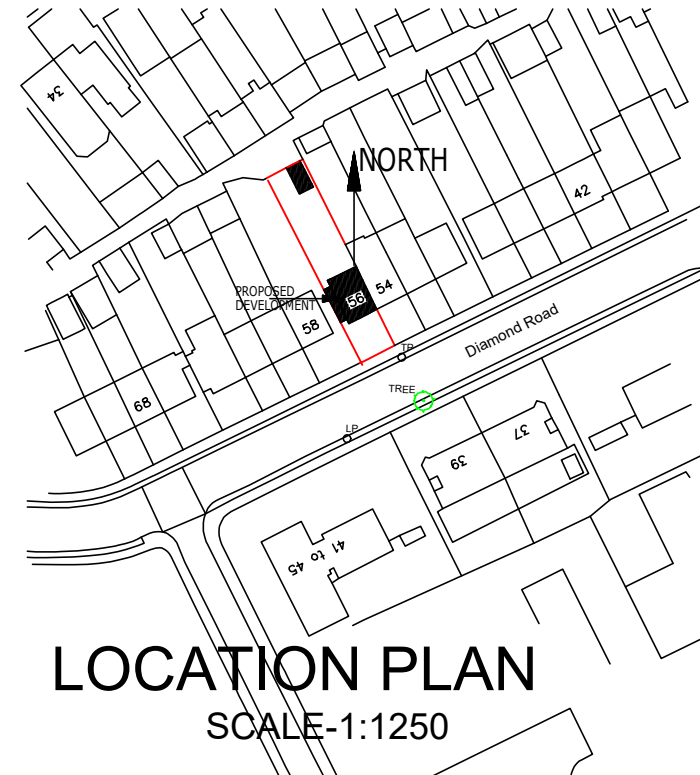

**LOCATION PLAN**  
SCALE-1:1250



**ASBUILT FRONT ELEVATION**  
SCALE:-1:100



|                                                                                               |                  |                                     |                |
|-----------------------------------------------------------------------------------------------|------------------|-------------------------------------|----------------|
| Client:-Mr.Ashokkumar Kugathan                                                                | Drawing no:-56FB | Revision-A                          | Checked by:S.E |
| Title:- Proposed single storey front porch extension at No:56 Diamond Road, Ruislip, HA4 0PG. |                  | Drawn by:- S.E 06/22                |                |
|                                                                                               |                  | Scale:-1:100, 1:1250<br>Org.size-A3 |                |