




**BEFORE BUILT SIDE ELEVATION**  
From No-58 SCALE:-1:100

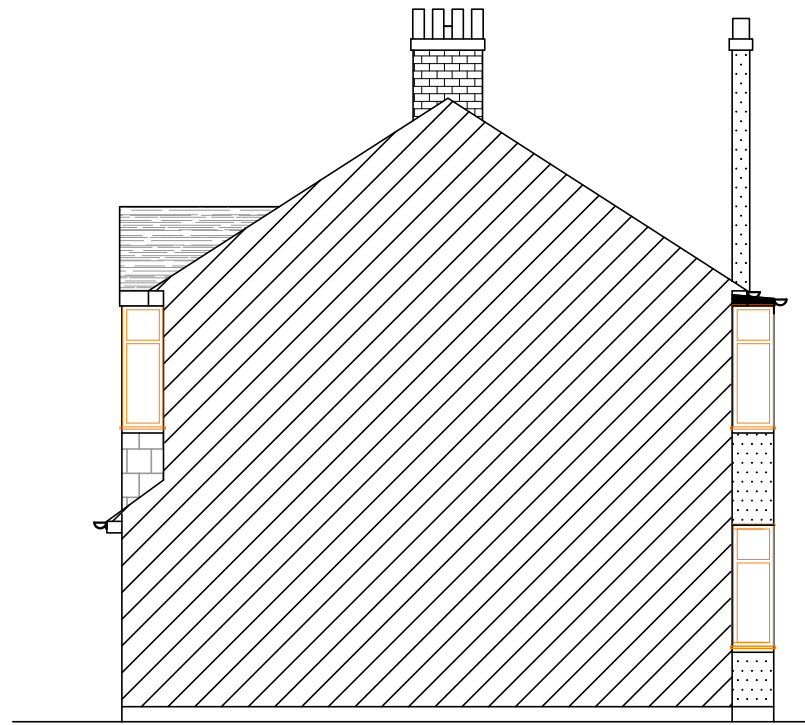


**BEFORE BUILT SIDE ELEVATION**  
From No-54 SCALE:-1:100

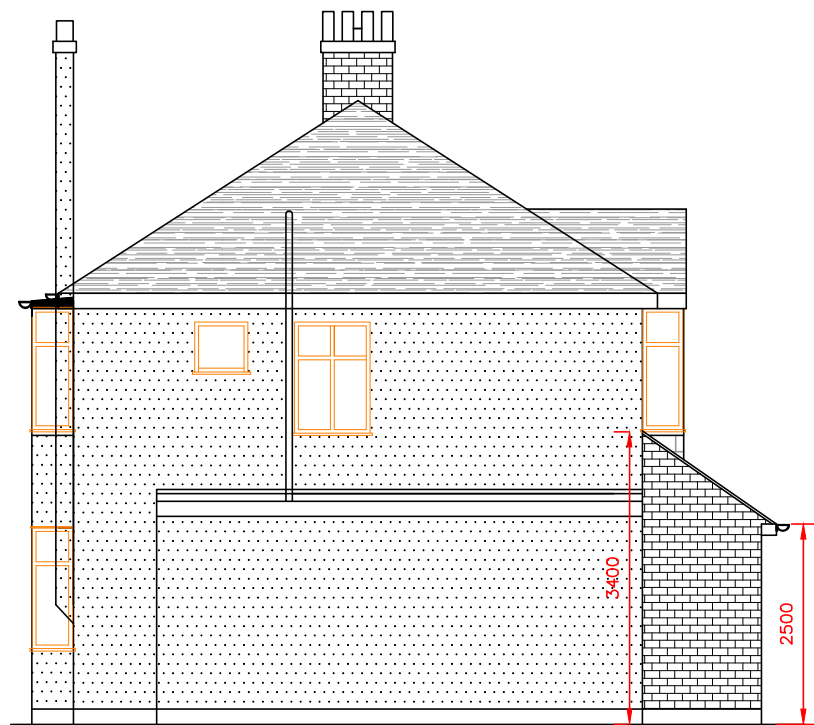

**AS-BUILT SIDE ELEVATION**  
From No-58 SCALE:-1:100

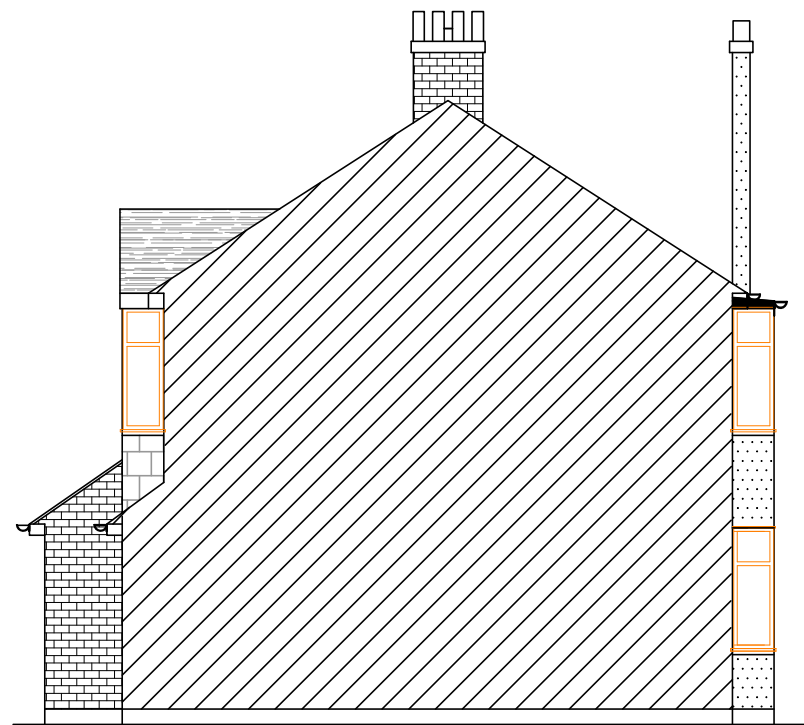

**AS-BUILT SIDE ELEVATION**  
From No-54 SCALE:-1:100

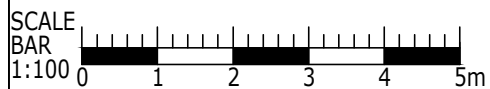

Client:-Mr.Ashokkumar Kugathanan

Drawing no:-56FC

Revision-A

Checked  
by:S.E

Title:- Proposed single storey front porch  
extension at No:56 Diamond Road,  
Ruislip, HA4 0PG.

Drawn by:-  
S.E 06/22

Scale:-1:100  
Org.size-A3