



**BEFORE BUILT
GROUND FLOOR PLAN**

SCALE:-1:100

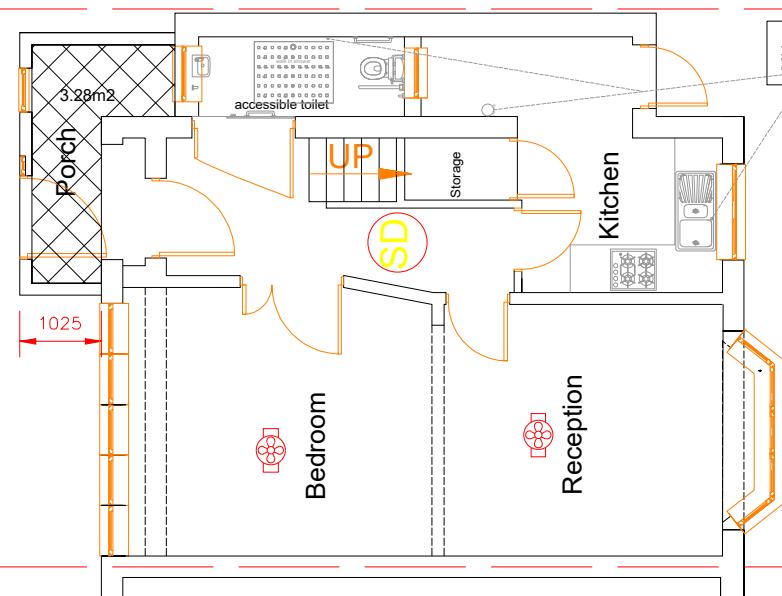


**AS-BUILT
GROUND FLOOR PLAN**

SCALE:-1:100

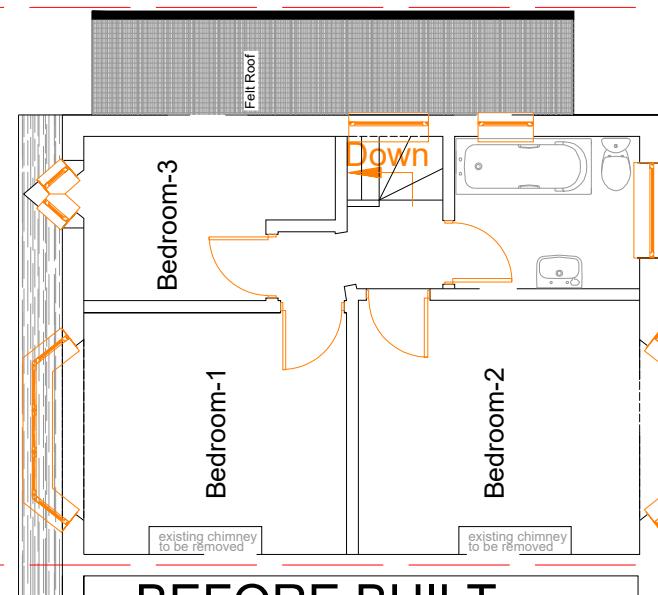

**BEFORE BUILT
FIRST FLOOR PLAN**

SCALE:-1:100

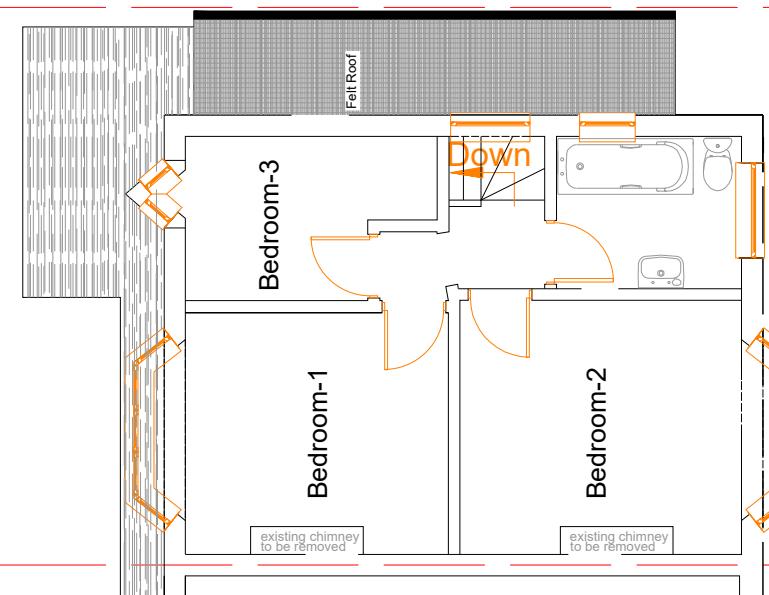

**AS-BUILT
FIRST FLOOR PLAN**

SCALE:-1:100

SCALE
BAR
1:100 0 1 2 3 4 5m

Client:-Mr.Ashokkumar Kugathasan

Drawing no:-56PA

Revision-A

Checked
by:S.K

Title:- Proposed single storey front porch
extension at No:56 Diamond Road,
Ruislip, HA4 0PG.

Drawn by:-
S.K:- 12/22

Scale:-1:100
Org.size-A3