




**BEFORE BUILT FRONT ELEVATION**

SCALE:-1:100

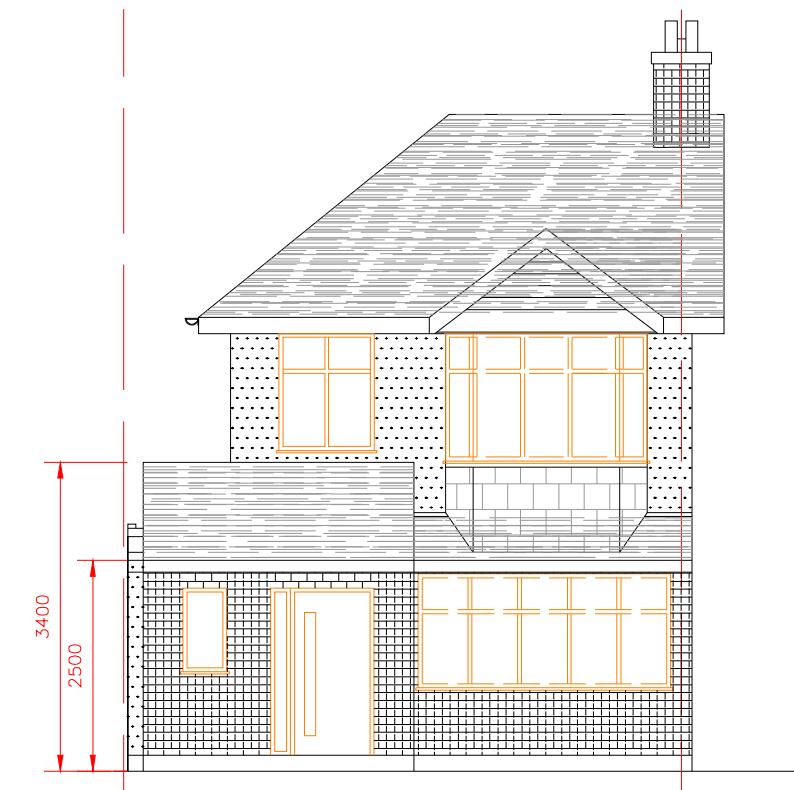

**AS BUILT FRONT ELEVATION**

SCALE:-1:100

SCALE  
BAR  
1:100 0 1 2 3 4 5m



**LOCATION PLAN**

SCALE-1:1250

Client:-Mr. Ashokkumar Kugathasan

Drawing no:-56PB

Revision-A

Checked  
by:S.K

Title:- Proposed single storey front porch  
extension at No:56 Diamond Road,  
Ruislip, HA4 0PG.

Drawn by:-  
S.K 12/22

Scale:-1:100, 1:1250  
Org.size-A3