





**BEFORE BUILT FRONT ELEVATION**  
SCALE:-1:100



**LOCATION PLAN**  
SCALE-1:1250

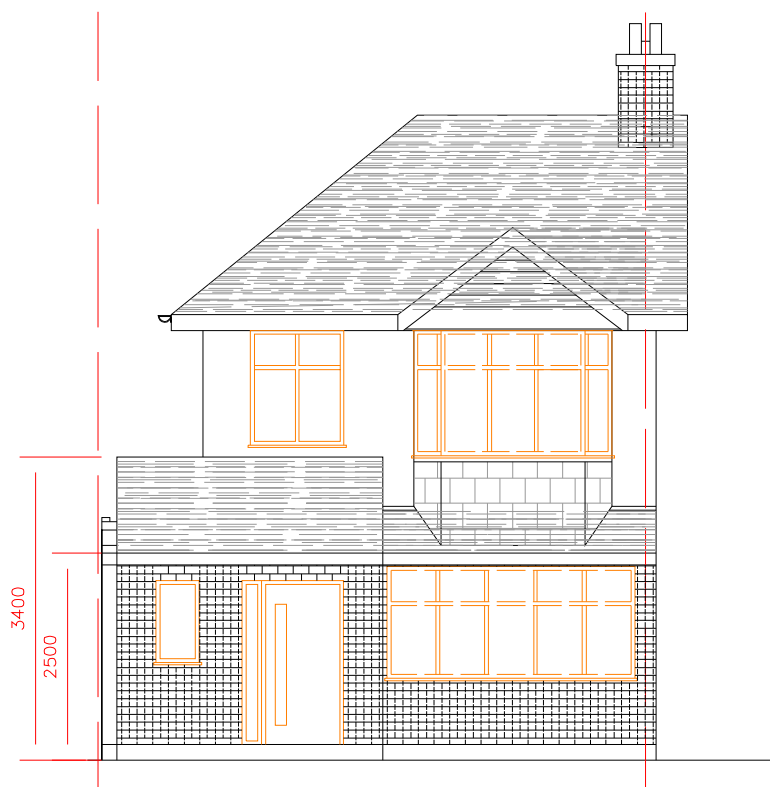

**ASBUILT FRONT ELEVATION**  
SCALE:-1:100

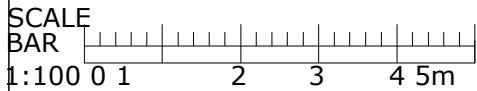

Client:-Mr.Ashokkumar Kugathasan      Drawing no:-56.1		Revision-A	Checked by:S.K
Title:- Proposed single storey front porch extension at No:56 Diamond Road, Ruislip, HA4 0PG.		Drawn by:- S.K 05/24	Scale:-1:100, 1:1250 Org.size-A3