




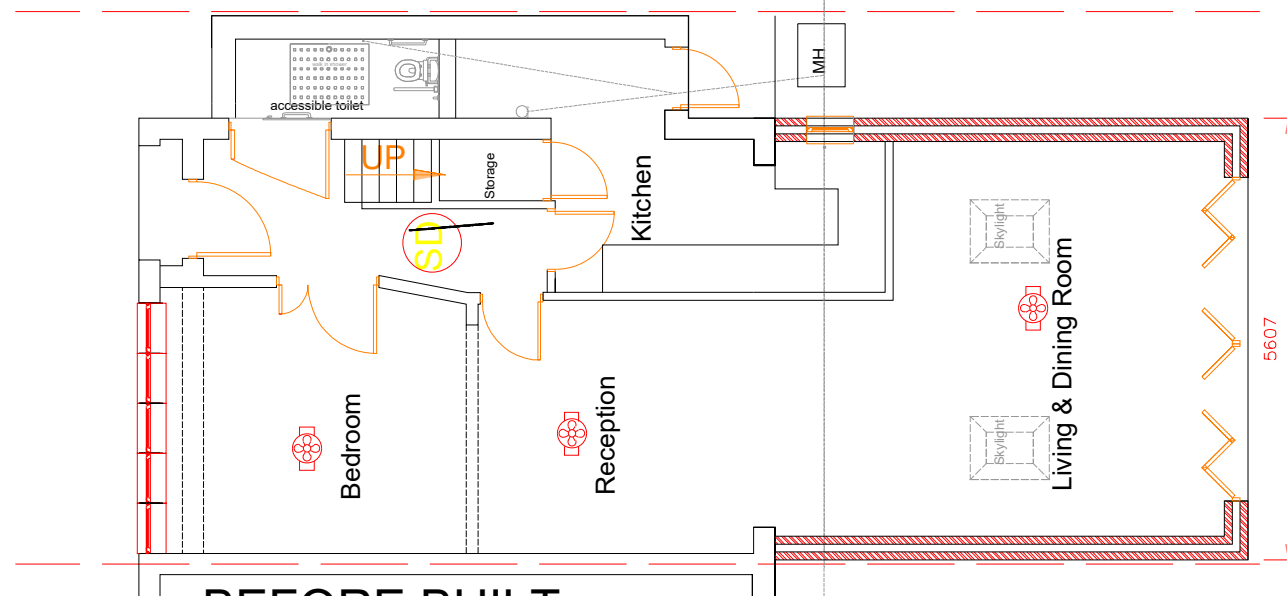


**BEFORE BUILT
GROUND FLOOR PLAN**
SCALE:-1:100

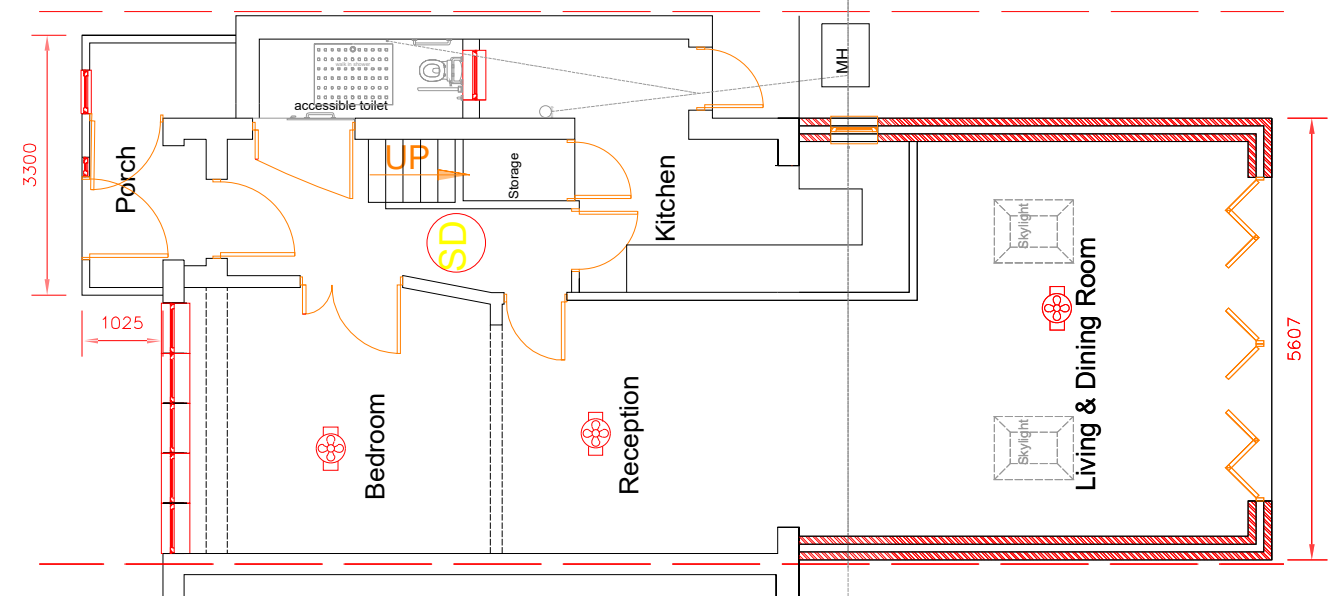


**AS-BUILT
GROUND FLOOR PLAN**
SCALE:-1:100

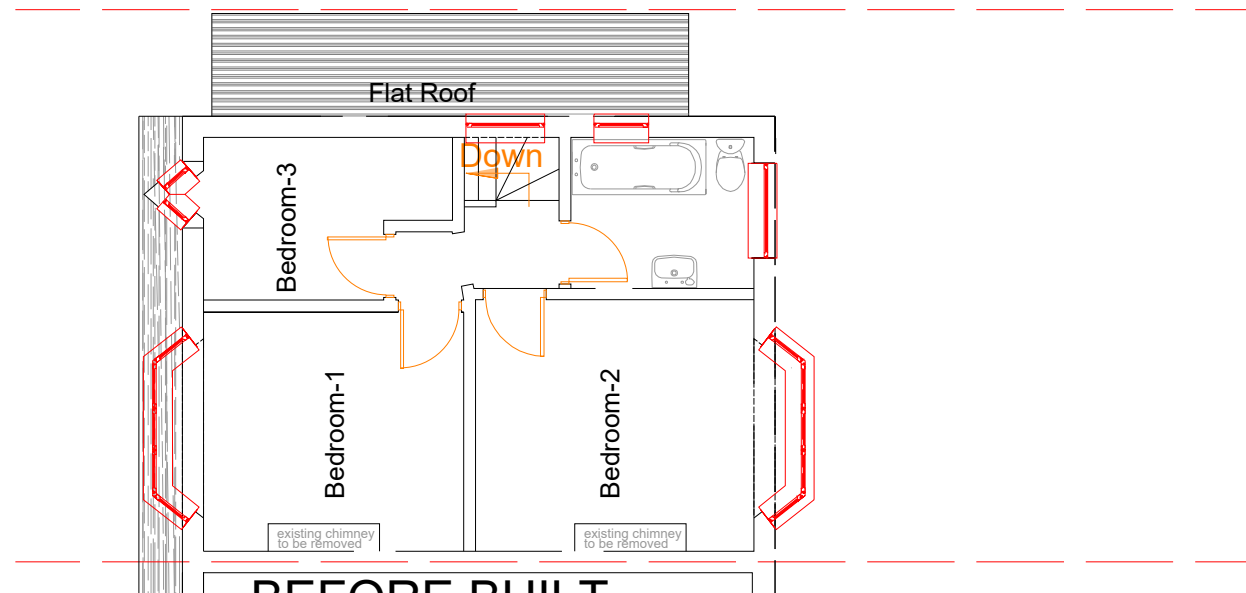

**BEFORE BUILT
FIRST FLOOR PLAN**
SCALE:-1:100

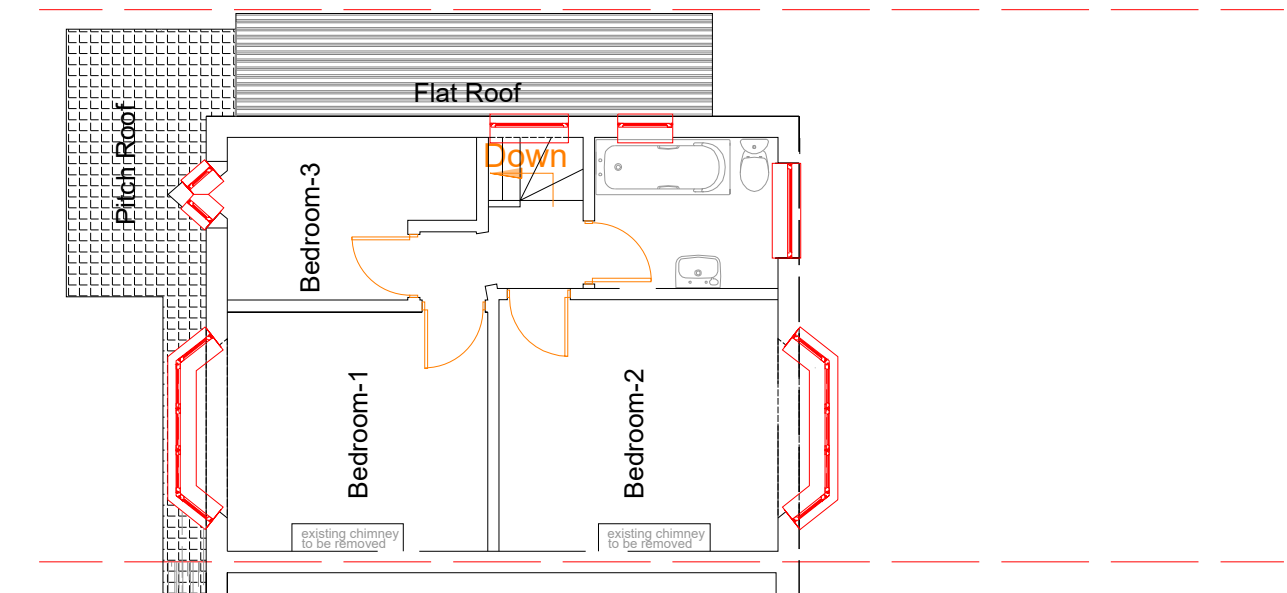

**AS-BUILT
FIRST FLOOR PLAN**
SCALE:-1:100

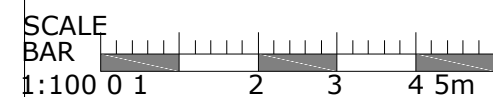

Client:-Mr.Ashokkumar Kugathanan

Drawing no:-56.2

Revision-A Checked
by:S.K

Title:- Proposed single storey front porch
extension at No:56 Diamond Road,
Ruislip, HA4 0PG.

Drawn by:-
S.K:- 05/24

Scale:-1:100
Org.size-A3