


UXBRIDGE ROAD

468-480

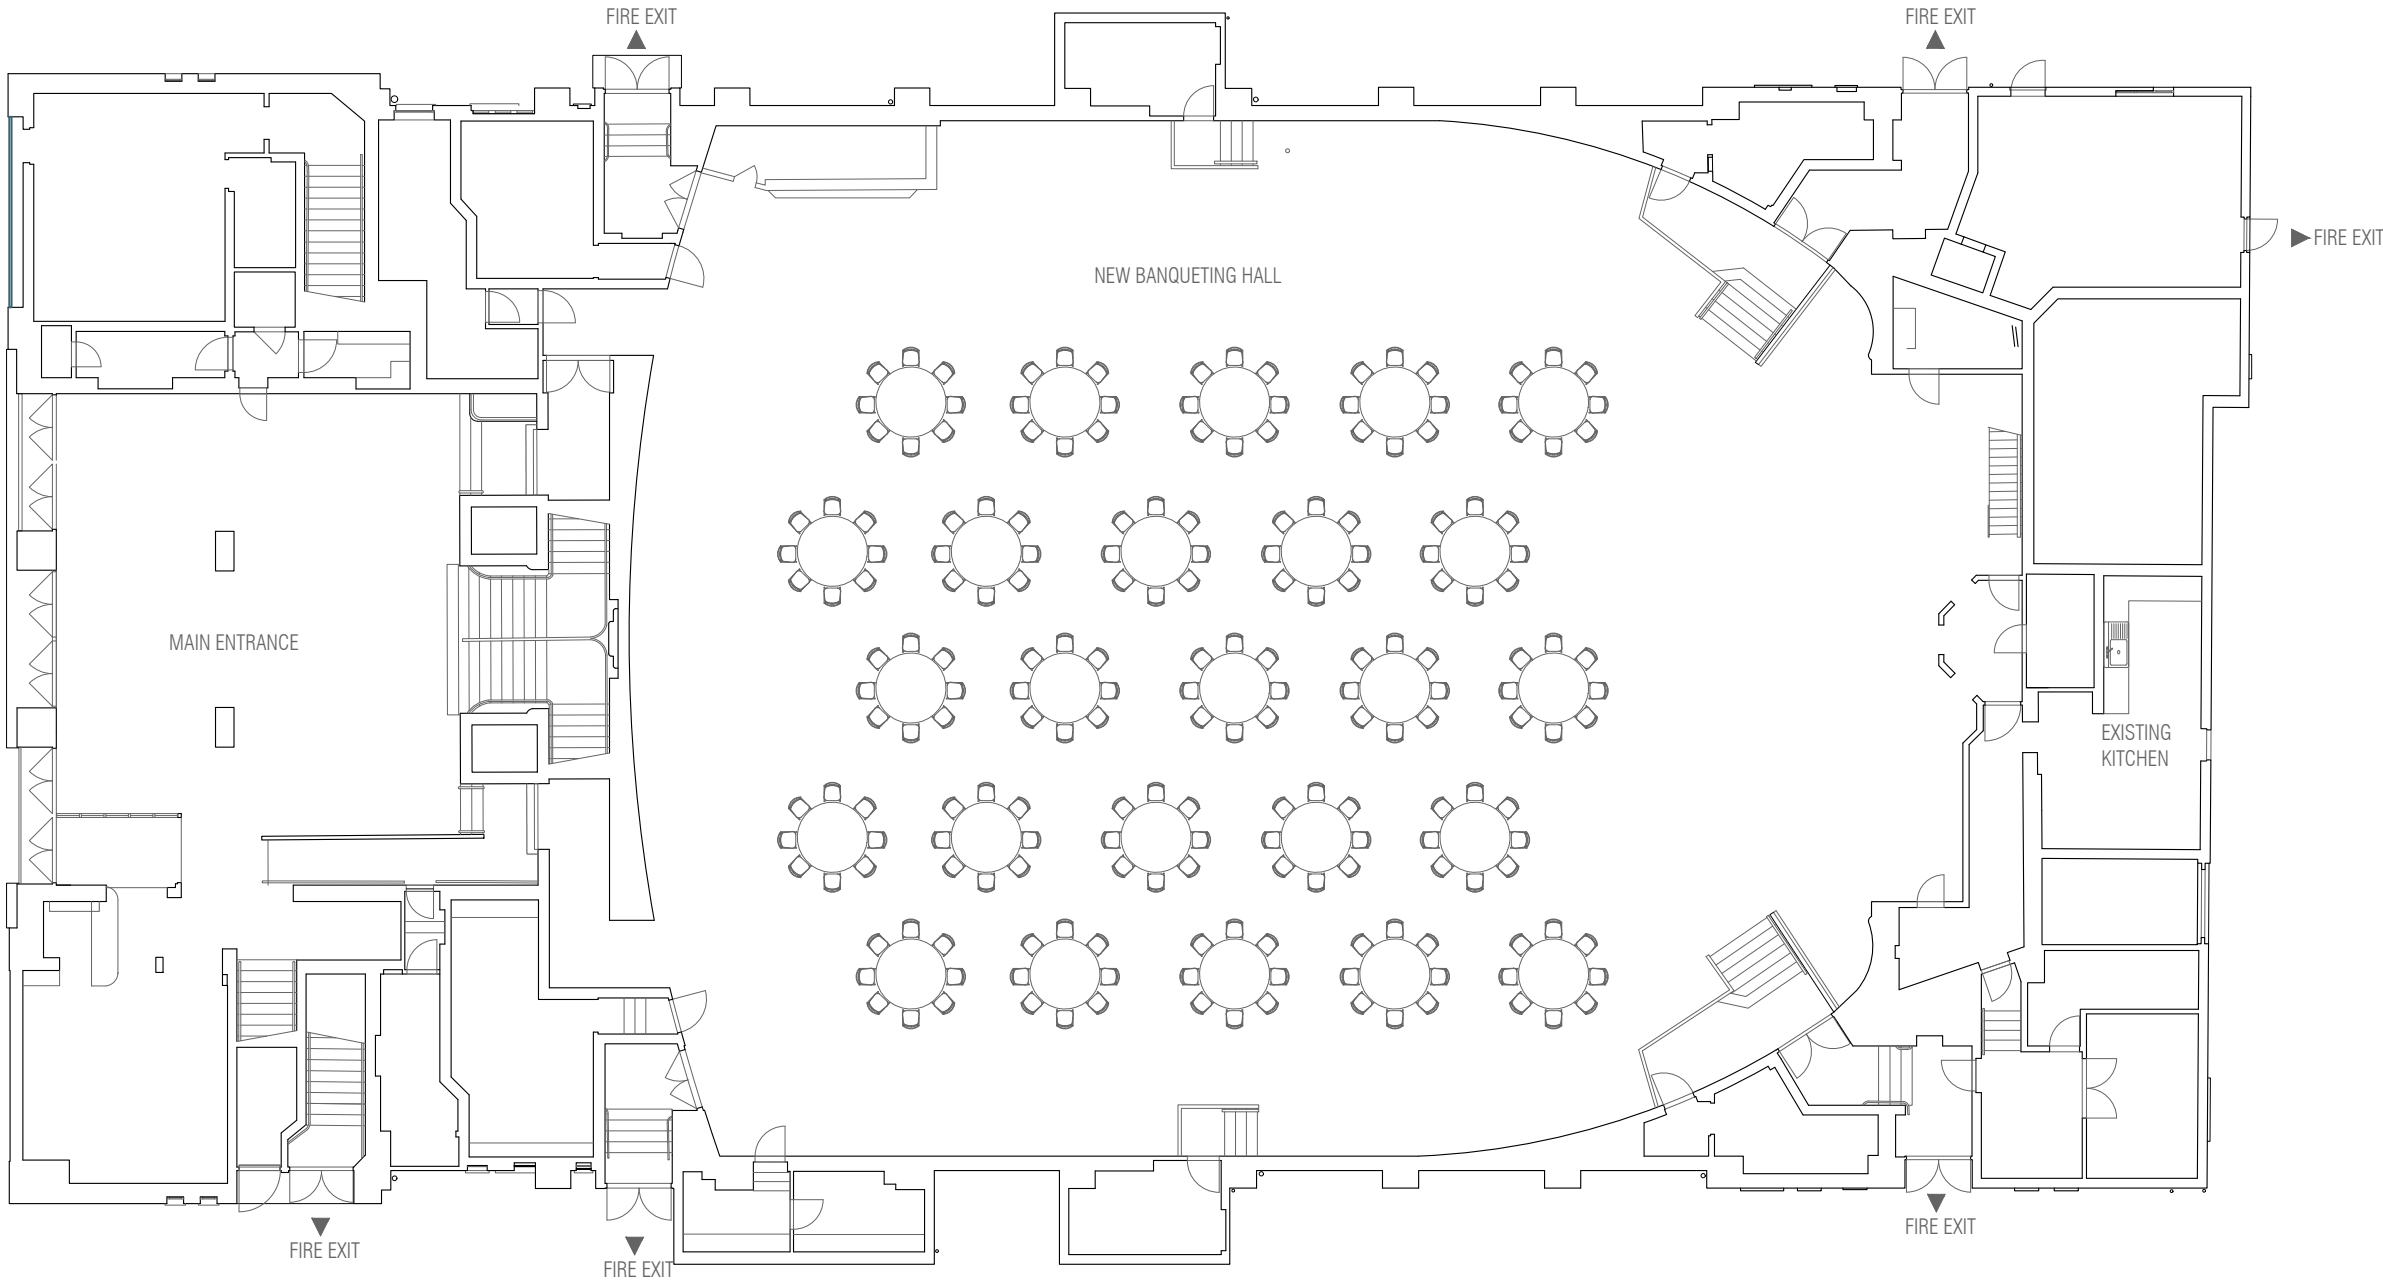

86-90 Paul Street, London EC2A 4NE
telephone: +44 (0) 203 095 4799
mobile: +44 (0) 7414032373
e-mail: info@lotusplans.co.uk
www.lotusplans.co.uk

REVISION NO.	DATE	COMMENTS
A	18/09/2023	Car & bicycle parking updated
B	18/06/2024	W.Cs & disabled refuge areas
C	21/08/2024	Stairlift added

CLIENT
468-480 Uxbridge Road, Hillingdon
UB4 0SD

SCALE
1:200 @ A3

DATE
May 2023

PROJECT
Proposed mezzanine rear extension and change of use from
Sui Generis (Bingo hall) to banqueting hall at
468-480 Uxbridge Road, Hillingdon
UB4 0SD

DRAWING TITLE
As built Ground floor plan

PROJECT NO.
LOTUS/743/23

DRAWING NO.
HIL-009C