

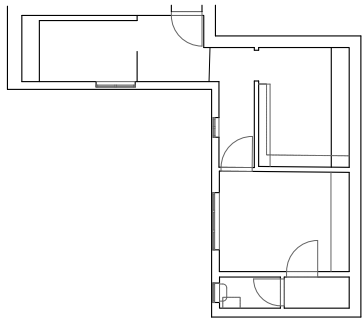


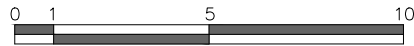

UXBRIDGE ROAD

468-480

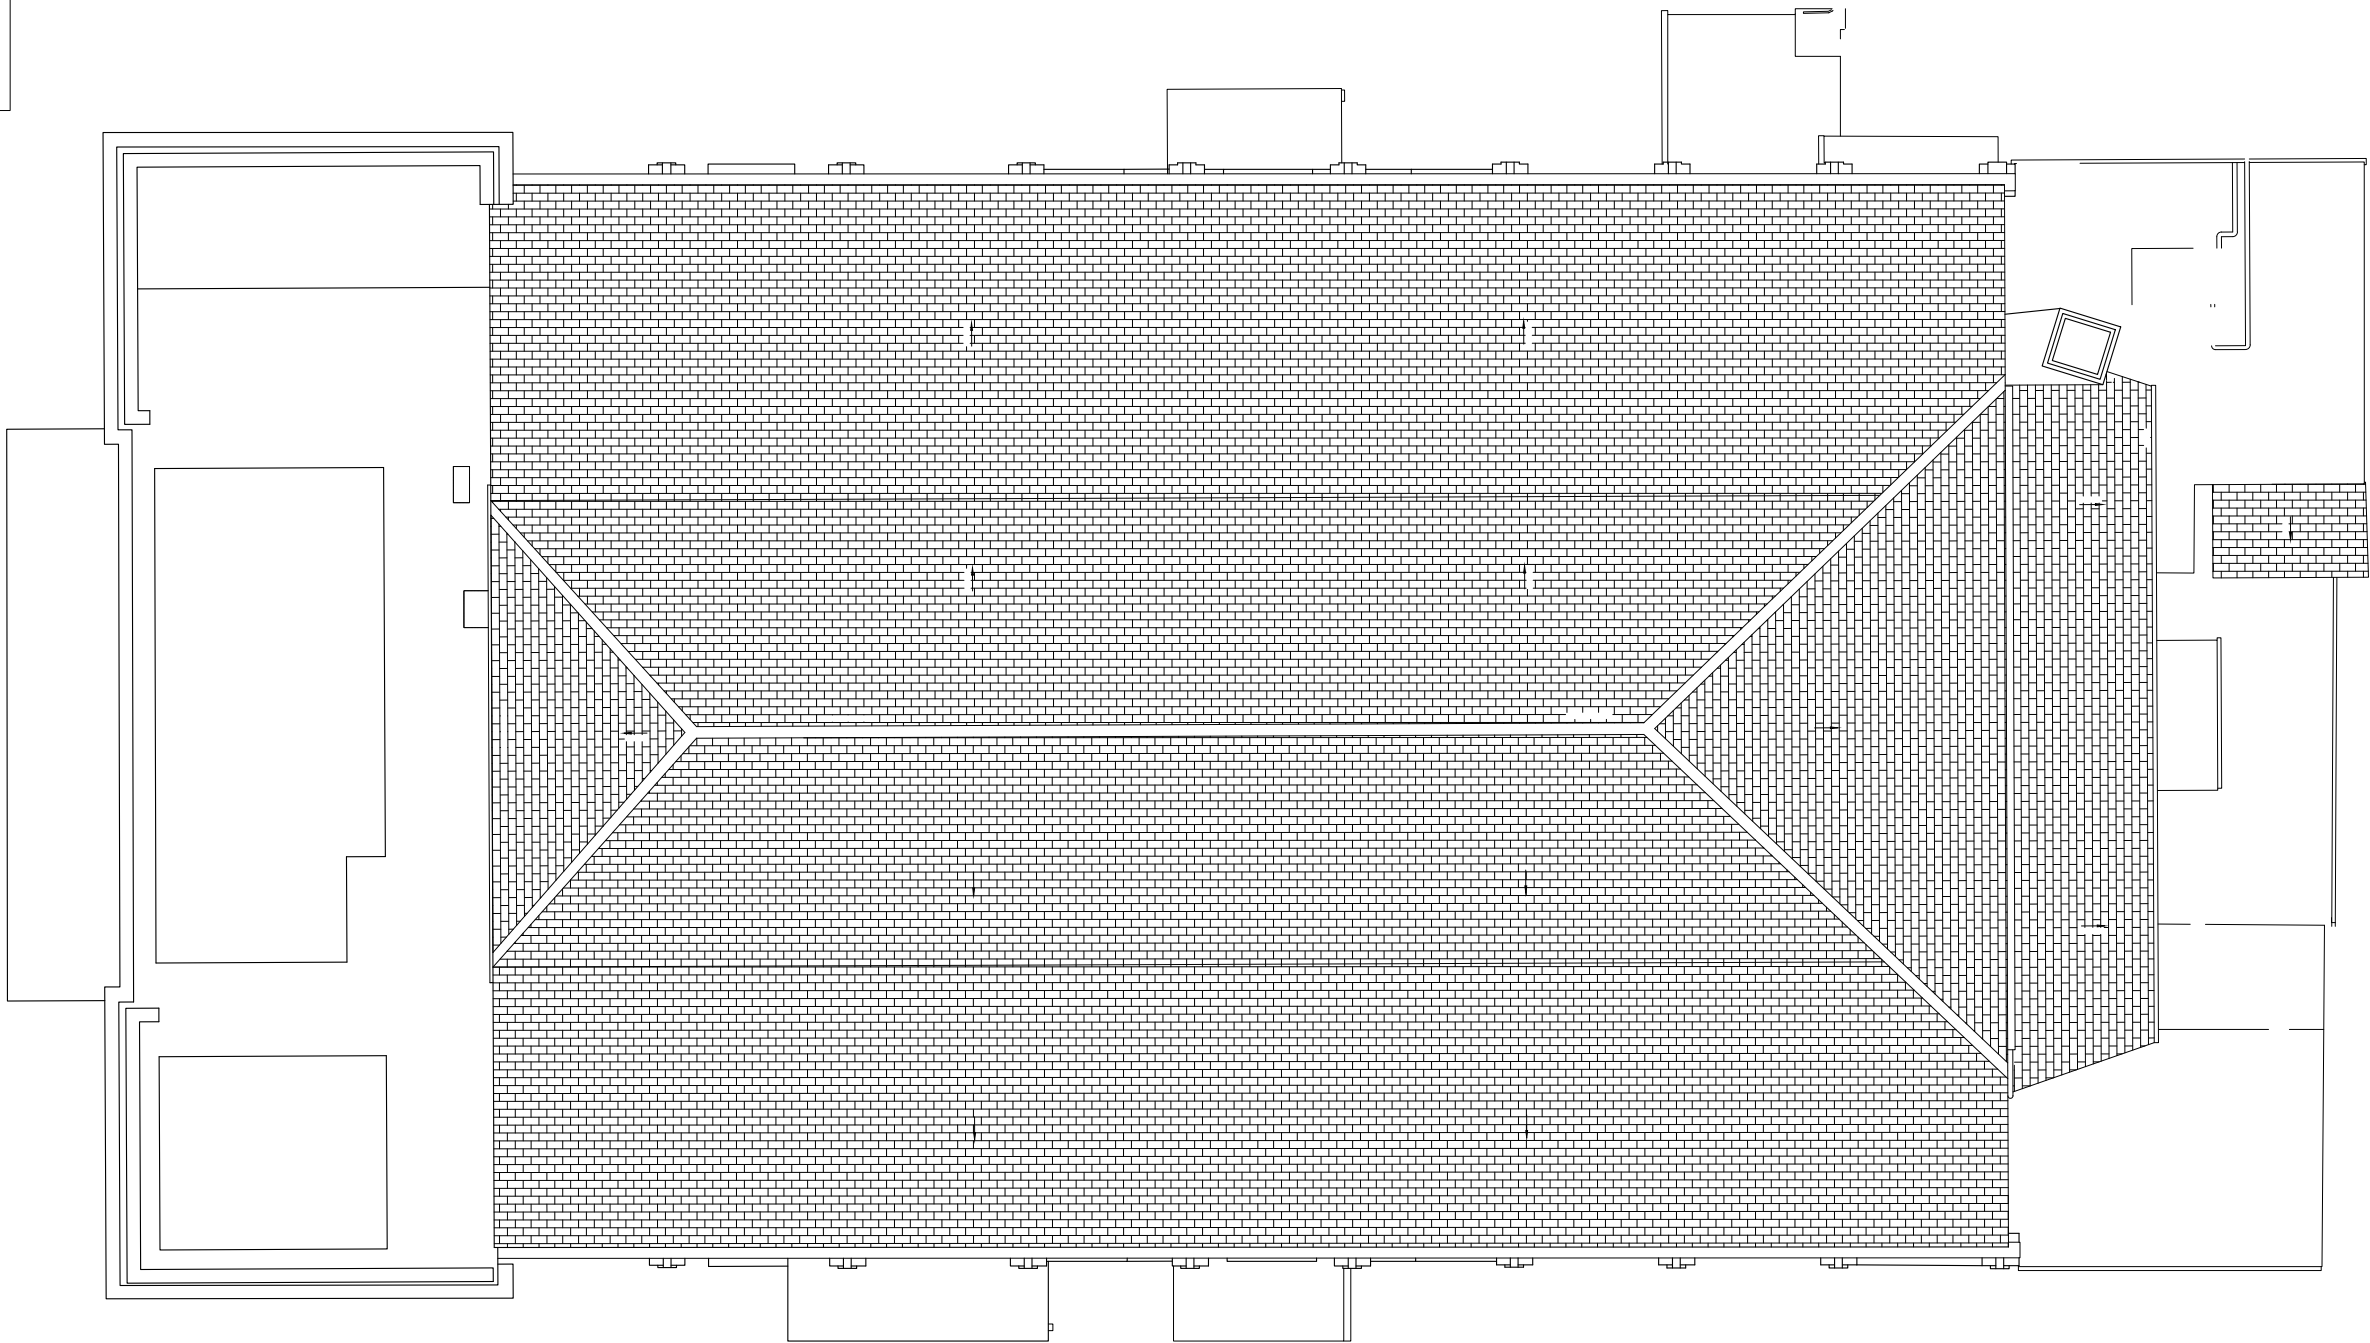

86-90 Paul Street, London EC2A 4NE  
telephone: +44 (0) 203 095 4799  
mobile: +44 (0) 7414032373  
e-mail: info@lotusplans.co.uk  
www.lotusplans.co.uk

| REVISION NO. | DATE | COMMENTS |
|--------------|------|----------|
|              |      |          |
|              |      |          |
|              |      |          |
|              |      |          |

CLIENT  
468-480 Uxbridge Road, Hillingdon  
UB4 0SD

SCALE  
1:200 @ A3  
  
DATE  
May 2023

PROJECT  
Proposed mezzanine rear extension and change of use from  
Sui Generis (Bingo hall) to banqueting hall at  
468-480 Uxbridge Road, Hillingdon  
UB4 0SD  
  
DRAWING TITLE  
As built Second floor and Roof plan

PROJECT NO.  
**LOTUS/743/23**  
  
DRAWING NO.  
**HIL-012**