




UXBRIDGE ROAD

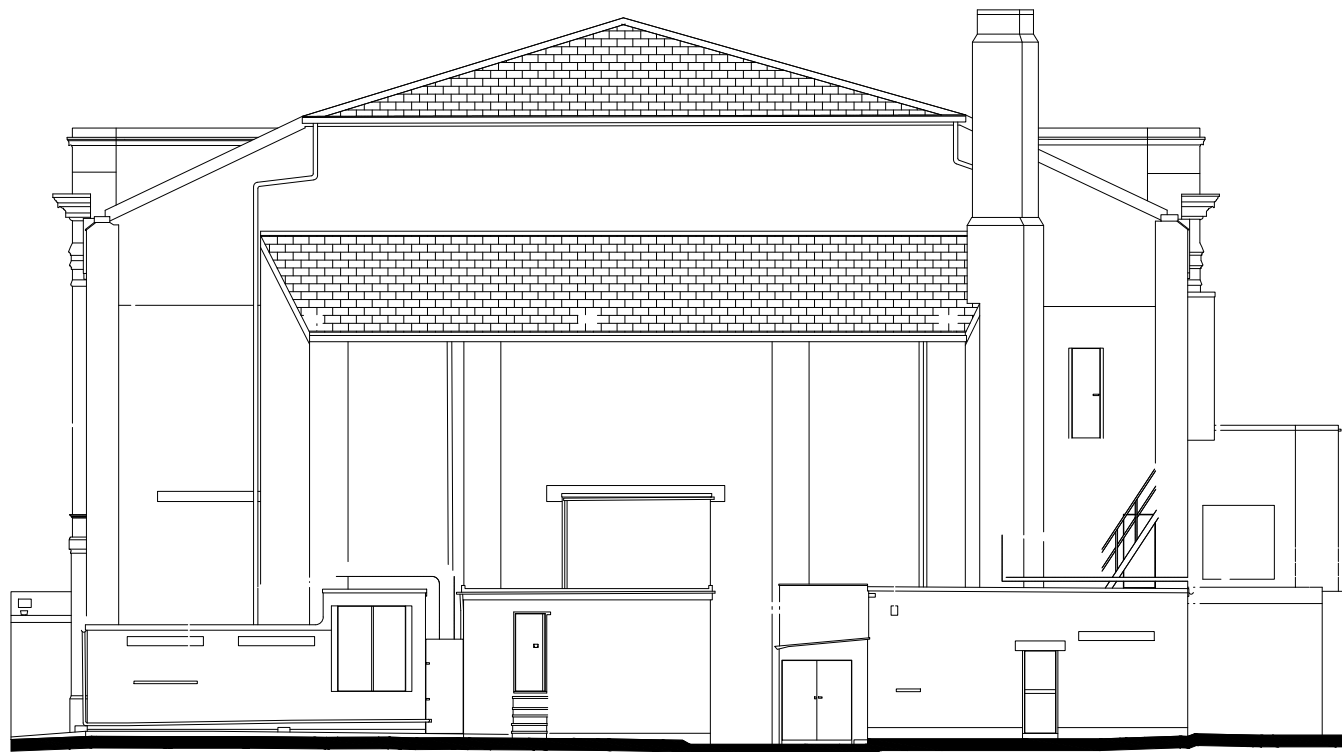

86-90 Paul Street, London EC2A 4NE
Telephone: +44 (0) 203 095 4799
Mobile: +44 (0) 7414032373
e-mail: info@lotusplans.co.uk
www.lotusplans.co.uk

REVISION NO.	DATE	COMMENTS

CLIENT
468-480 Uxbridge Road, Hillingdon
UB4 0SD

SCALE
1:200 @ A3

DATE
May 2023

PROJECT
Proposed change of use from Sui Generis (Bingo hall) to
banqueting hall at
468-480 Uxbridge Road, Hillingdon
UB4 0SD

DRAWING TITLE
As built Front & Rear elevation

PROJECT NO.
LOTUS/743/23

DRAWING NO.
HIL-013