



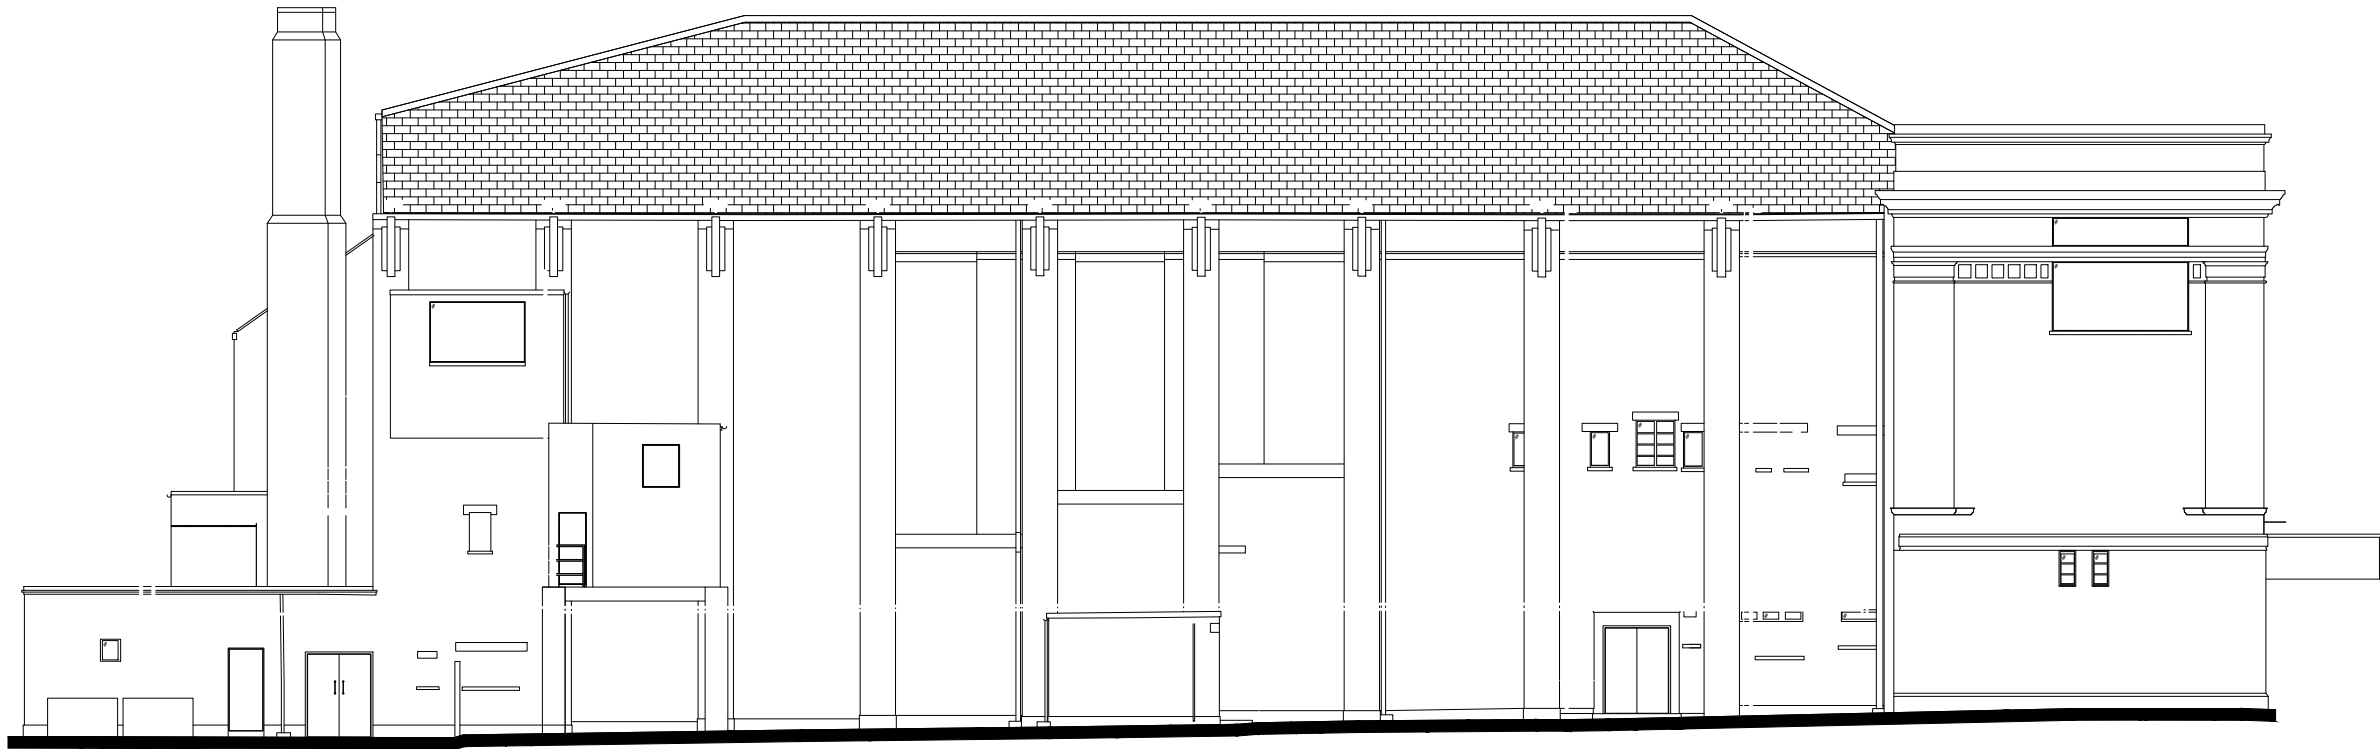

468-480

AS BUILT SIDE (2) ELEVATION

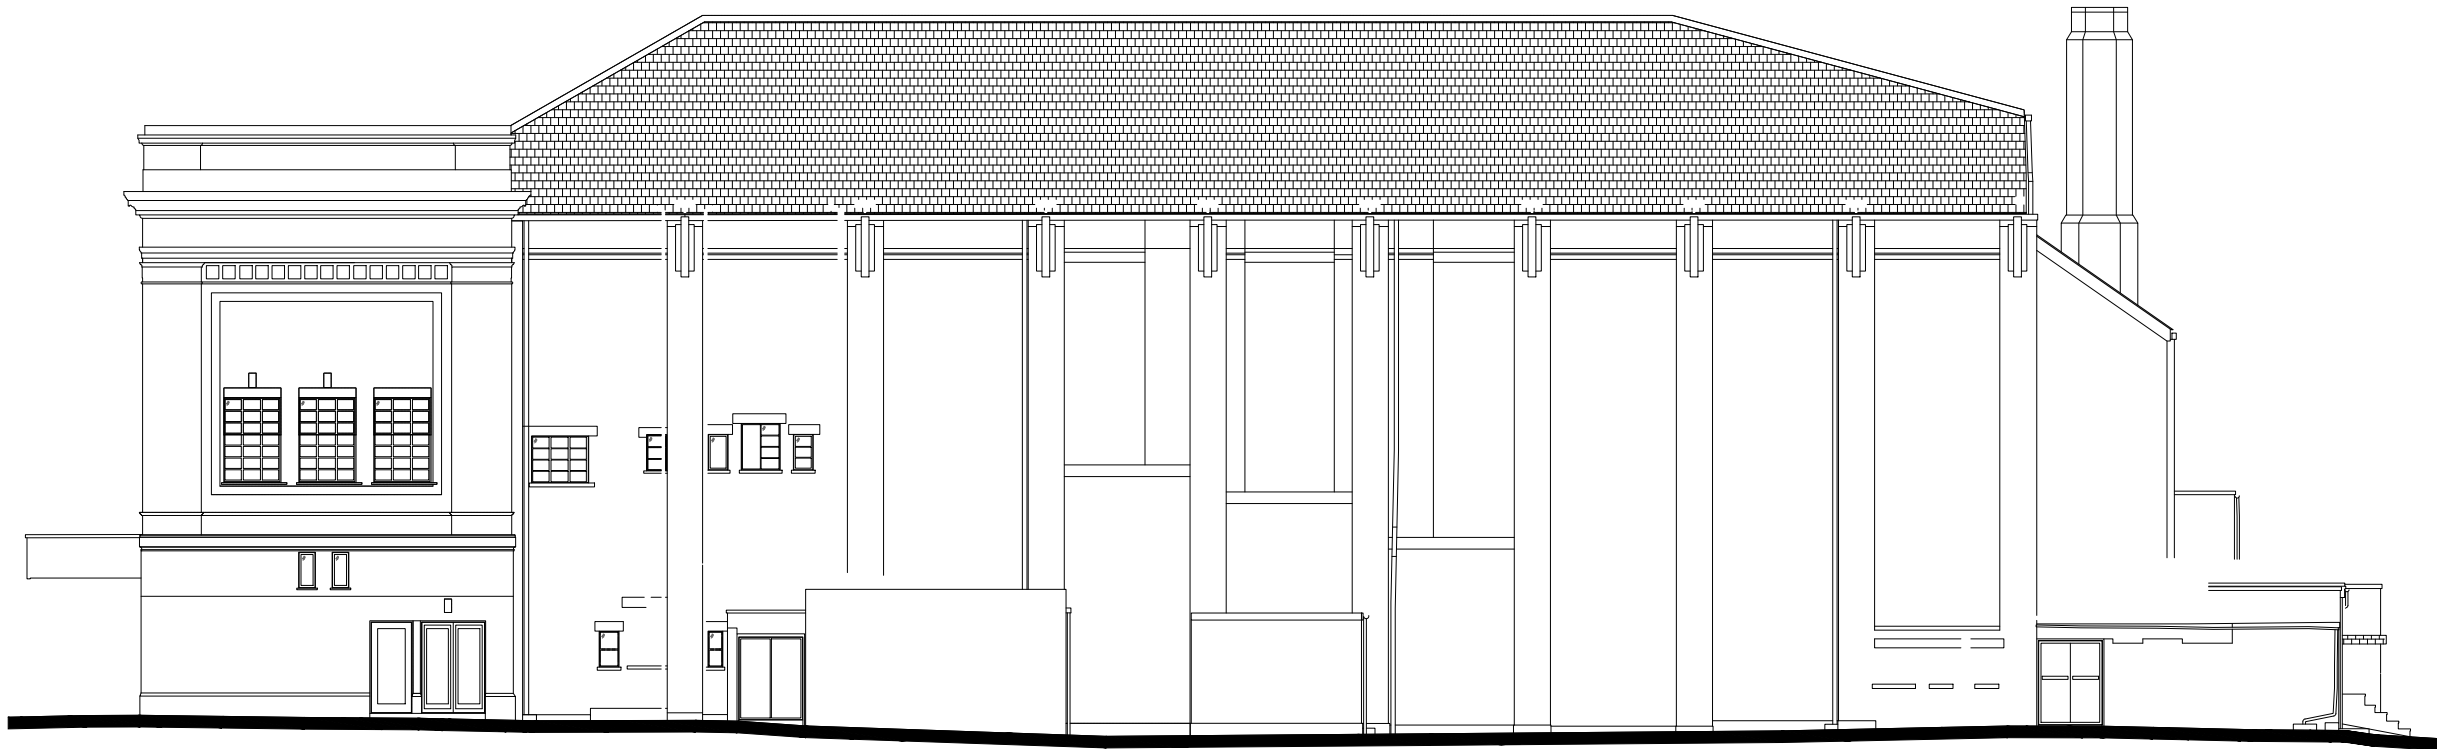

AS BUILT SIDE (1) ELEVATION

468-480



REVISION NO.	DATE	COMMENTS

CLIENT
468-480 Uxbridge Road, Hillingdon
UB4 0SD

SCALE
1:200 @ A3

DATE
May 2023

PROJECT
Proposed mezzanine rear extension and change of use from
Sui Generis (Bingo hall) to banqueting hall at
468-480 Uxbridge Road, Hillingdon
UB4 0SD

DRAWING TITLE
As built Side elevation

PROJECT NO.
LOTUS/743/23

DRAWING NO.
HIL-014