

① Proposed Plan - GF

Scale: 1:50


A horizontal scale with vertical tick marks at 0, 1, 2, 3, 4, and 5. A thick black horizontal bar spans from the 0 mark to the 3 mark.

NOTE:
Conservatory structure
area designed by others

NOTE:
This plan has been based on a laser survey by others.
Contractor to check all site dimensions prior to construction & highlight any discrepancies

Read in conjunction with kitchen and bar plans by others.

All alterations subject to relevant planning permissions

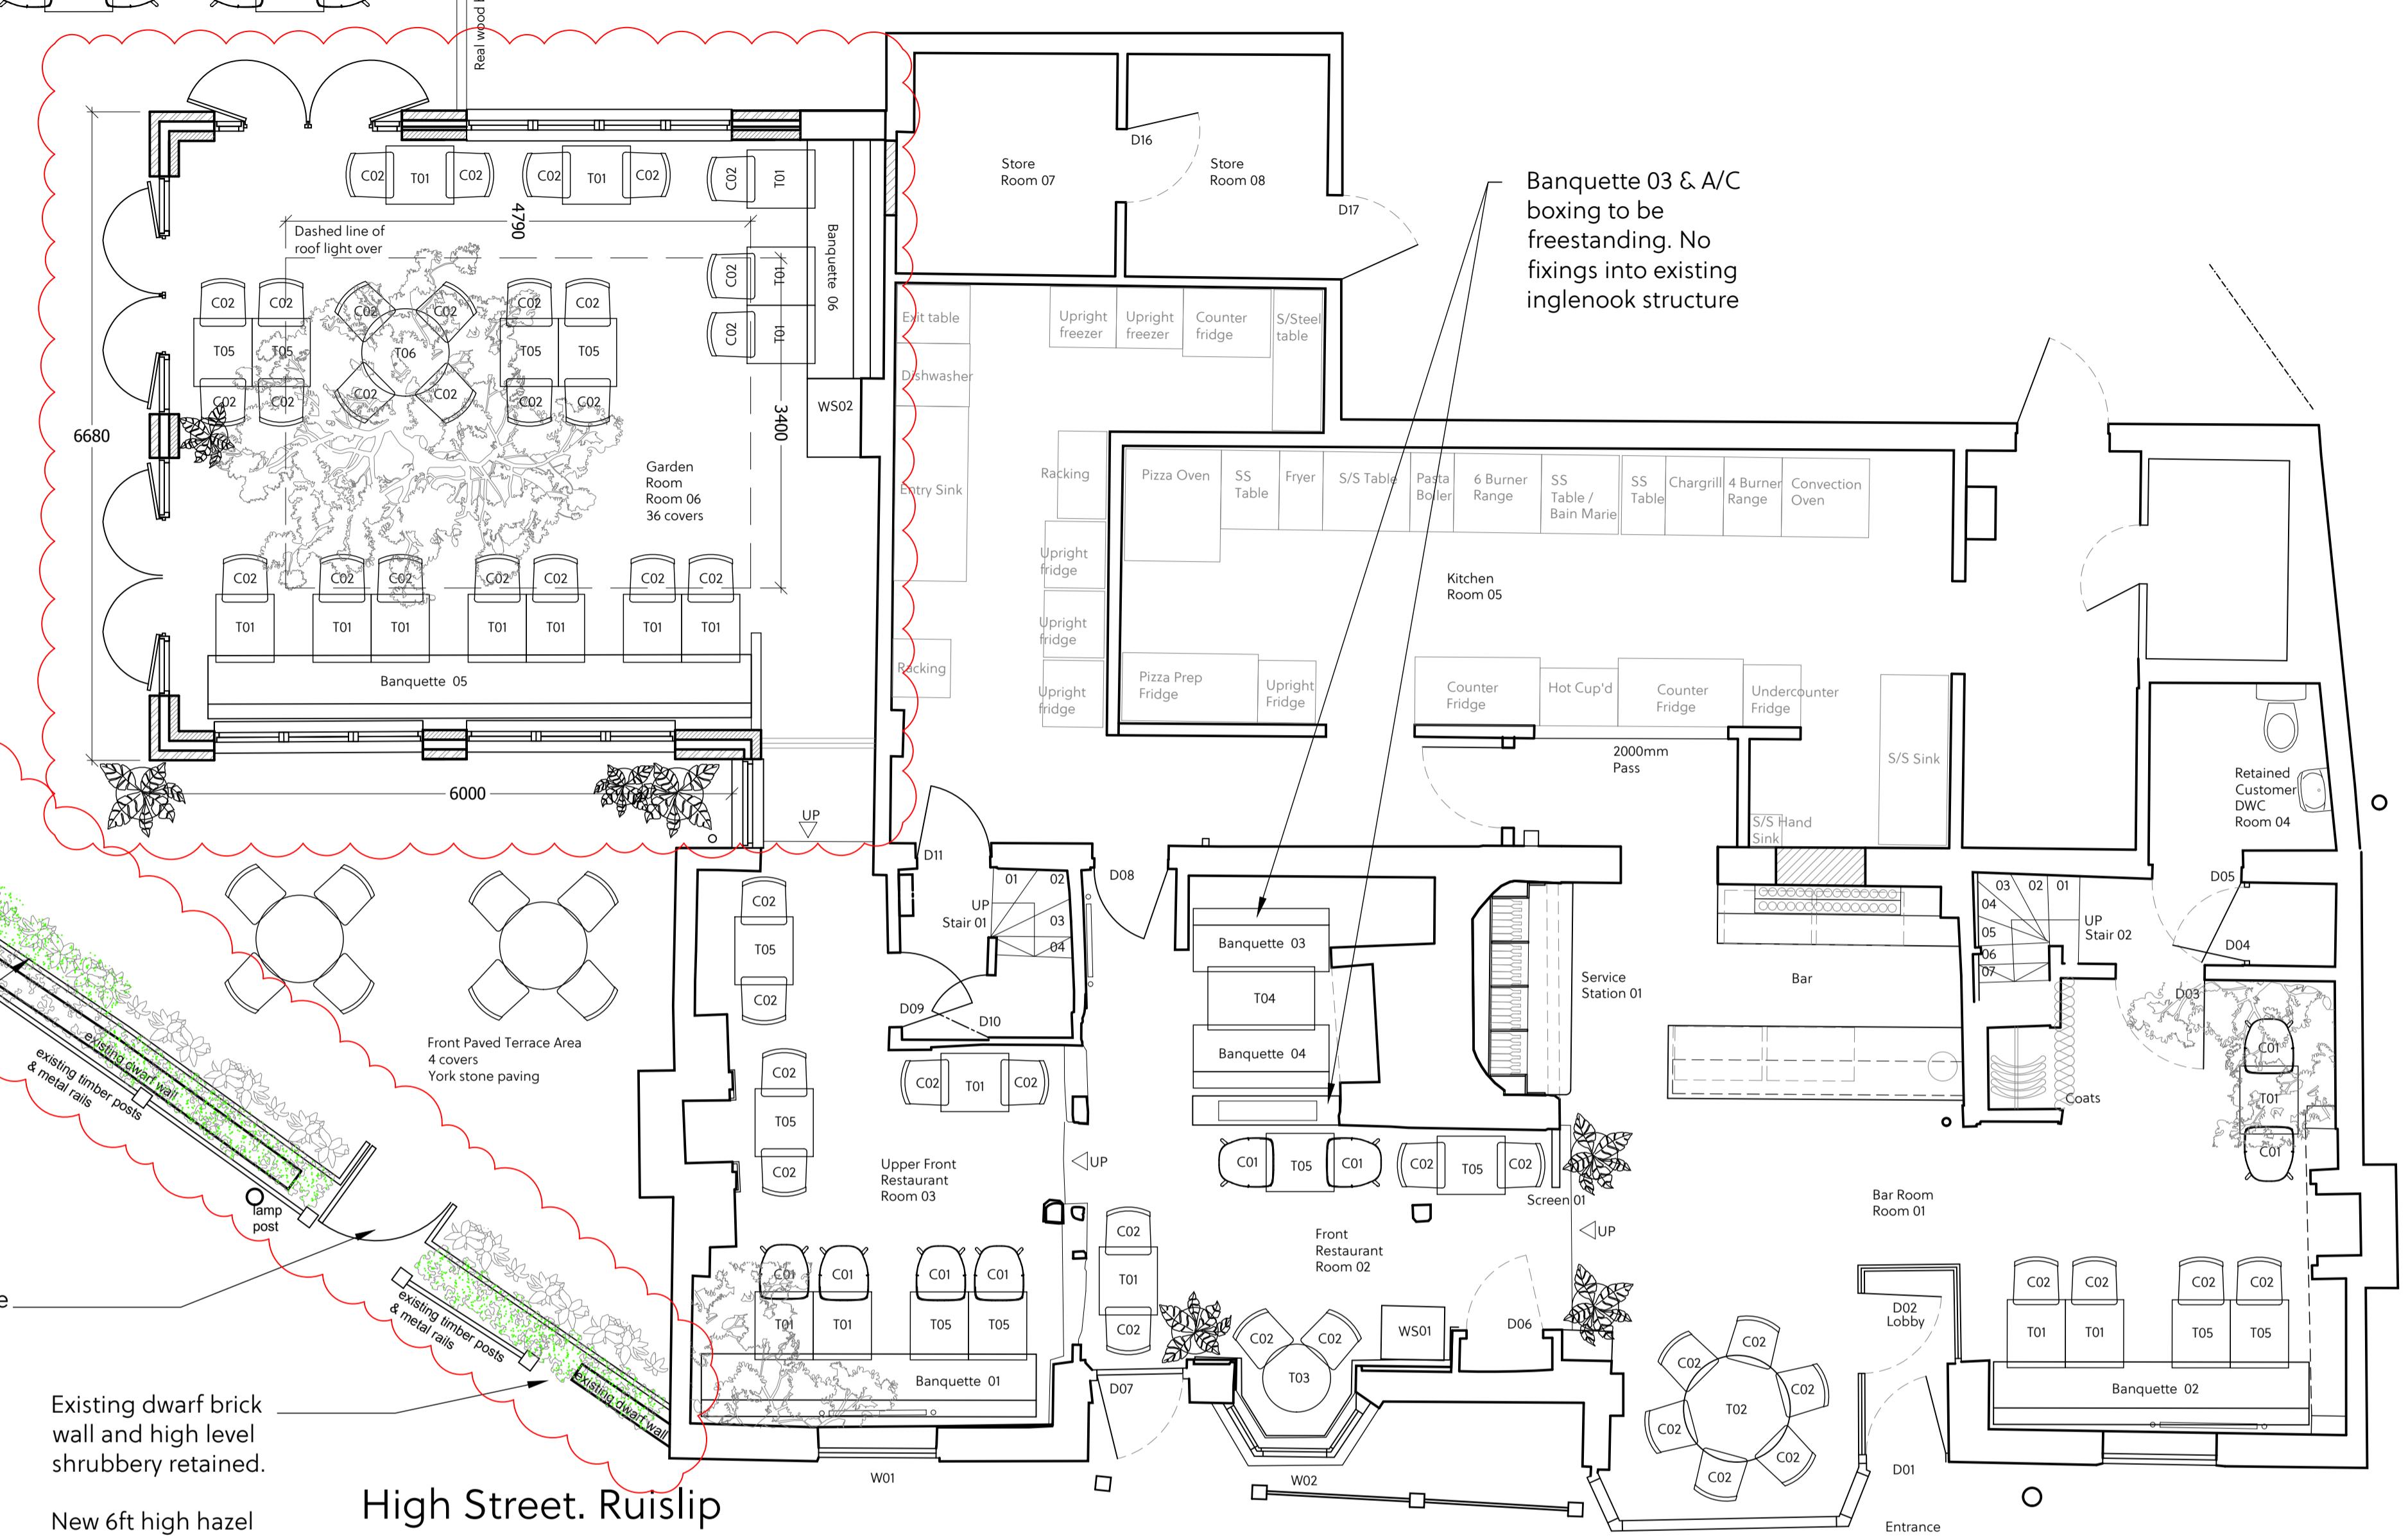


High Street. Ruislip

General Notes

1. All finishes are to conform to the required current Building Codes & Regulations in applicable country.
2. The Contractor must verify all site dimensions, drawings, details and specifications and report any discrepancies to StudioARIN before proceeding with any work.
3. The Contractor is to conform to the StudioARIN project preliminaries & scope of works documentation.
4. All requested drawings showing fixing and construction details are required to be approved by StudioARIN prior to commencement of work.
5. All specified items are to be installed in accordance with the manufacturers recommendations on a suitable substrate.
6. The Contractor is to provide a safe and suitable working environment which complies with the current Health and Safety and Local Authority regulations.
7. All finishes are to be implemented to a high quality.
8. Any dimensions are to be taken from the setting out plan only and are not to be scaled from the drawings.
9. It is the contractors responsibility to ensure that any building works are carried out in accordance with current Building Regulations and Local Authority requirements.
10. The contractor is to check and appraise design intent and construction details and alternatives, as appropriate, to implement the design.
11. In the event that there is a conflict in information, the Contractor is to highlight discrepancies to the designer / Contract Administrator.
12. This drawing is to read in conjunction with the other relevant drawings, specification schedules and co-consultants information.
13. Copyright of StudioARIN and is not to be reproduced without permission.

Rev	Date & Item
A	30-01-23 Scale bar added / conservatory amended
B	17-04-23 Conservatory design & ge amended
C	03.05.23 Conservatory design & fe amended

- Reason Issued
- Information Only
- Local Authority Application
- Tender Issue
- Construction
- As Built Information

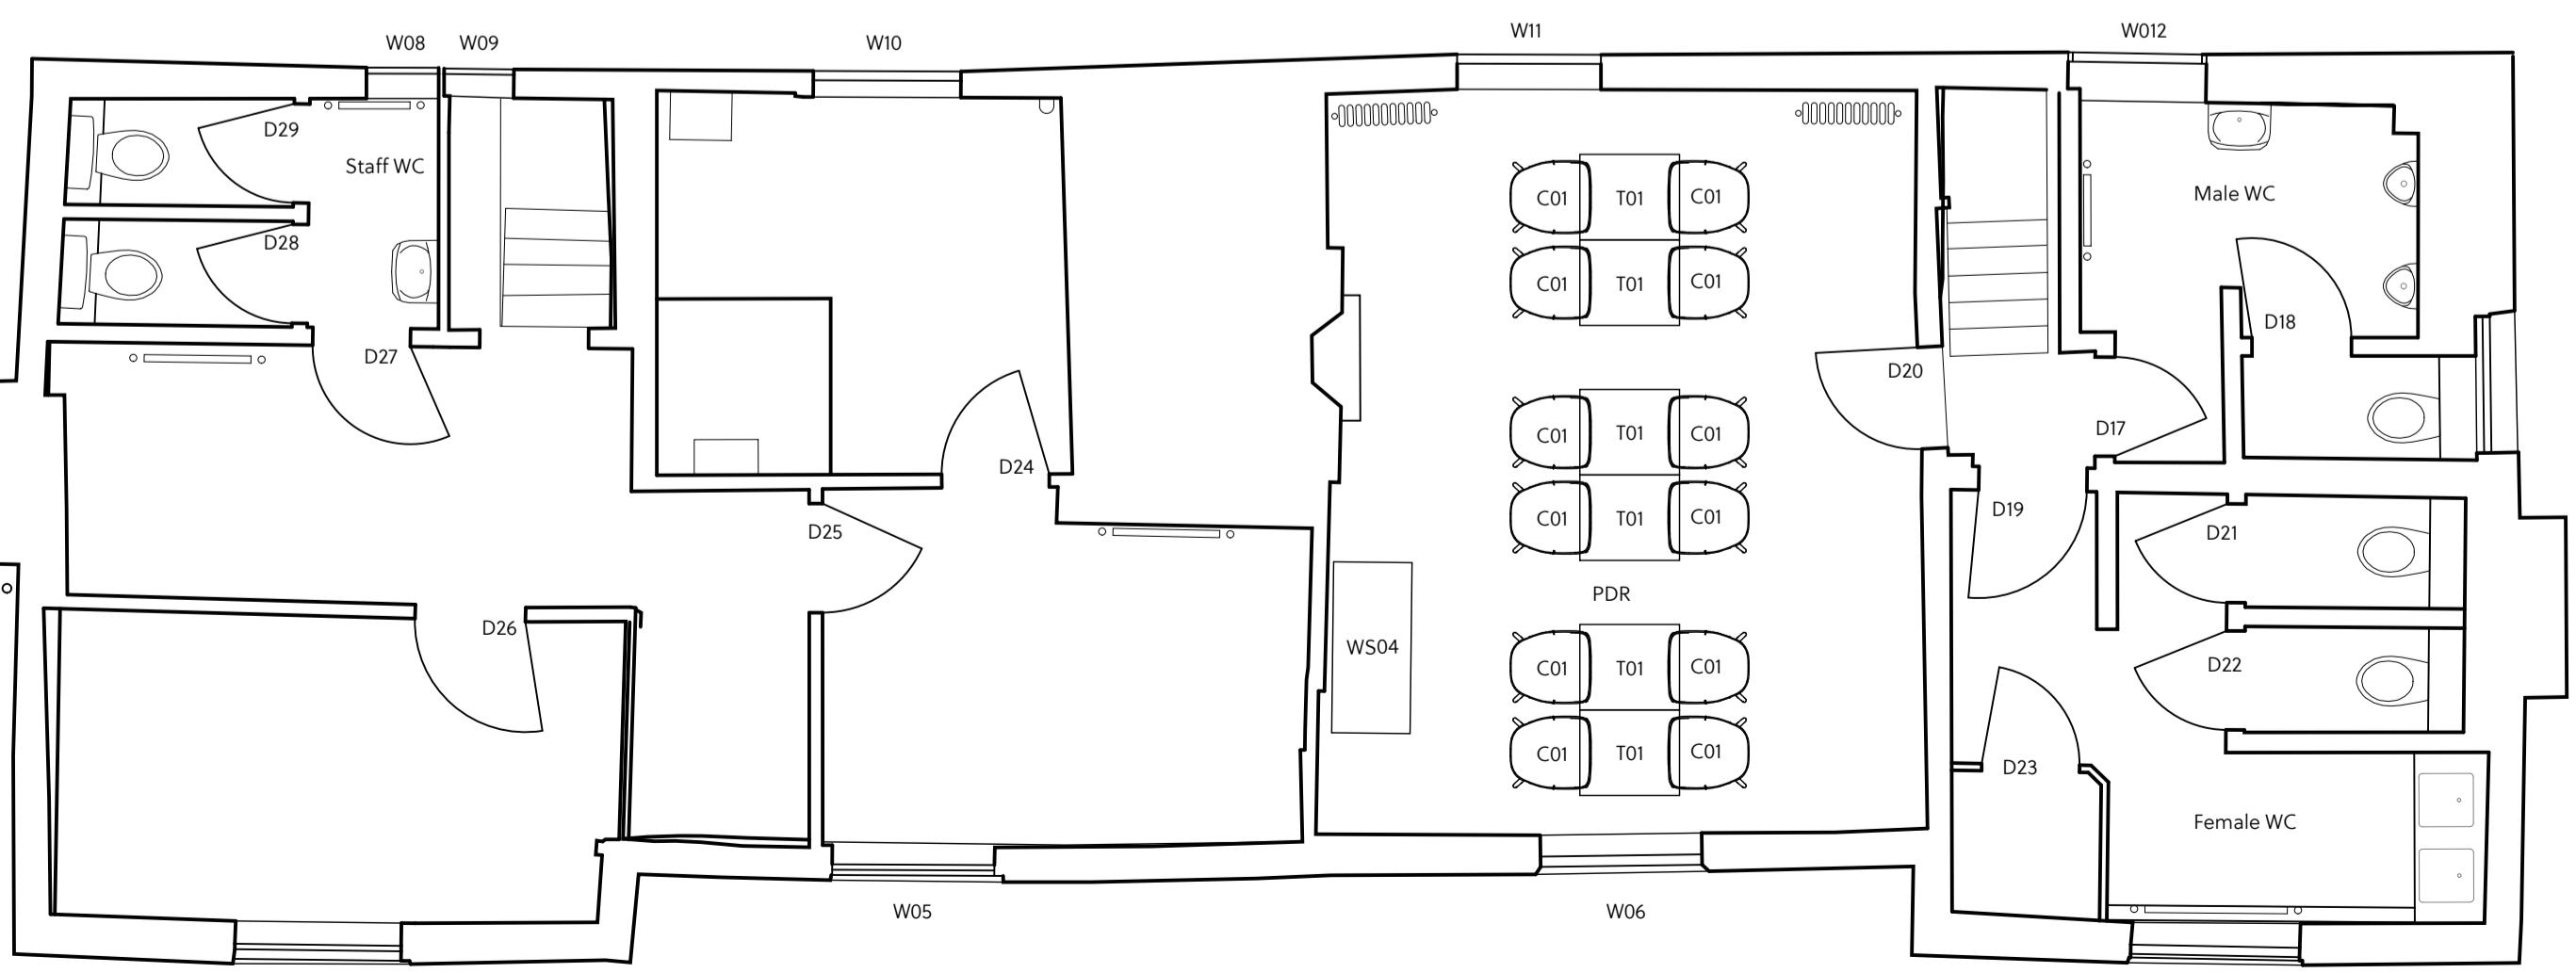

W04 Proposed Plan - FF

Scale: 1:50

Job Details

Zaza Restaurant The Duck House, Ruislip

Drawing title: Proposed Plan
& date 10/22

Dwg number 02-01
& revision C

A. J. H. VAN DER HORST

info@studioarin.co.uk
07940934306