

Proposed Bar Plan


Scale: 1:20

Spray painted timber wine storage, WF09. No fixings into existing structure
Service station joinery & counter to be freestanding. No fixings into existing structure
Composite stone bar top, ST02
Composite stone bar top, ST01
Metal gantry - deck mounted to bar counter
Low beam over
Existing timber beam & brickwork to be retained unfinished

Timber battens to be screwed to structure
T&G paneling to be pinned to timber battens


Typical T&G Detail

Scale: 1:5

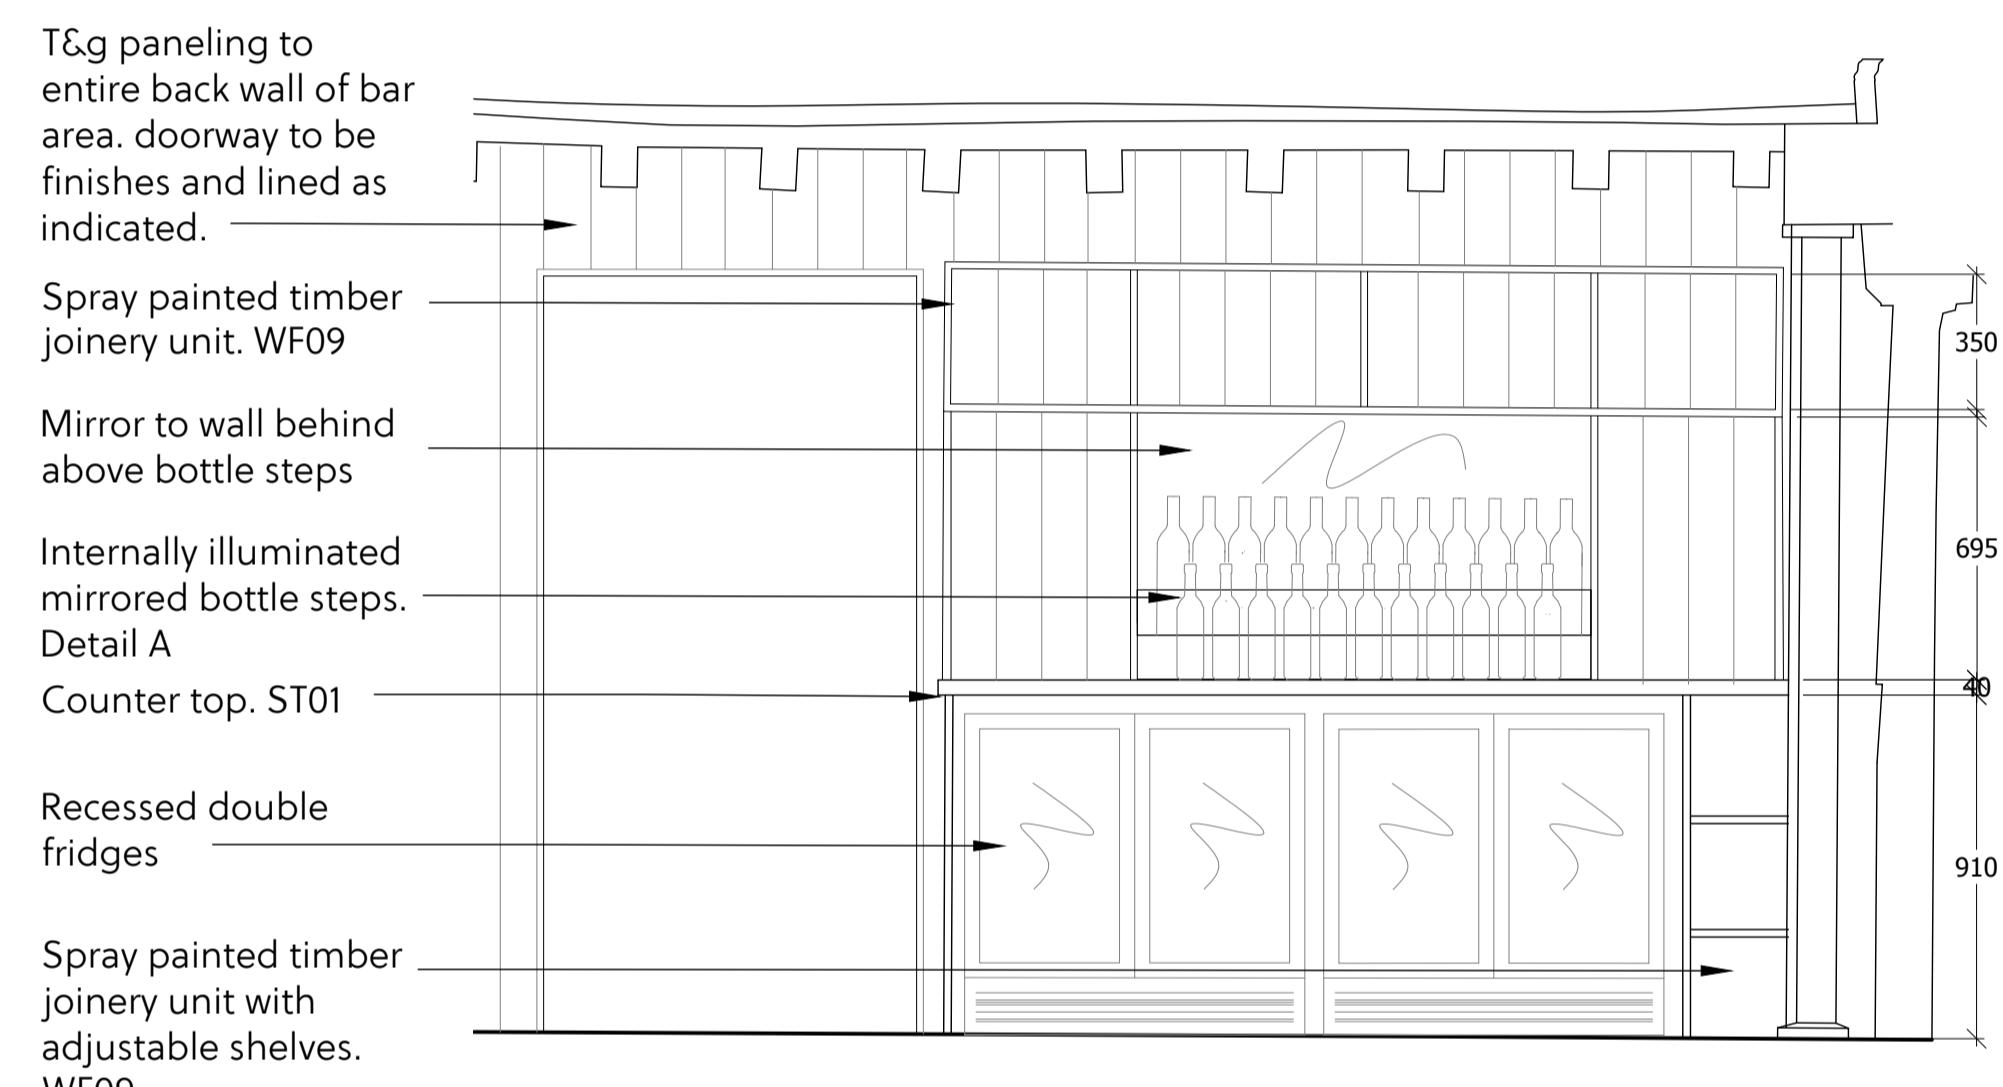


Proposed elevation - Back Bar

Scale: 1:20

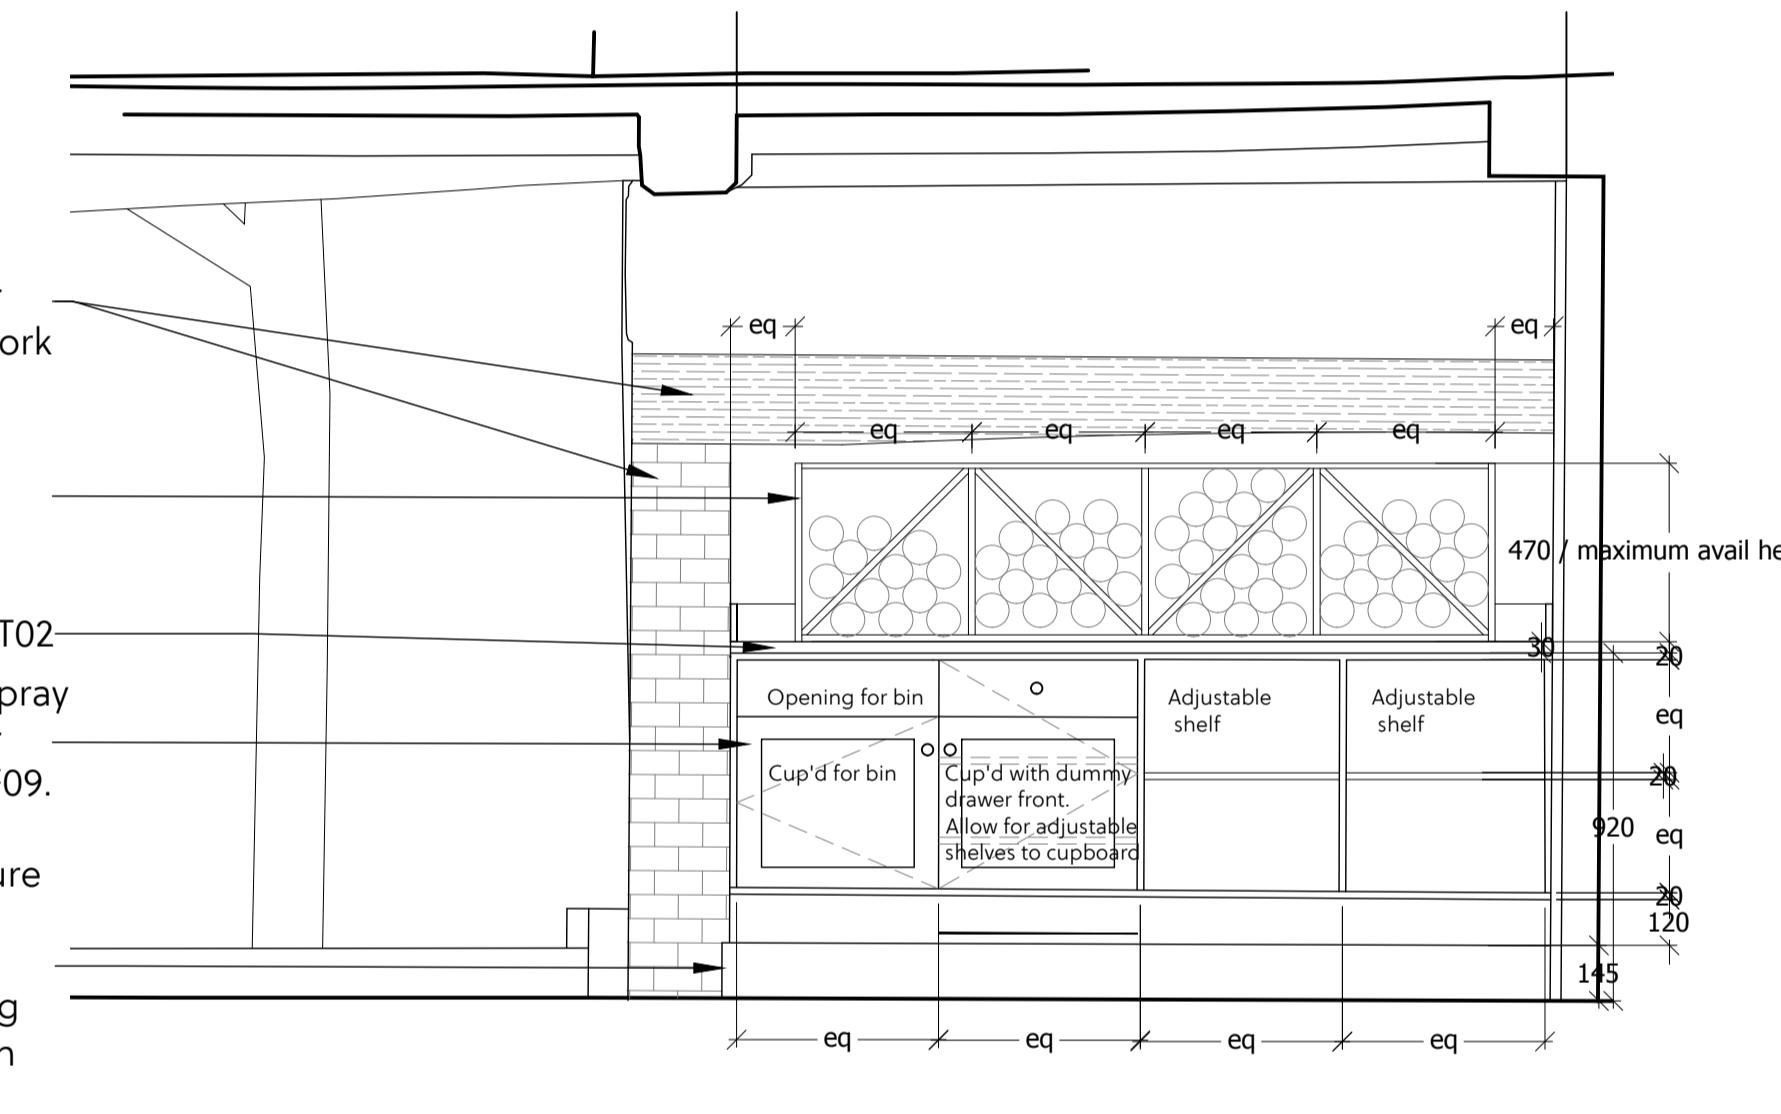


Proposed elevation - Service Station

Scale: 1:20

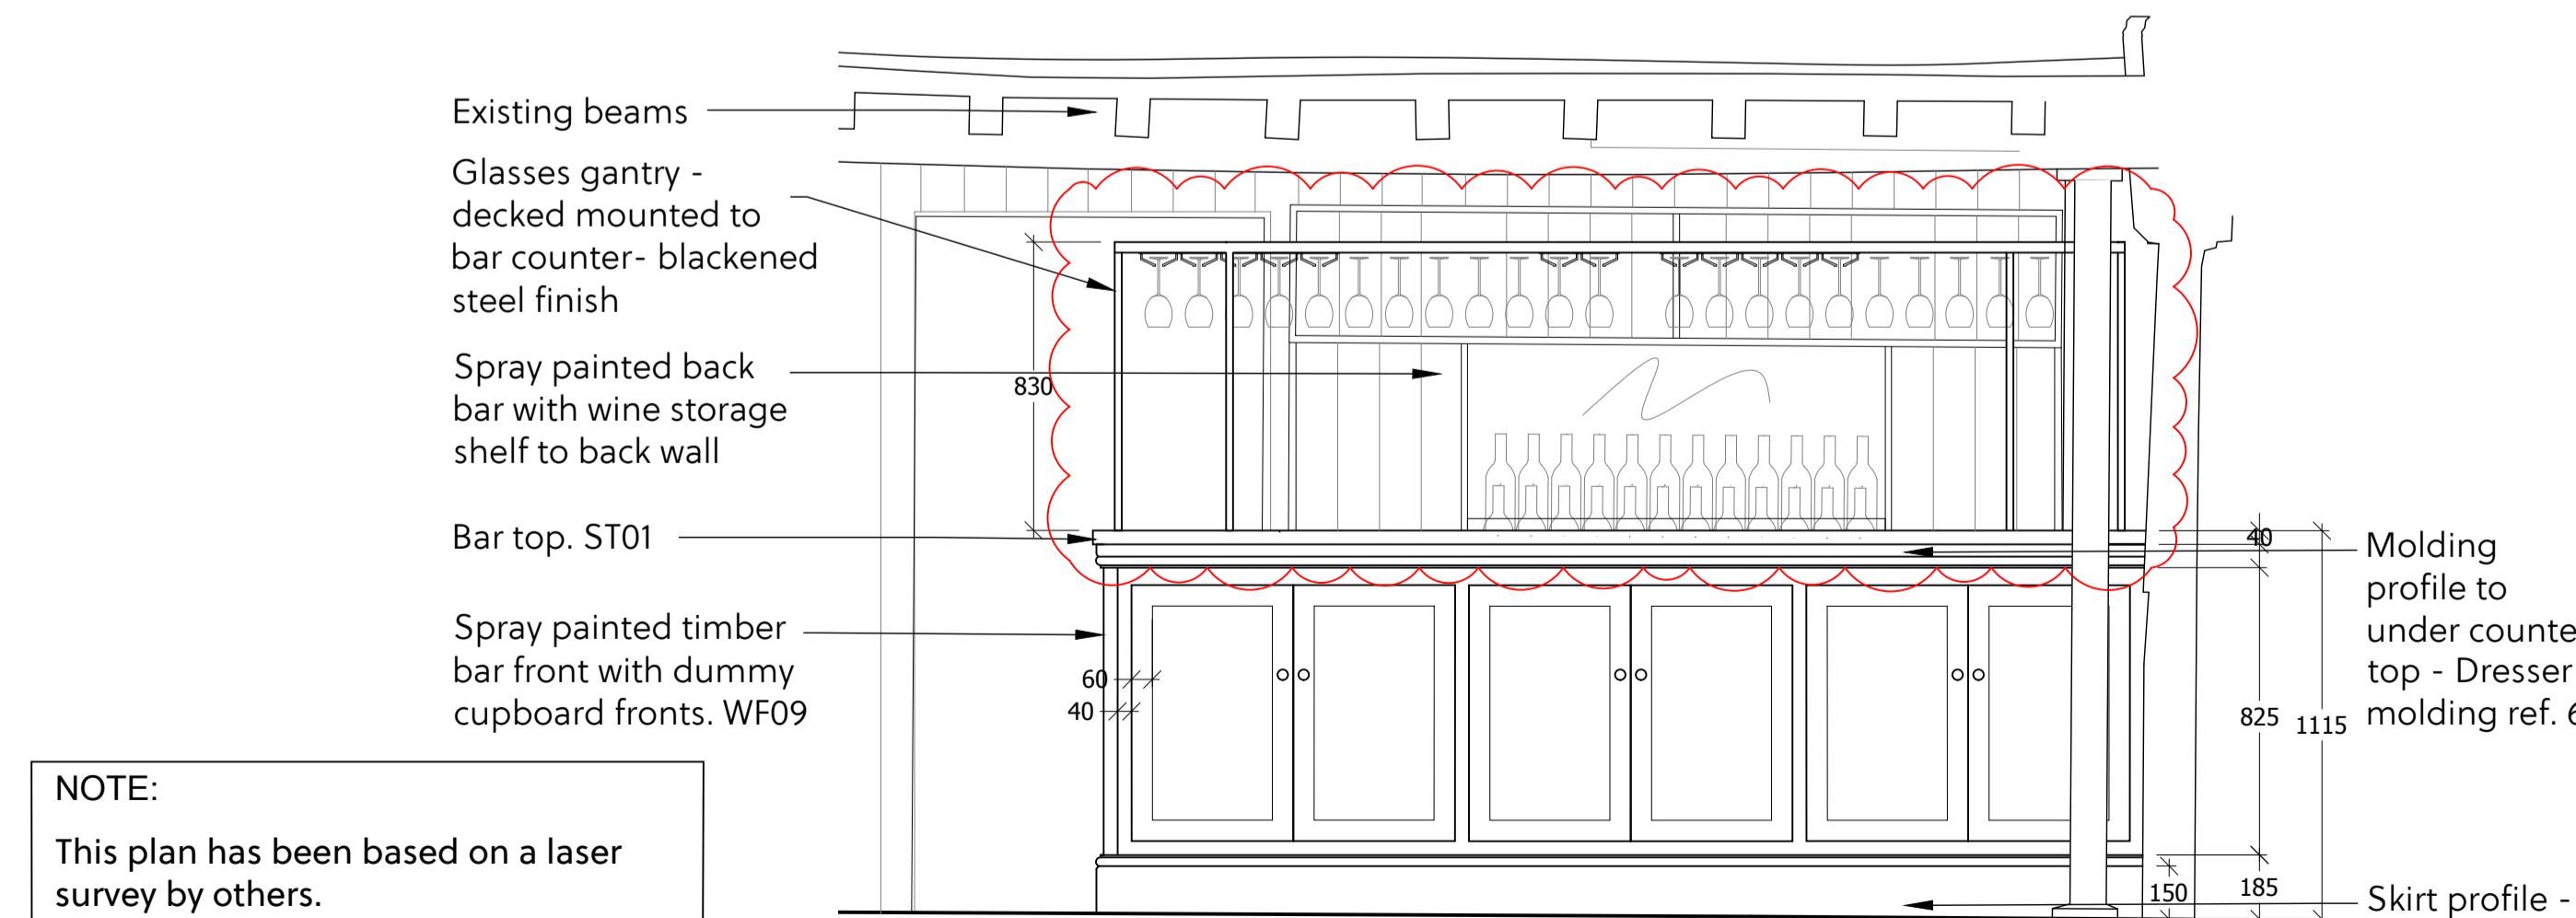

NOTE:

This plan has been based on a laser survey by others.
Contractor to check all site dimensions prior to construction & highlight any discrepancies
All alterations subject to relevant planning permissions

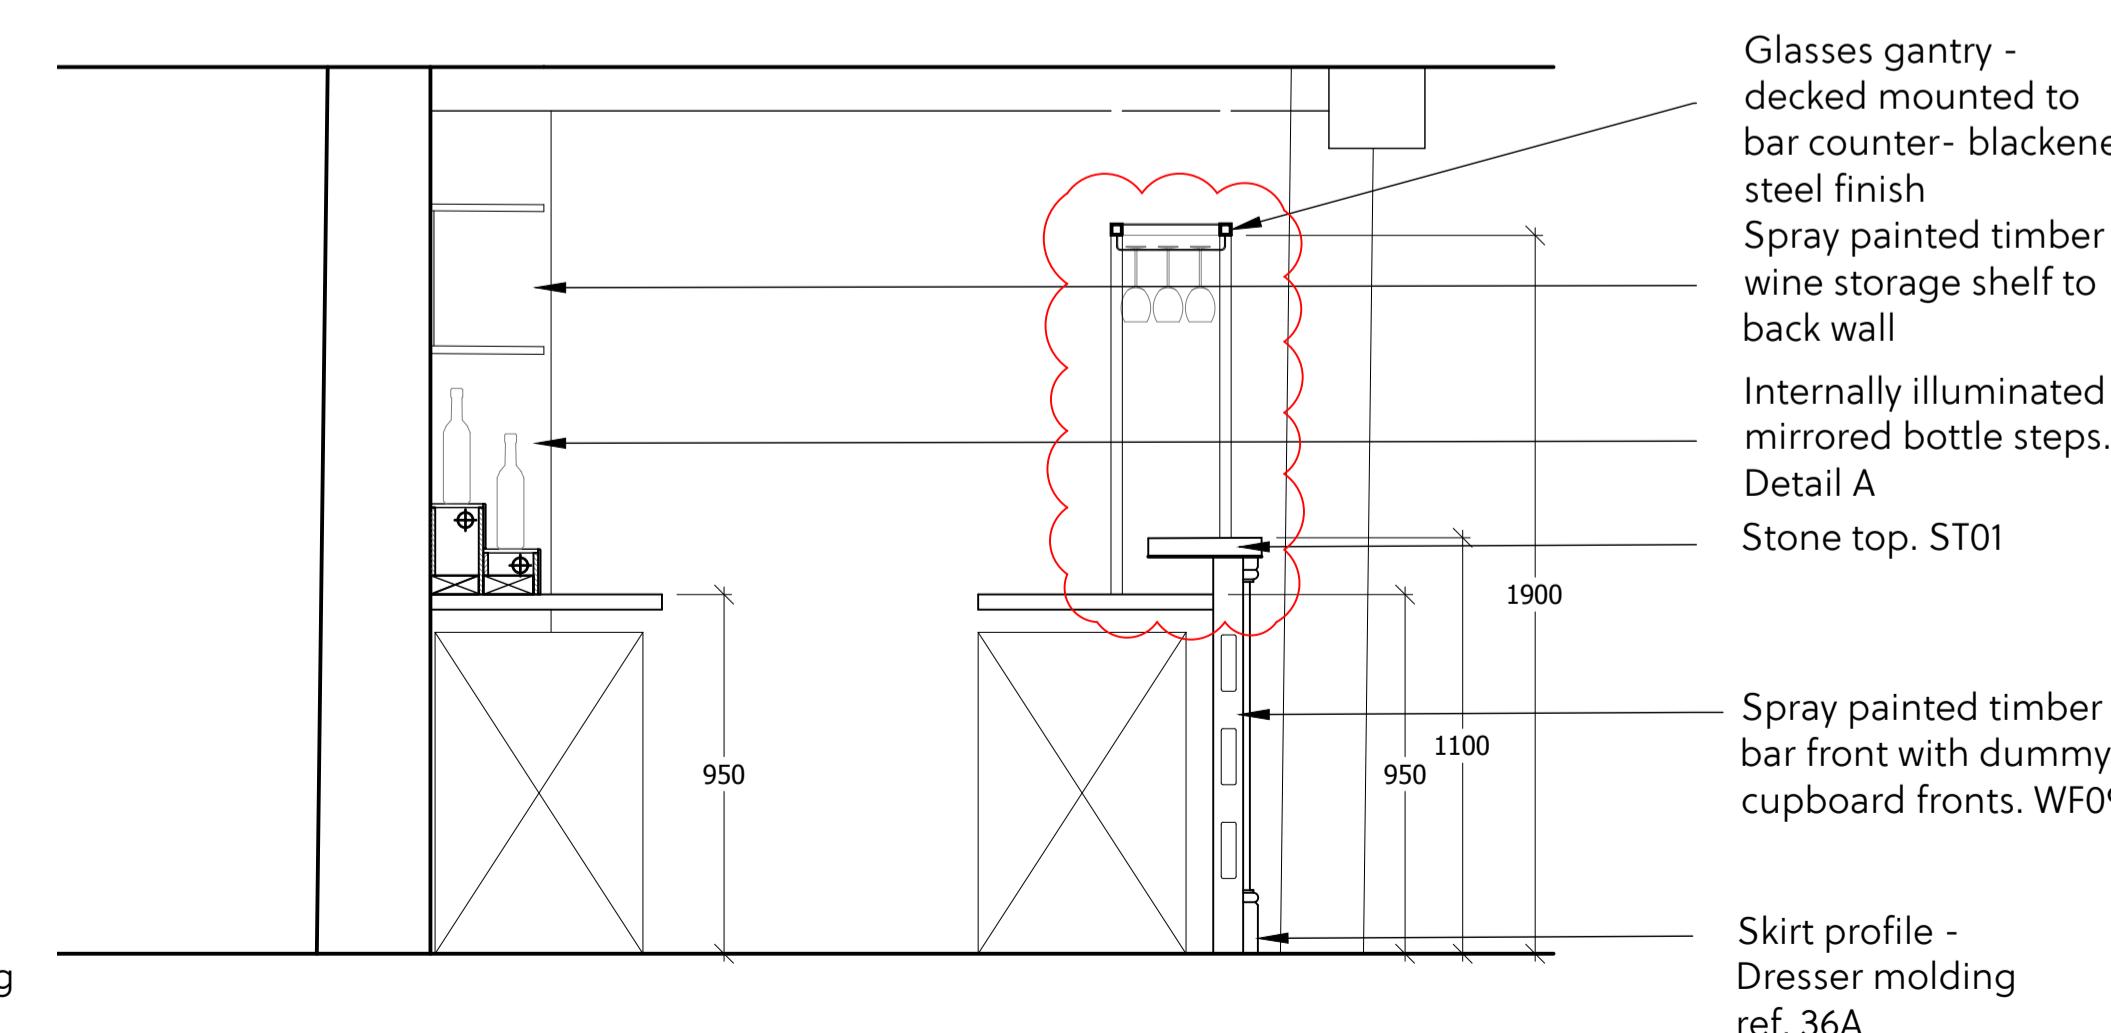

Typical section through - Main Bar

Scale: 1:20

General Notes

- All finishes are to conform to the required current Building Codes & Regulations in the applicable country.
- The Contractor must verify all site dimensions, drawings, details and specifications and report any discrepancies to StudioARIN before proceeding with any work.
- The Contractor is to conform to the StudioARIN project preliminaries & scope of works document.
- All requested drawings showing fixings and construction details are required to be approved by StudioARIN prior to commencement of work.
- All specified items are to be installed in accordance with the manufacturers recommendations on a suitable substrate.
- The Contractor is to provide a safe and suitable working environment which conforms to the current Health and Safety and Local Authority regulations.
- All finishes are to be implemented to a high quality.
- Any dimensions are to be taken from the setting out plan only and are not to be scaled from the drawings.
- It is the contractors responsibility to ensure that any building works are carried out in accordance with current Building Regulations and Local Authority requirements.
- The contractor is to check and appraise all design intent and construction details and offer alternatives, as appropriate, to implement the design.
- In the event that there is a conflict in information, the Contractor is to highlight the discrepancies to the designer / Contract Administrator.
- This drawing is to read in conjunction with the other relevant drawings, specifications, schedules and co-consultants information.
- Copyright of StudioARIN and is not to be reproduced without permission.

Rev Date & Item
A 17-04-23 Service station & gantry amended

X Reason Issued
X Information Only
Local Authority Application
Tender Issue
Construction
As Built Information

Job Details
Zaza Restaurant
The Duck House, Ruislip
Drawing title: Proposed Bar & date 10/22
Dwg number 10-01 & revision A

ARIN

info@studioarin.co.uk
07940934306