




Notes

©Crown Copyright and database rights 2026 OS Licence
no. AC0000849896

Site Area: 611.4m²

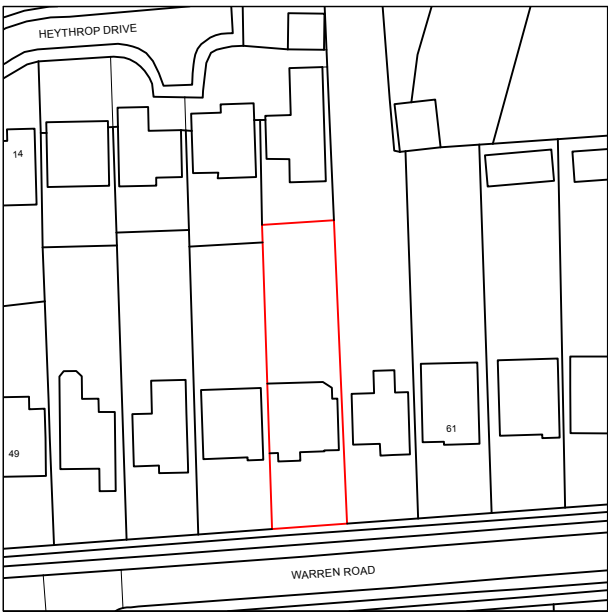

-	-	-	-	-
Revision notes				

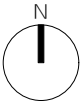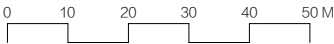



MASONWOOD
DESIGN

www.masonwoodgroup.co.uk
gc@masonwoodgroup.co.uk
020 7118 5040


client
Mr Sukh Rauli

project
57 Warren Road, Ickenham, UB10 8AD


drawing
SITE LOCATION PLAN

date March 2026	scale 1.1250 at A4	project no 2026.014
work stage 1	drawing no S01	revision -

Notes
0.000 Levels

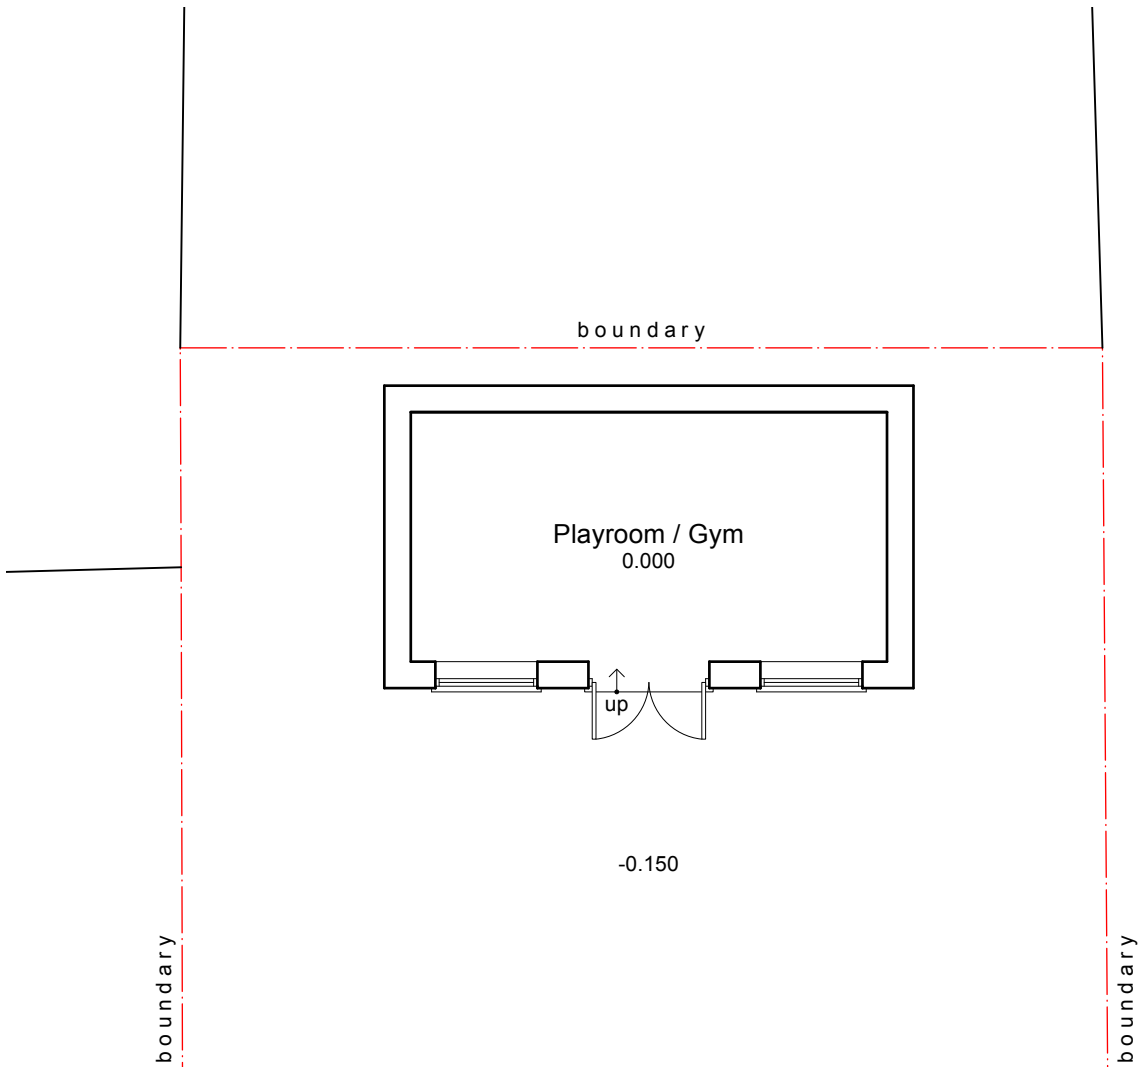


AS-BUILT:
GROUND FLOOR PLAN

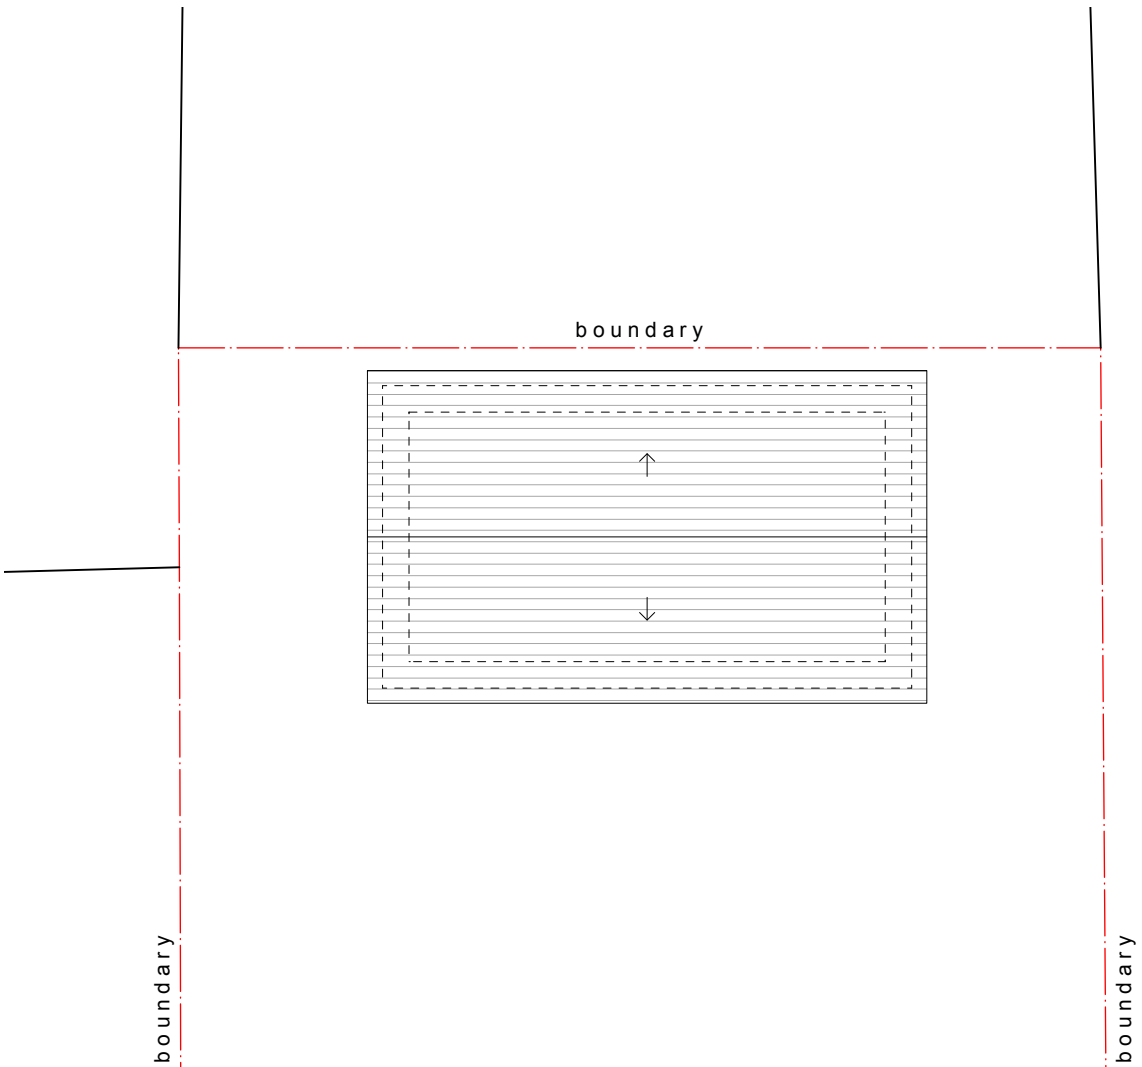

AS-BUILT:
FIRST FLOOR PLAN

-	-	-	-	-
Revision notes				

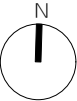

www.masonwoodgroup.co.uk
gc@masonwoodgroup.co.uk
020 7118 5040

client
Mr Sukh Rauli

project
57 Warren Road, Ickenham, UB10 8AD

drawing
AS-BUILT: FLOOR PLANS



date March 2026	scale 1.100 at A3	project no 2026.014
work stage 1	drawing no S02	revision -

AS-BUILT

Notes

Brickwork and tiles to match main dwelling shown hatched.

As built gutter, fascia, eaves and glazing to match main dwelling.

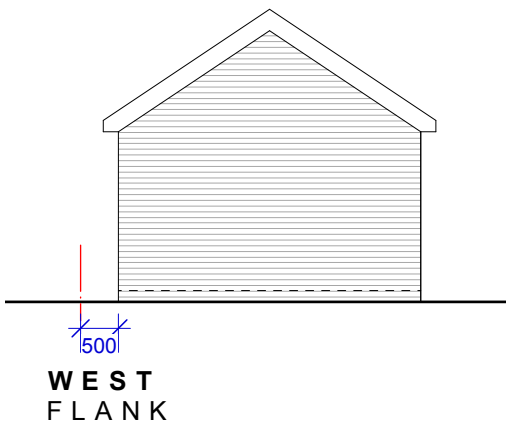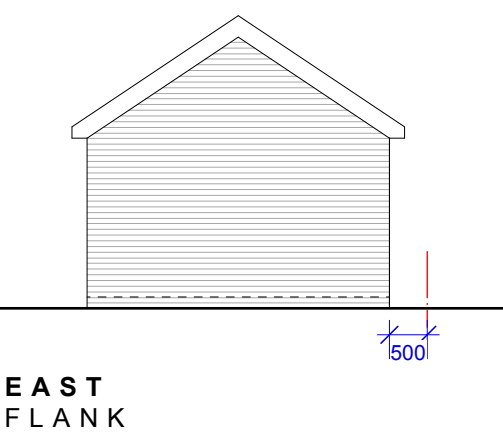

-	-	-	-	-
Revision notes				





client
Mr Sukh Rauli

project
57 Warren Road, Ickenham, UB10 8AD


drawing
AS-BUILT: ELEVATIONS

date March 2026	scale 1:100 at A3	project no 2026.014
work stage 1	drawing no S03	revision -


www.masonwoodgroup.co.uk
gc@masonwoodgroup.co.uk
020 7118 5040

AS-BUILT

Notes
0.000 Levels

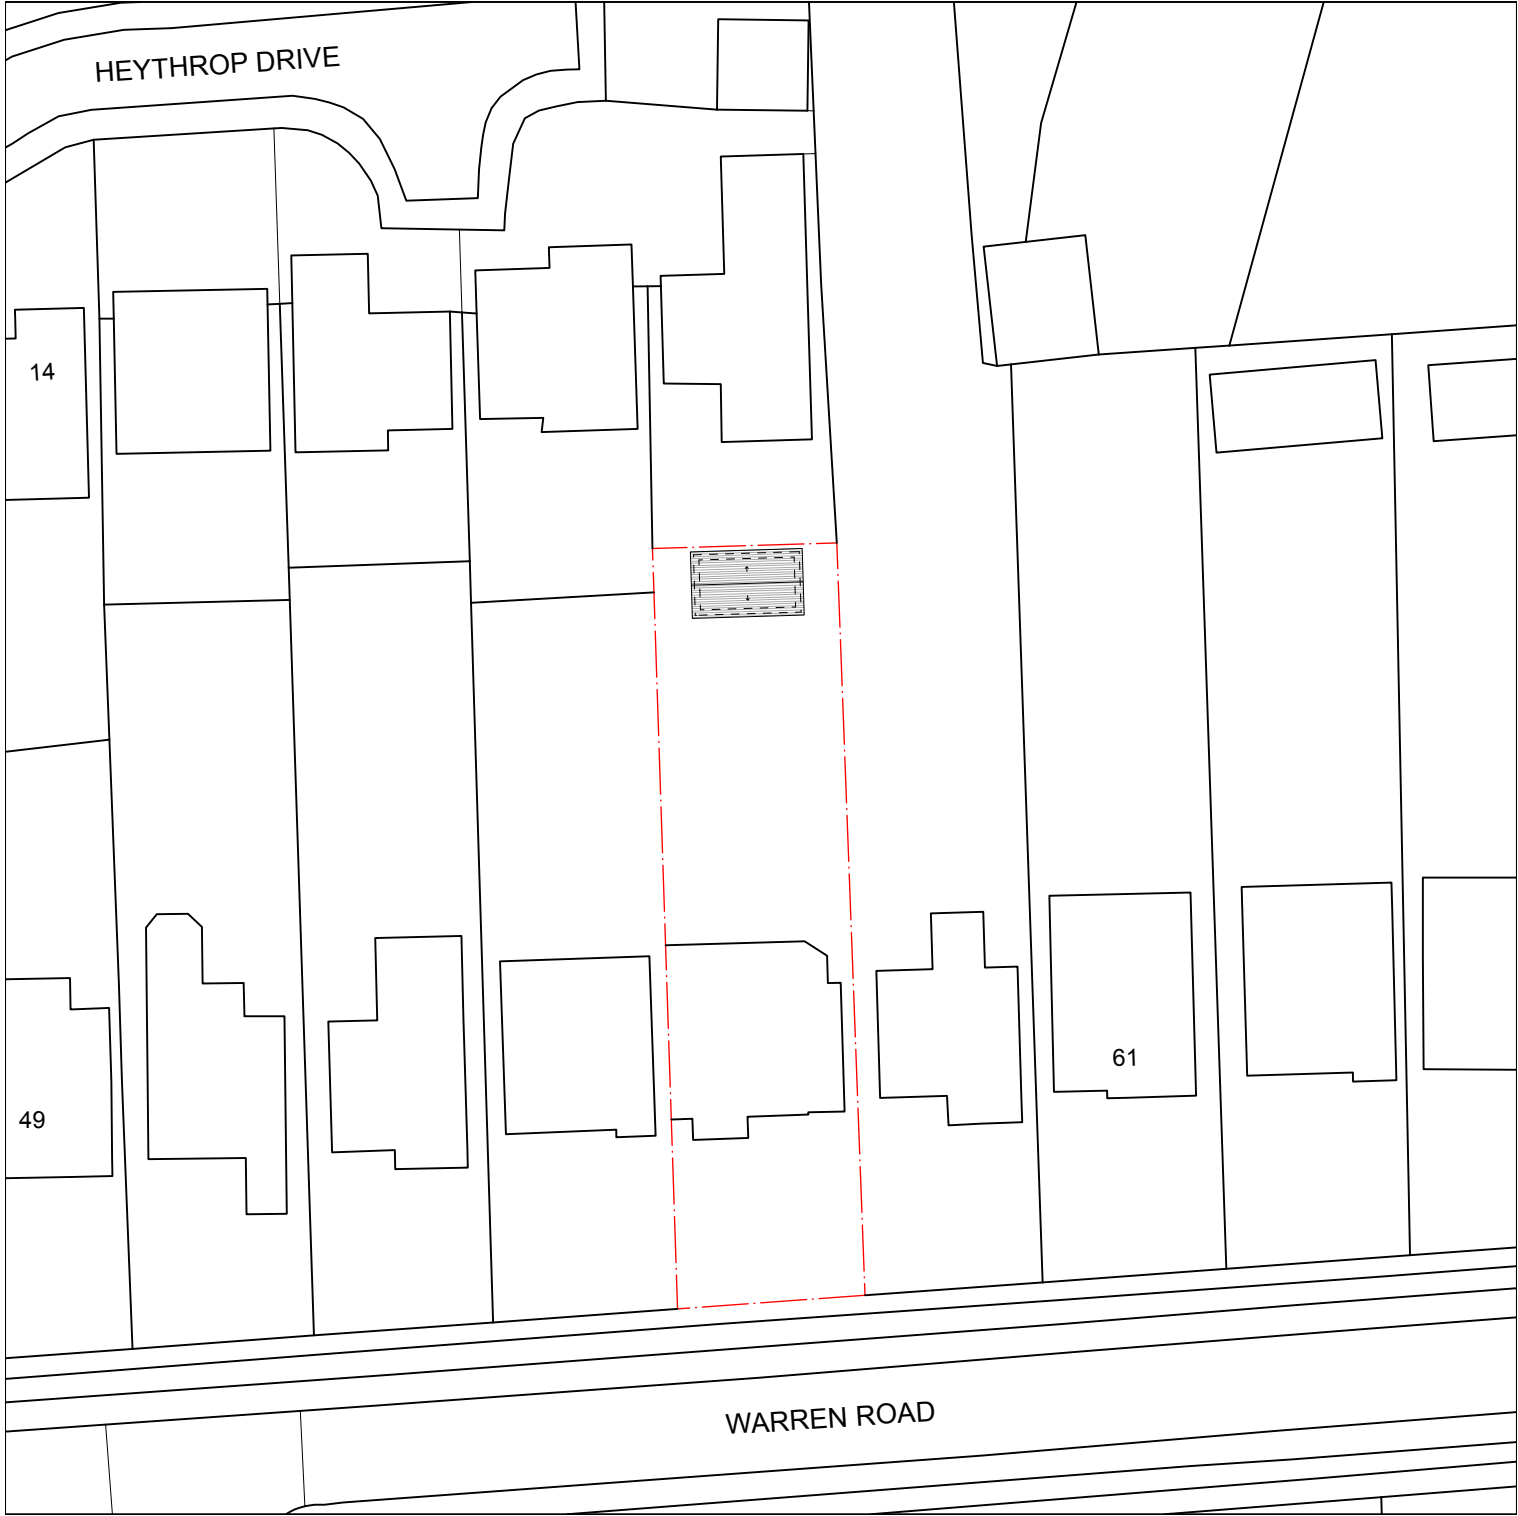

-	-	-	-	-
Revision notes				

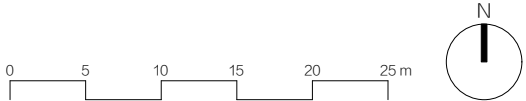



client
Mr Sukh Rauli

project
57 Warren Road, Ickenham, UB10 8AD

drawing
AS-BUILT: SITE PLAN

date March 2026	scale 1.500 at A3	project no 2026.014
work stage 1	drawing no S04	revision -

www.masonwoodgroup.co.uk
gc@masonwoodgroup.co.uk
020 7118 5040

AS-BUILT