



Notes


©Crown Copyright and database rights 2026 OS Licence  
no. AC0000849896

Site Area: 611.4m<sup>2</sup>




Revision notes
-
-
-
-

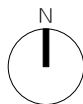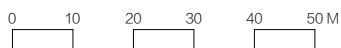


 <b>MASONWOOD</b> DESIGN <a href="http://www.masonwoodgroup.co.uk">www.masonwoodgroup.co.uk</a> <a href="mailto:gc@masonwoodgroup.co.uk">gc@masonwoodgroup.co.uk</a> 020 7118 5040	client <b>Mr Sukh Rauli</b>	project <b>57 Warren Road, Ickenham, UB10 8AD</b>	drawing <b>SITE LOCATION PLAN</b>
	date <b>March 2026</b>	scale <b>1.1250 at A4</b>	project no <b>2026.014</b>
	work stage <b>1</b>	drawing no <b>S01</b>	revision <b>-</b>

Notes

0.000 Levels

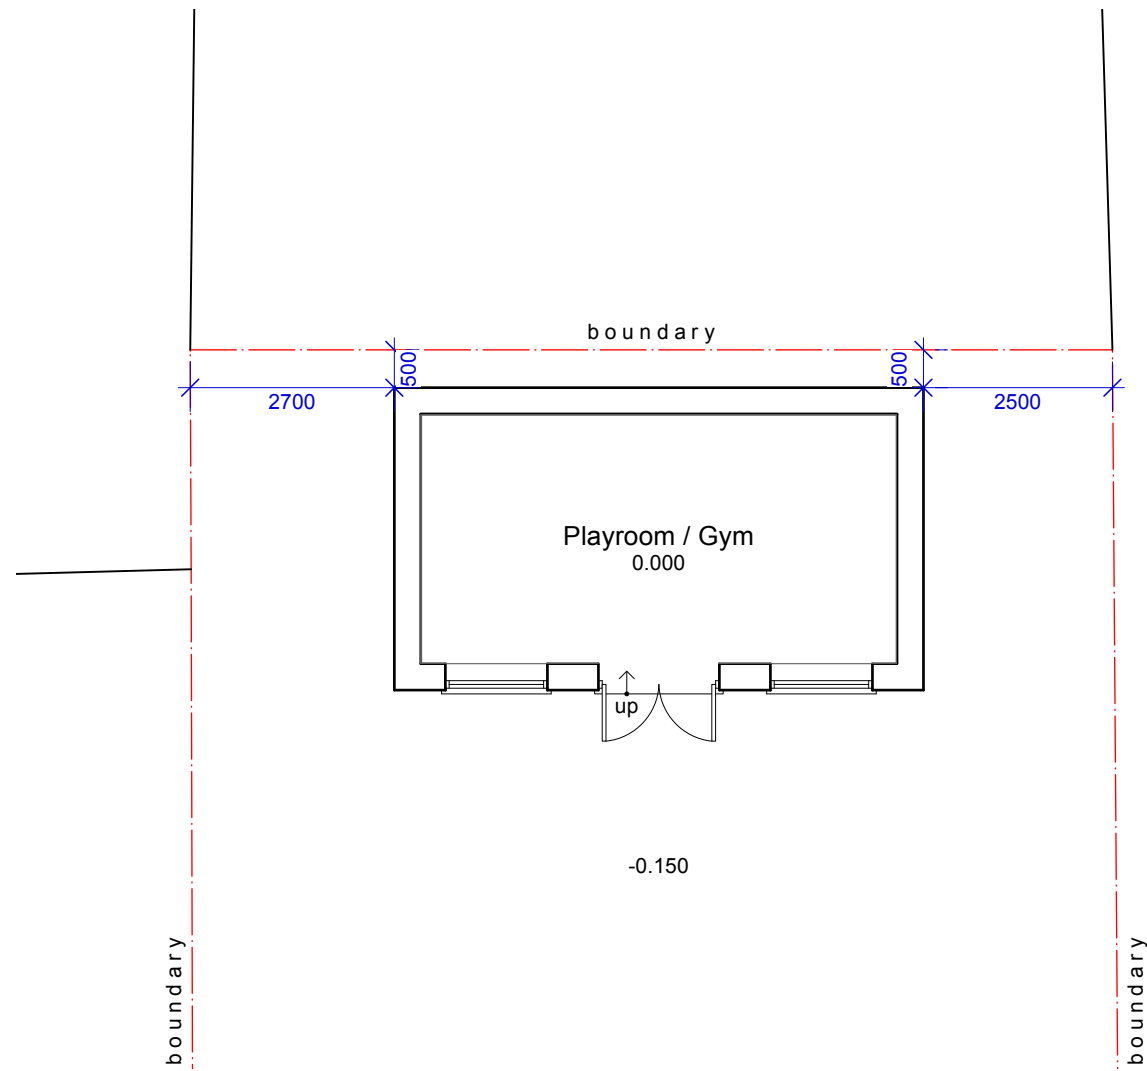

AS-BUILT:  
GROUND FLOOR PLAN

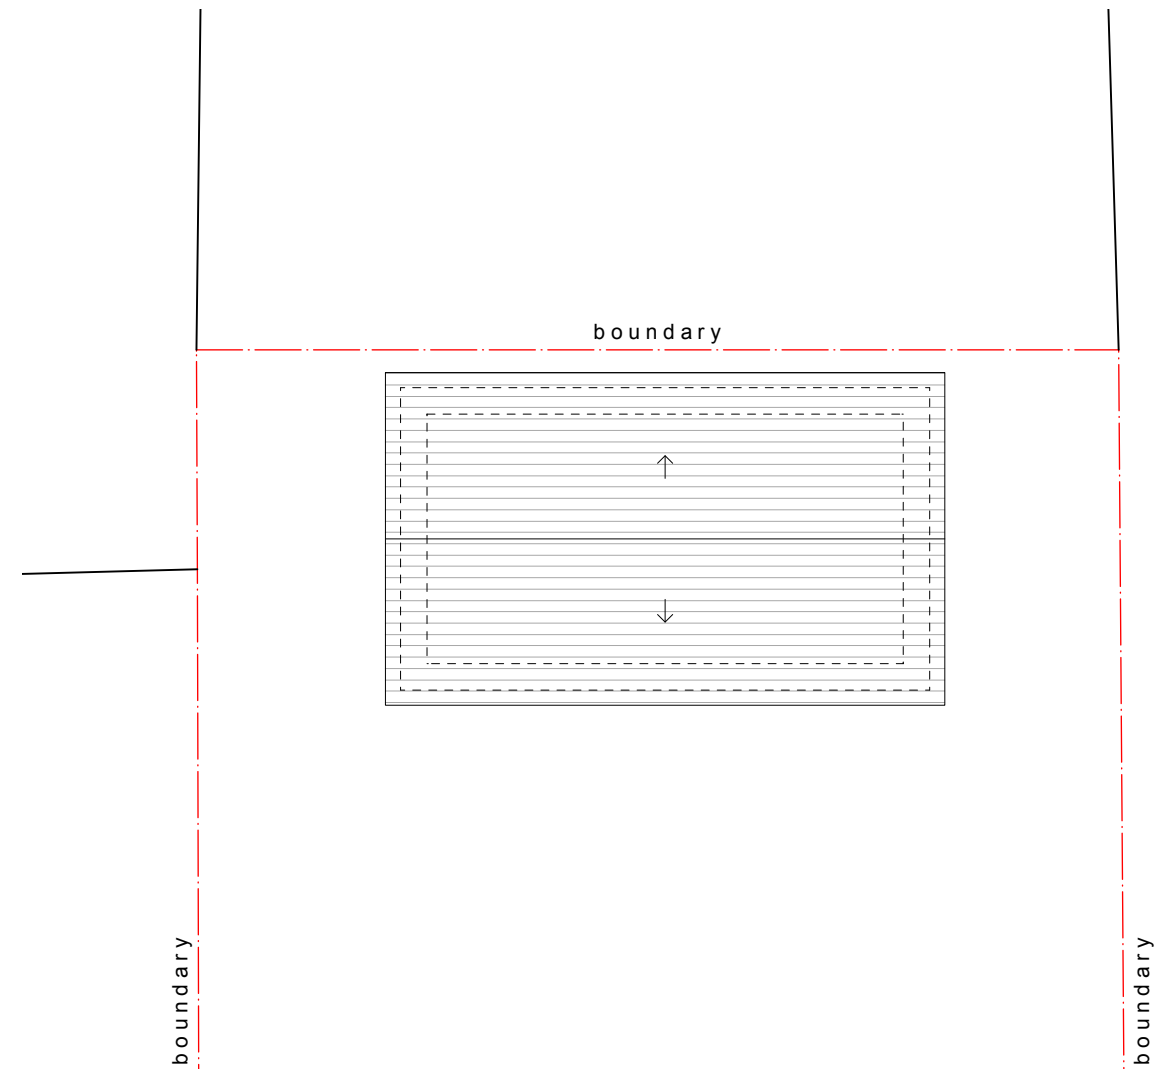


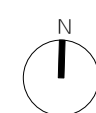
AS-BUILT:  
FIRST FLOOR PLAN

AS-BUILT

Revision	Date	By	Notes
A	01/04/26	GC	Annotations added

Revision notes





	client	Mr Sukh Rauli	
	project	57 Warren Road, Ickenham, UB10 8AD	
drawing	AS-BUILT: FLOOR PLANS		
date	March 2026	scale	1:100 at A3
www.masonwoodgroup.co.uk	gc@masonwoodgroup.co.uk	work stage	1
020 7118 5040		drawing no	S02
		project no	2026.014
		revision	A



Notes

Brickwork and tiles to match main dwelling shown hatched.


As built gutter, fascia, eaves and glazing to match main dwelling.

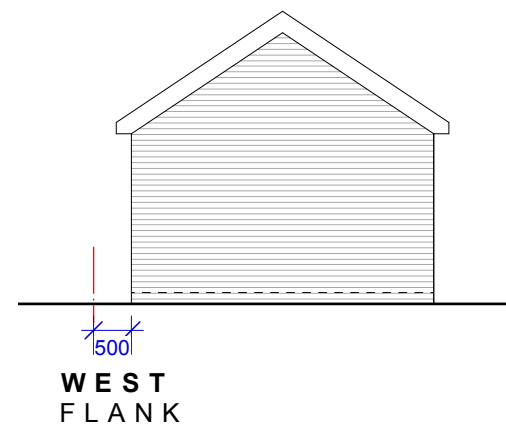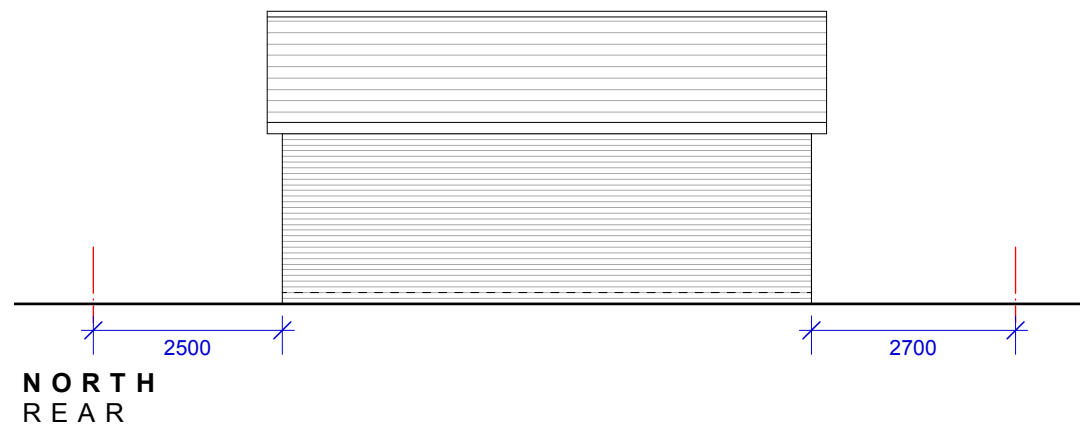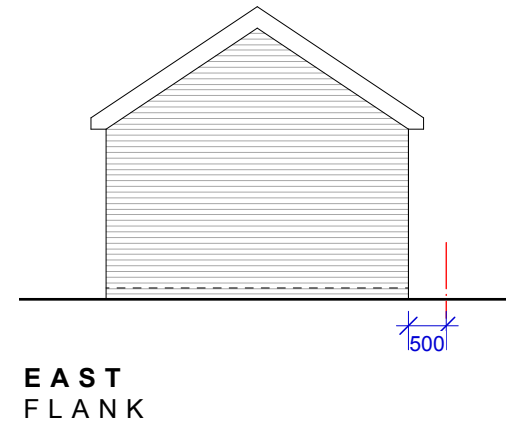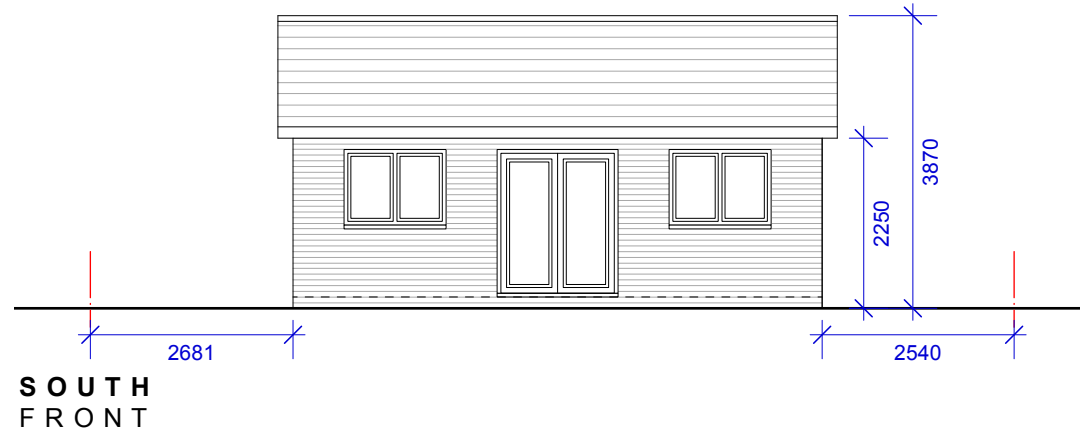

Revision notes
-
-
-
-


AS-BUILT



 <p>MASONWOOD DESIGN</p> <p>www.masonwoodgroup.co.uk gc@masonwoodgroup.co.uk 020 7118 5040</p>	client Mr Sukh Rauli	project 57 Warren Road, Ickenham, UB10 8AD	
	drawing AS-BUILT: ELEVATIONS		
	date March 2026	scale 1:100 at A3	project no 2026.014
	work stage 1	drawing no S03	revision -


Notes


0.000 Levels

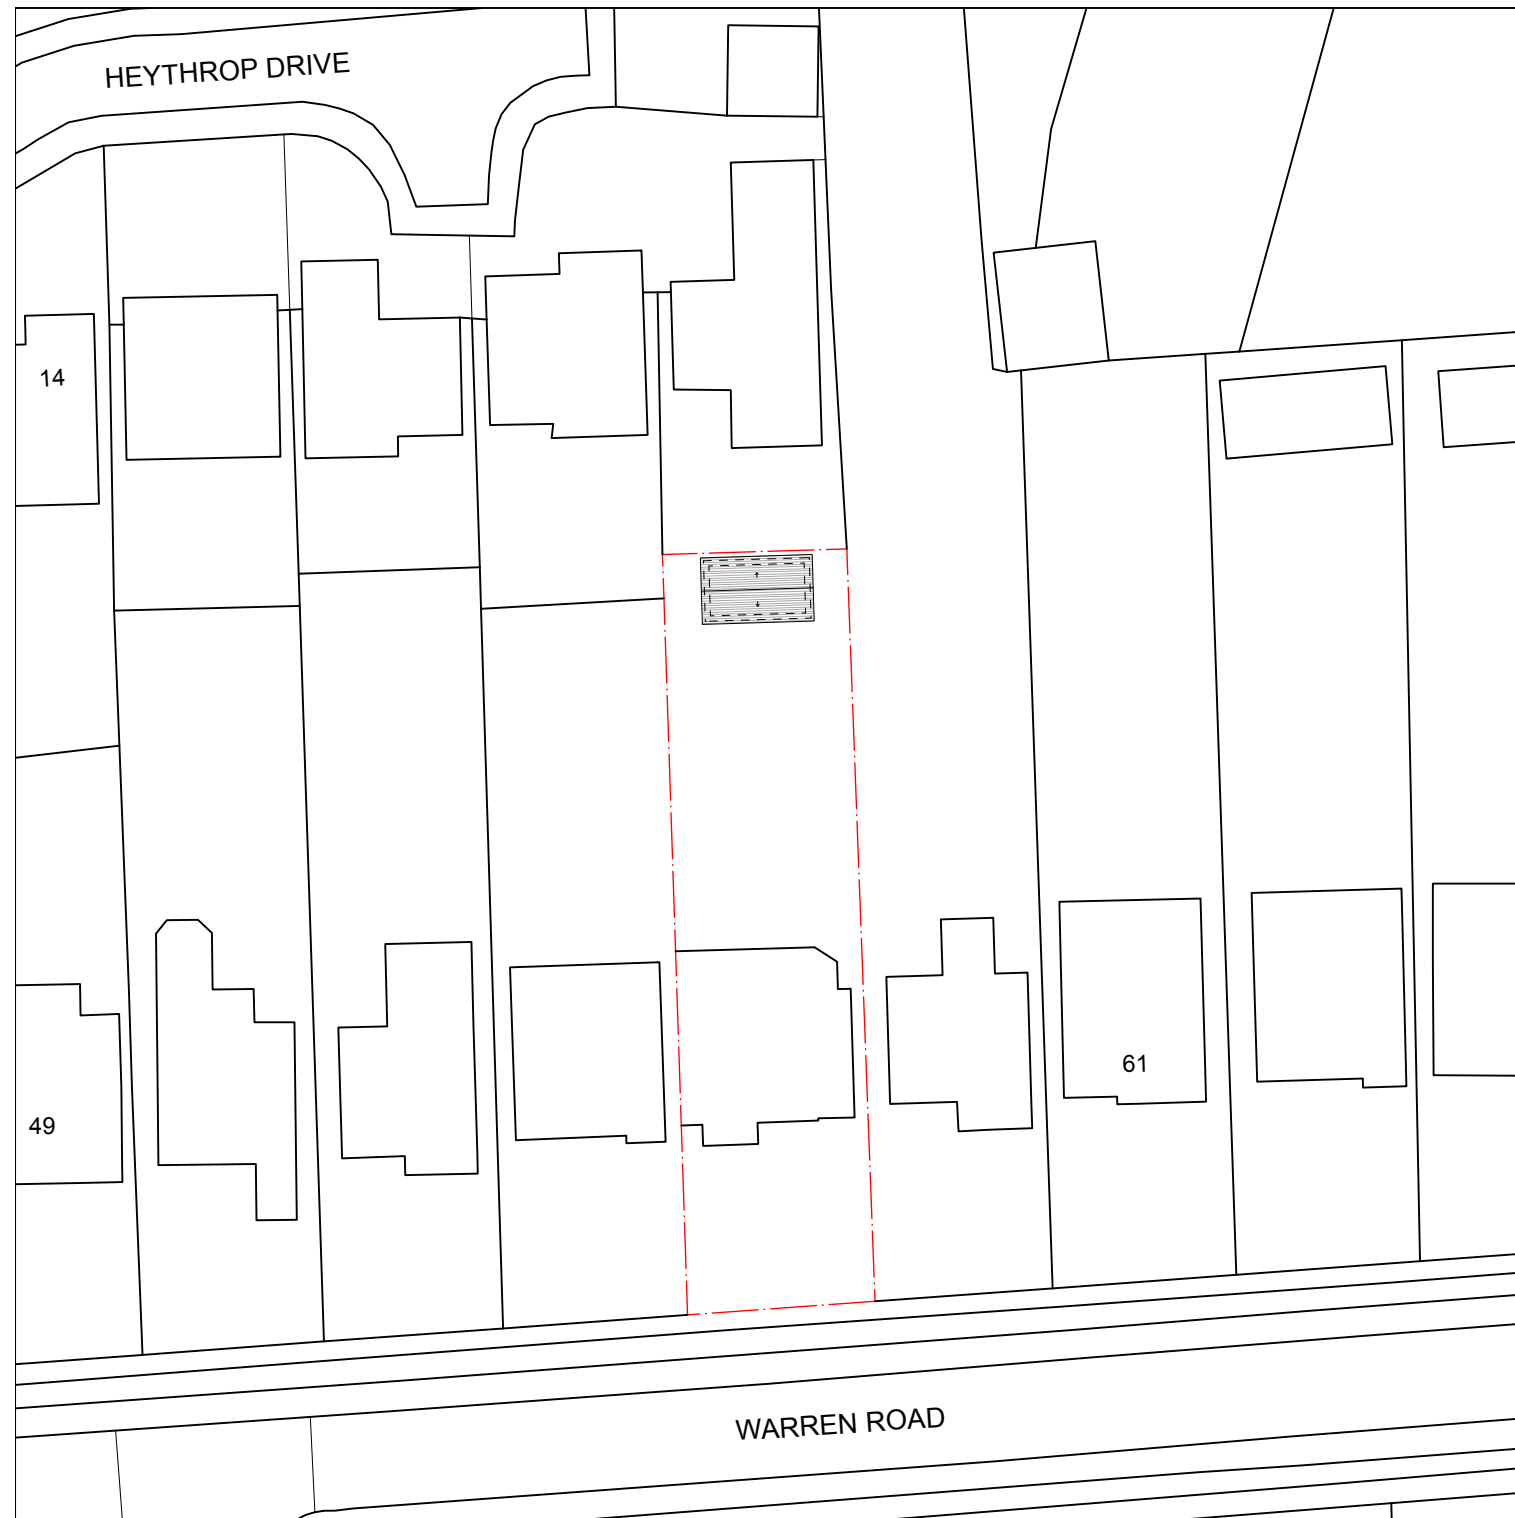

Revision notes	
-	-
-	-
-	-

AS-BUILT

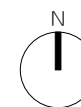

	client	Mr Sukh Rauli					
	project	57 Warren Road, Ickenham, UB10 8AD					
	drawing	AS-BUILT: SITE PLAN					
	date	March 2026	scale	1:500 at A3			
www.masonwoodgroup.co.uk	gc@masonwoodgroup.co.uk	work stage	1	project no	2026.014	revision	-
020 7118 5040							