

Metres




SCALE 1 : 100


REV/NOTES:

Where building to the boundaries the adjacent owner is to be informed under the terms of the Party Wall Act 1996 and its provisions followed. Where building over boundaries the adjacent owner is to be served notice under section 65 of the Town & Country Planning Act 1990.

© This drawing and the works depicted are the copyright of ASB PROPERTY CONSULTANTS LTD and may not be reproduced or amended except by written permission of ASB PROPERTY CONSULTANTS LTD.

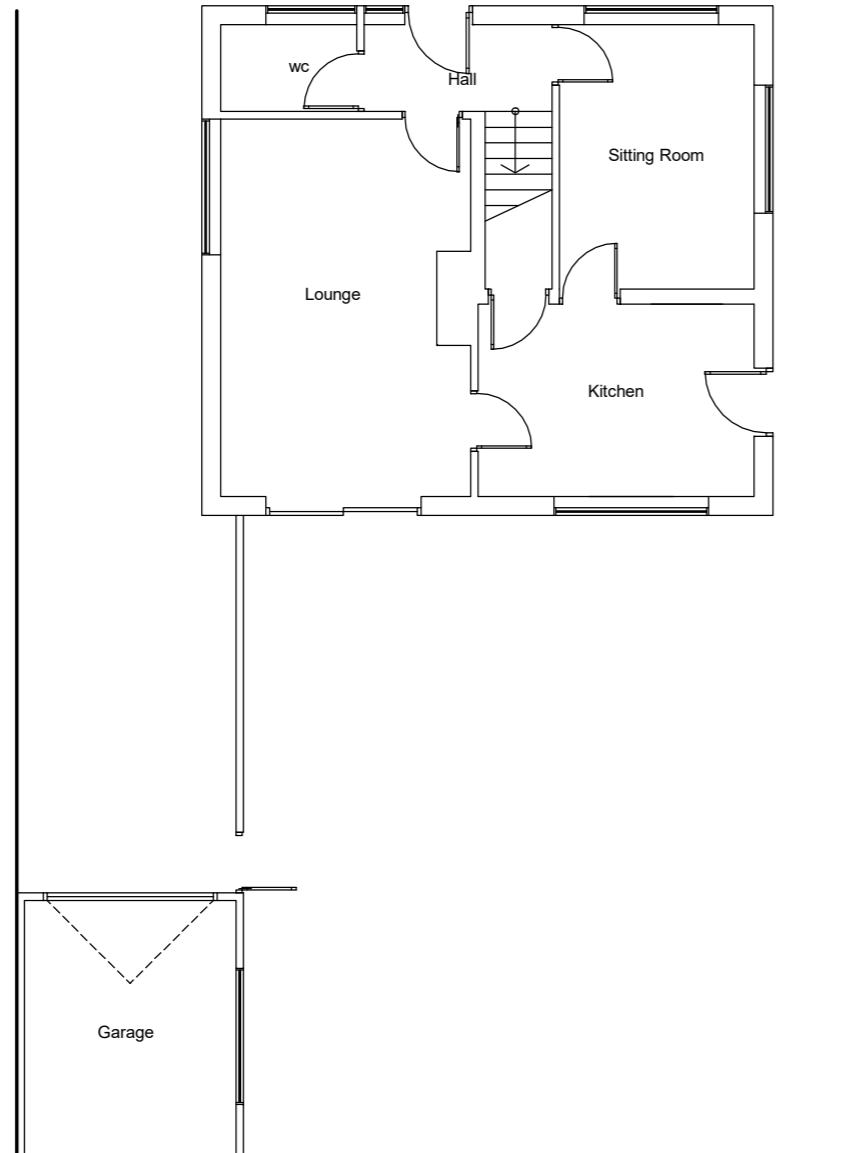

PRE EXISTING GF PLAN
Scale 1:100

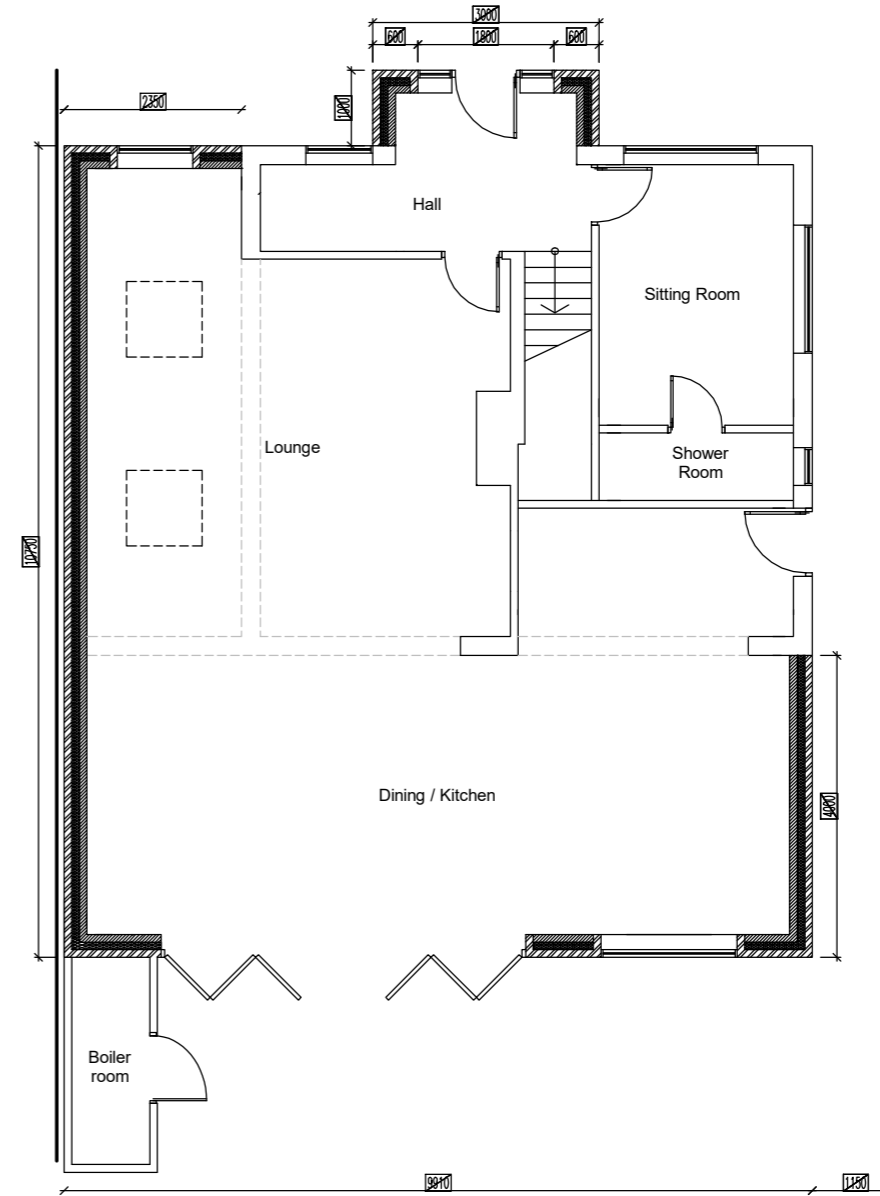

AS BUILT GF PLAN
Scale 1:100

Application: HPA – Retention of ground floor side and rear extension including rear boiler room		
Client:	SUKHWINDER SINGH CHANDI	Date: 19 TH Feb 2026
Site:	102 Sipson Road, West Drayton, UB4 8QW	Drawn By: Gurps Benning
Scale:	Refer to Drawing @ A3	Dwg.No: ASB1082 – 01

ASB PROPERTY CONSULTANTS LTD
Planning consultants and Surveyors

Spaces
 100 Avebury Boulevard
 Milton Keynes Tel : 07854 351 934 - 0808 139 1383
 MK9 1FH Email : asb@gtdesignzLtd.com

Copyright © 2026 ASB PROPERTY CONSULTANTS LTD
 (All rights reserved)