


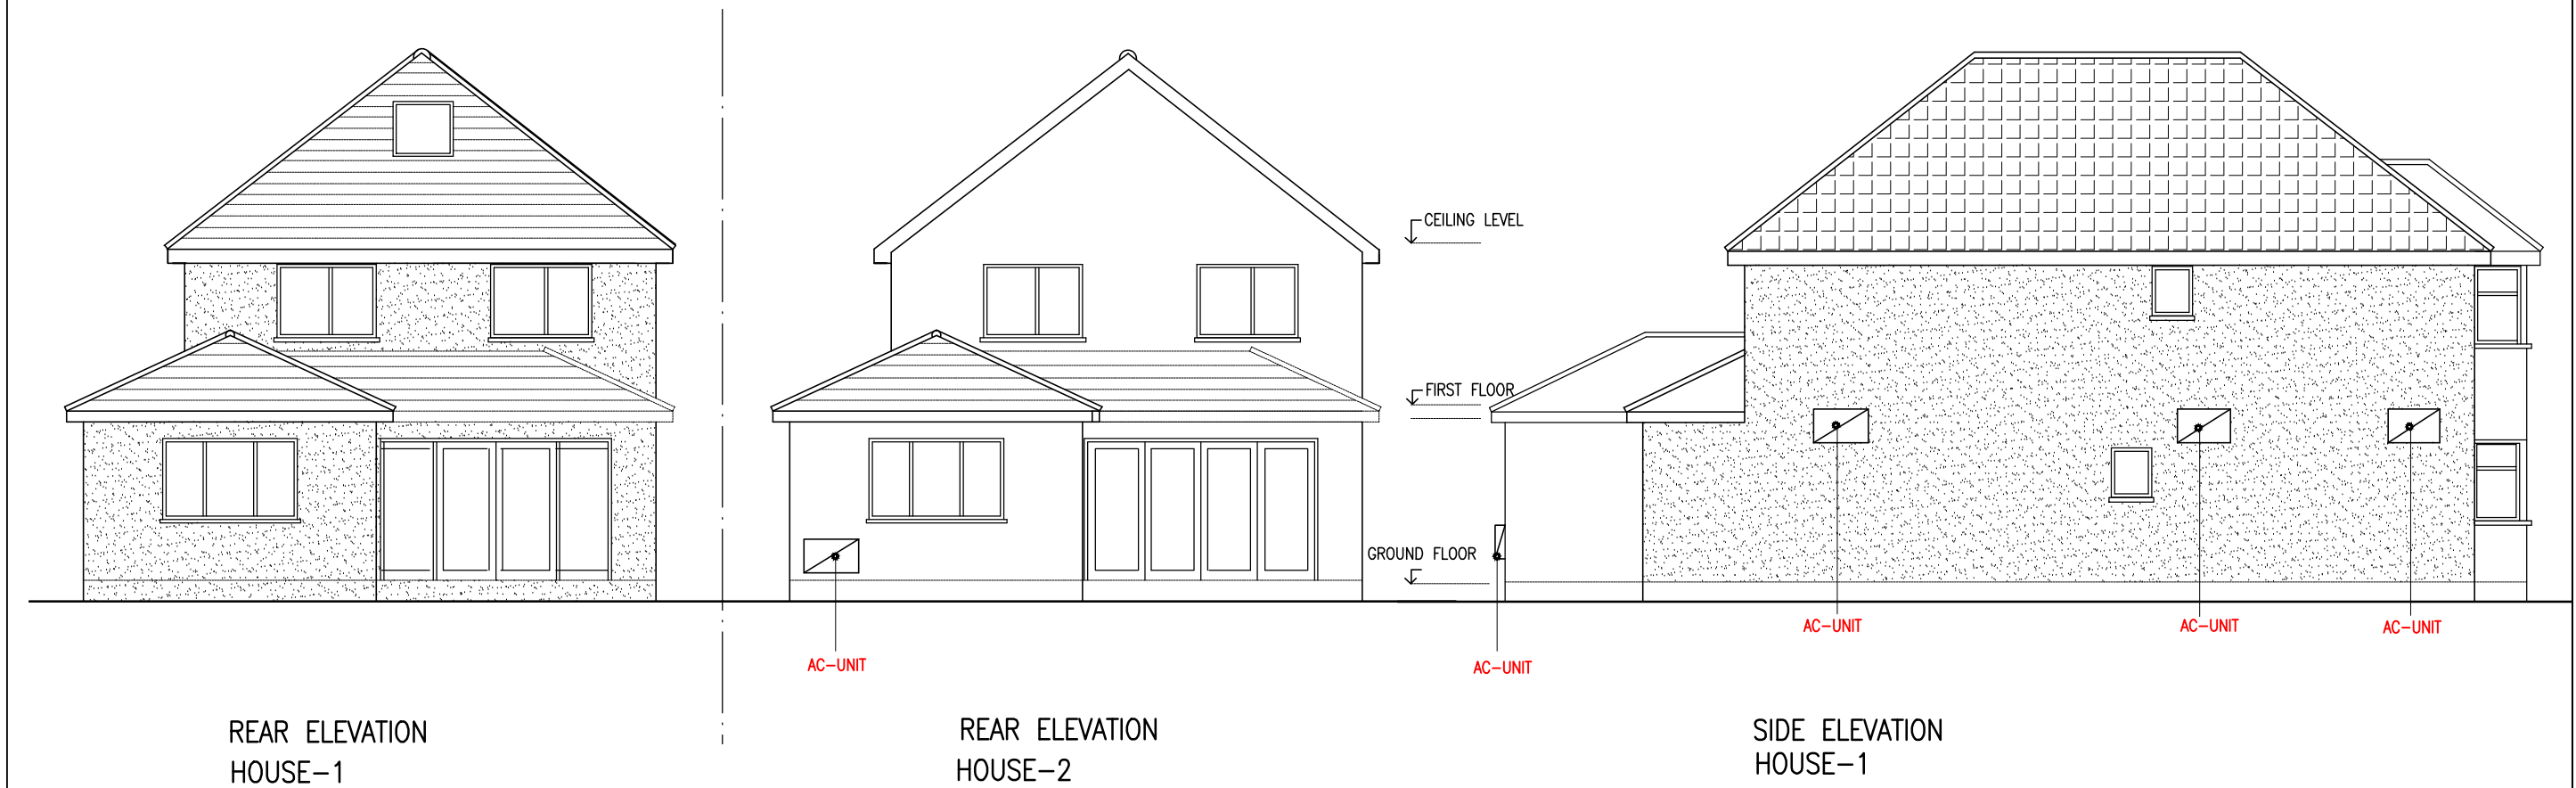

|                                                                                                           |  |                   |                            |                                                                                                   |      |
|-----------------------------------------------------------------------------------------------------------|--|-------------------|----------------------------|---------------------------------------------------------------------------------------------------|------|
| Project                                                                                                   |  | Drawing           |                            | HR ARCHITECTURAL CONSULTANTS LTD                                                                  |      |
| PROPOSED EXISTING HOUSE TO BE REPLACED WITH<br>NEW 2NO. HOUSES AT 20 FRAYS AVENUE WEST DRAYTON<br>UB7 7AF |  | ELEVATIONS        |                            | 5 beverley avenue,Hounslow, Middx. tw4 5hf<br>tel.-07813254905<br>e-mail- r.s.chana@hotmail.co.uk |      |
| POSITIONS OF AC UNITS AS BUILT                                                                            |  | Scale<br>1/100@A3 | Date<br>SEPT.2023<br>Drawn | Drawing No.<br>P/375/H3                                                                           | Rev. |