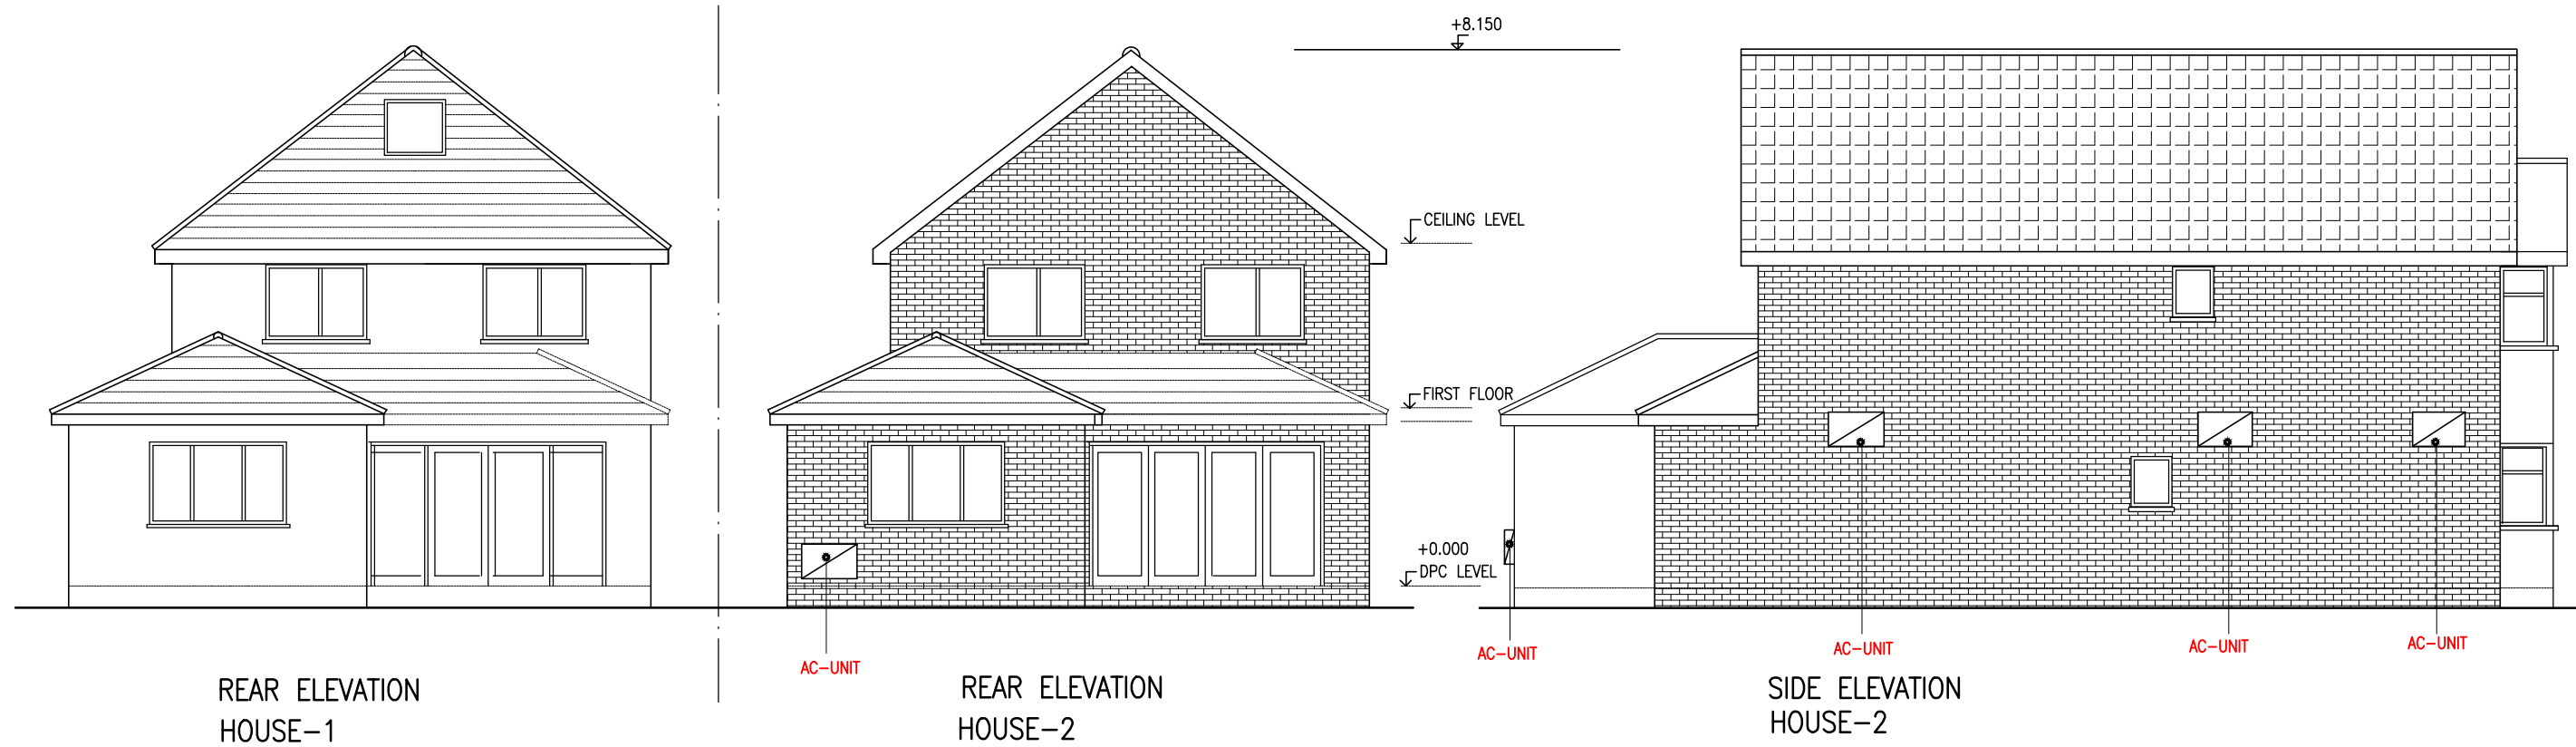
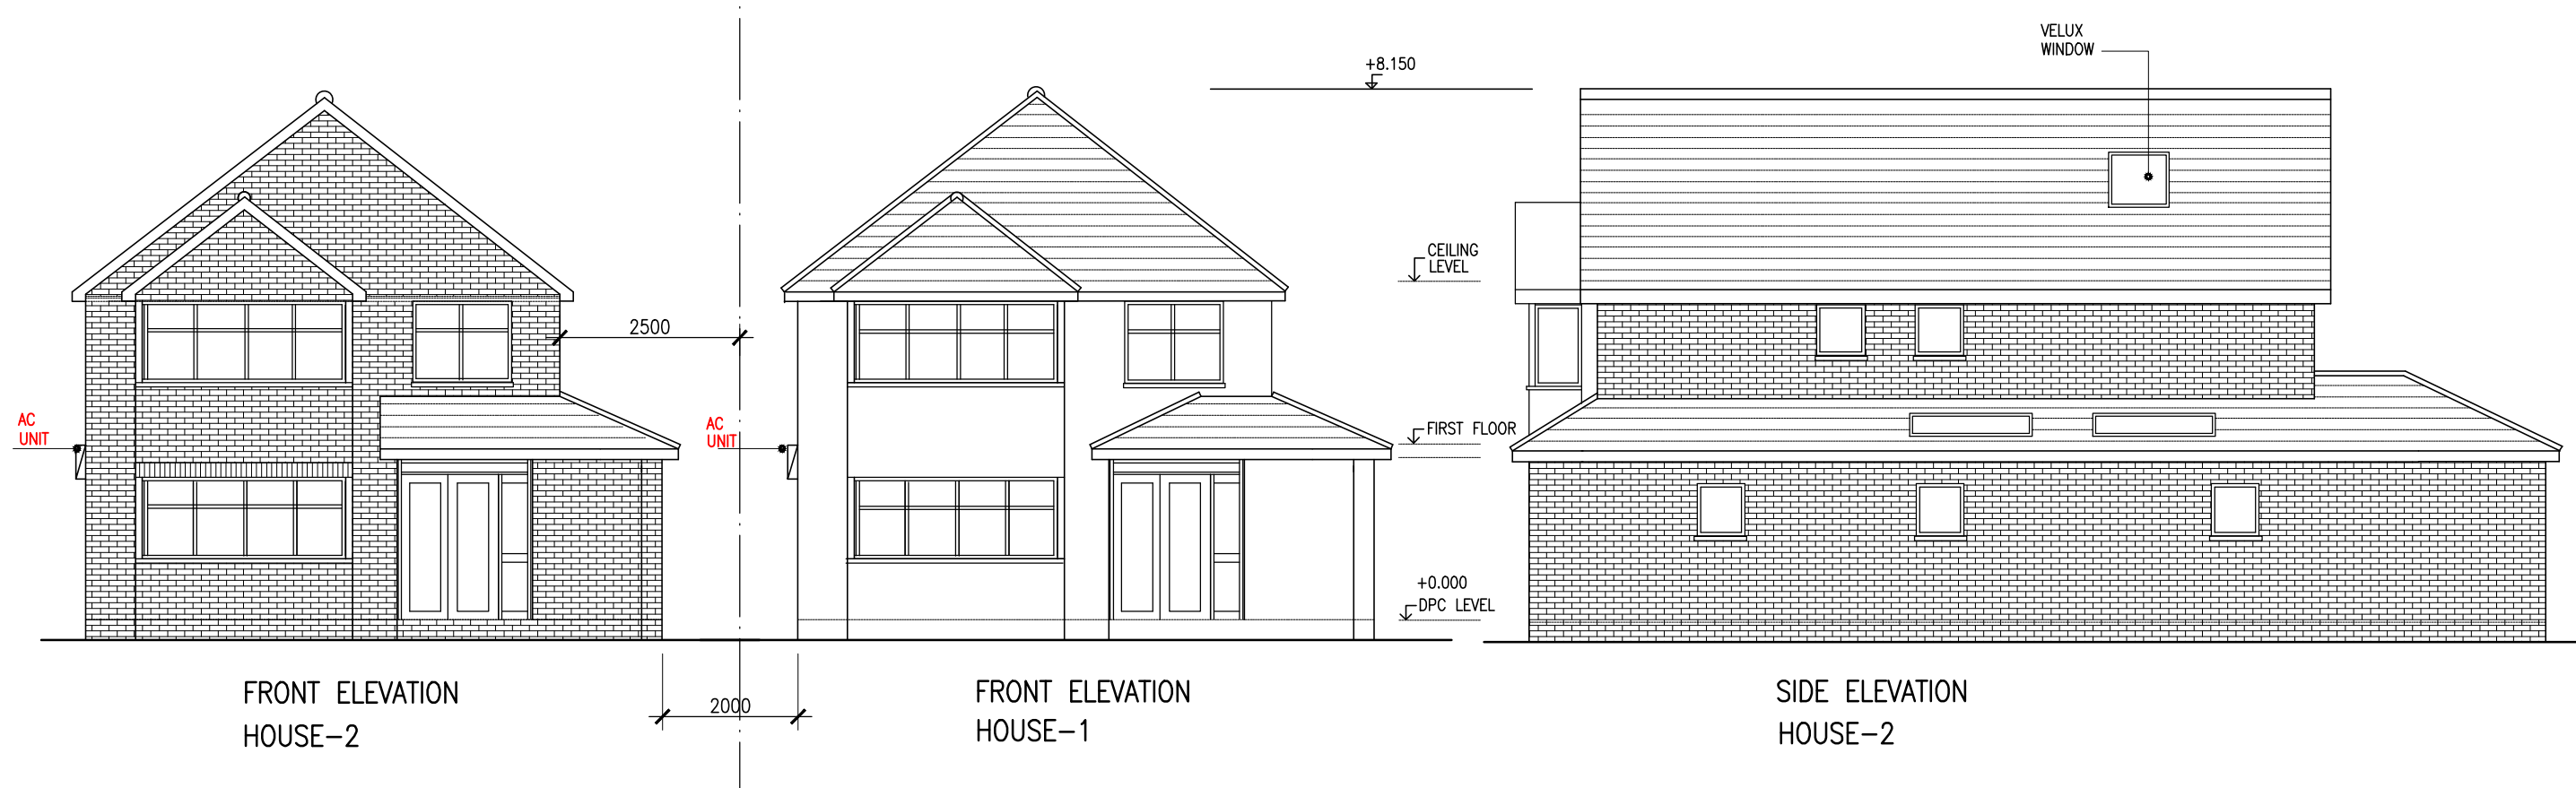


Project		Drawing		HR ARCHITECTURAL CONSULTANTS LTD	
PROPOSED EXISTING HOUSE TO BE REPLACED WITH		ELEVATIONS		5 beverley avenue, Hounslow, Middx. TW4 5HF	
NEW 2NO. HOUSES AT 20 FRAYS AVENUE WEST DRAYTON		Scale		tel. - 07813254905	
UB7 7AF		1/100@A3		e-mail - r.s.chana@hotmail.co.uk	
POSITIONS OF AC UNITS AS BUILT		Date	SEPT.2023	Drawing No.	P/375/H4
		Drawn		Rev.	