


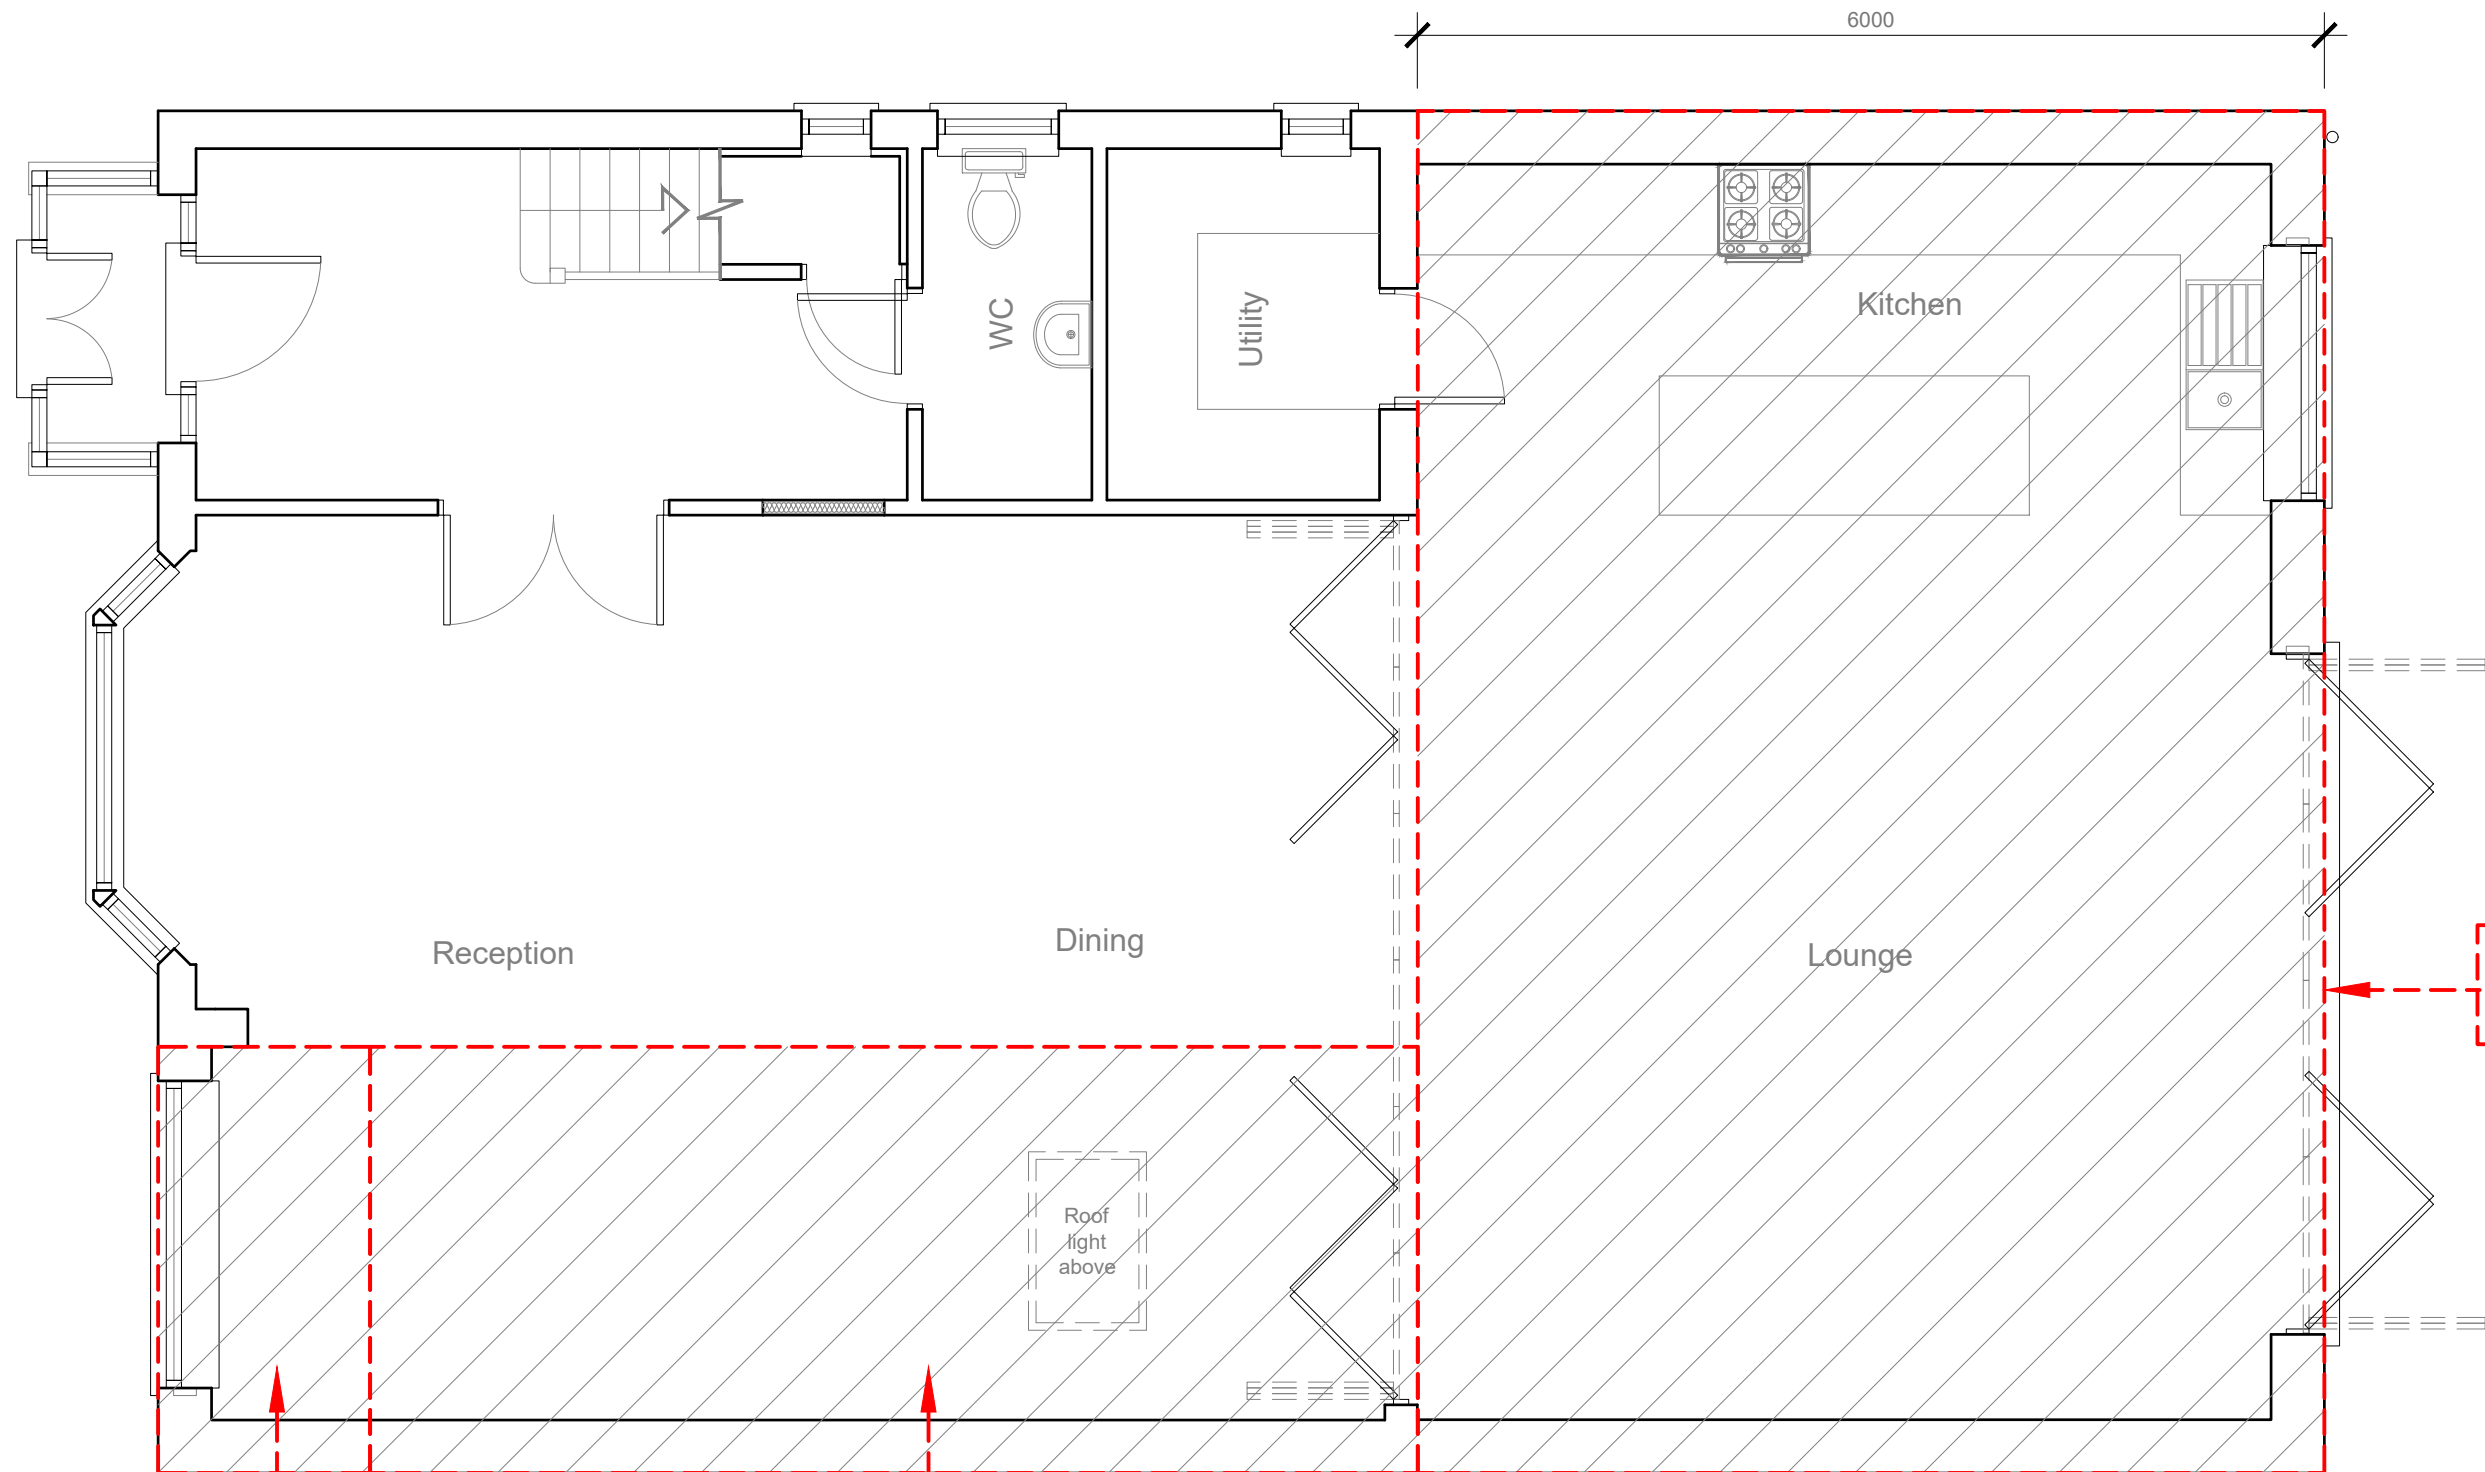



AS-BUILT
GROUND FLOOR PLAN 1:50

Approved Application Ref
No : 17133/APP/2020/4297

Approved Application Ref
No : 17133/APP/2020/4297

1:50

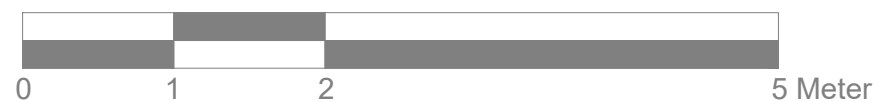

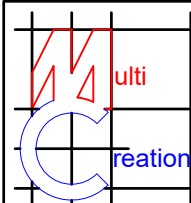
	Project: 86 Copthall Road West Ickenham Uxbridge UB10 8HT	Title: As-Built Ground floor plan	Scale: 1:50 @ A3
			Date: Dec 2020
			Drawing No.: 3469/ALL-11/SP
			Revision
239 Western Road, Southall, Middx, UB2 5HS Tel: 020 8571 1369 info@multicreation.co.uk			

Dormer Approved Application Ref No :
17133/APP/2020/4297



AS-BUILT
FRONT ELEVATION 1:100


Dormer Approved Application Ref No :
17133/APP/2020/4297

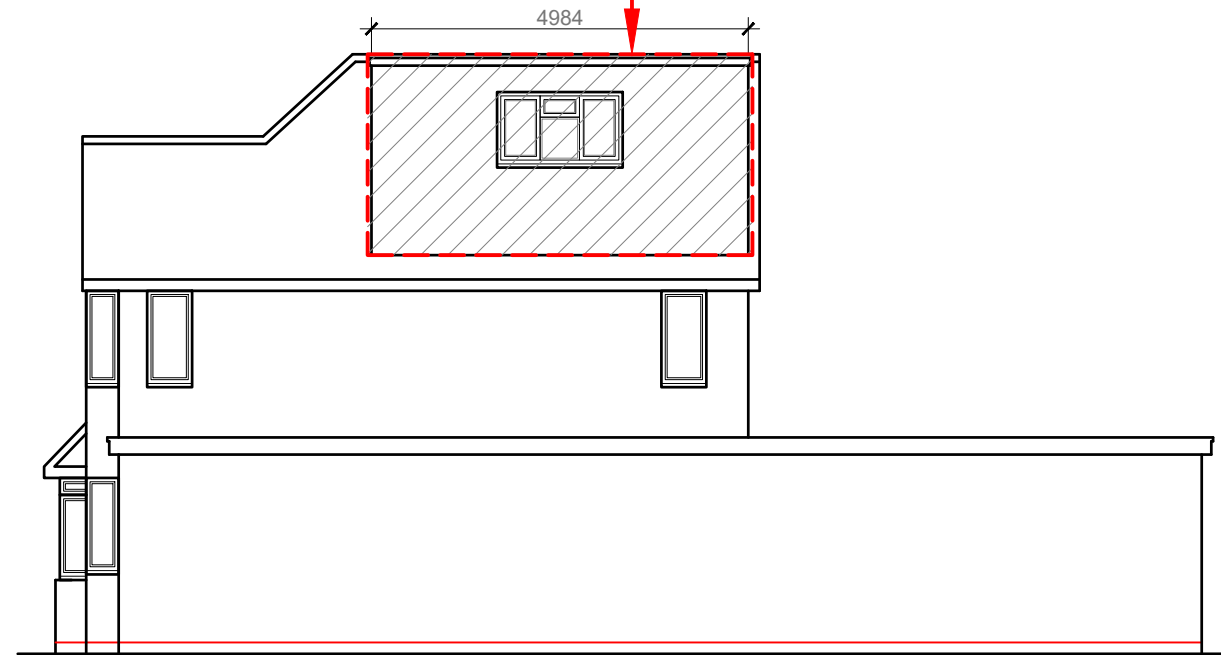

AS-BUILT
SIDE ELEVATION 1:100




AS-BUILT
REAR ELEVATION 1:100

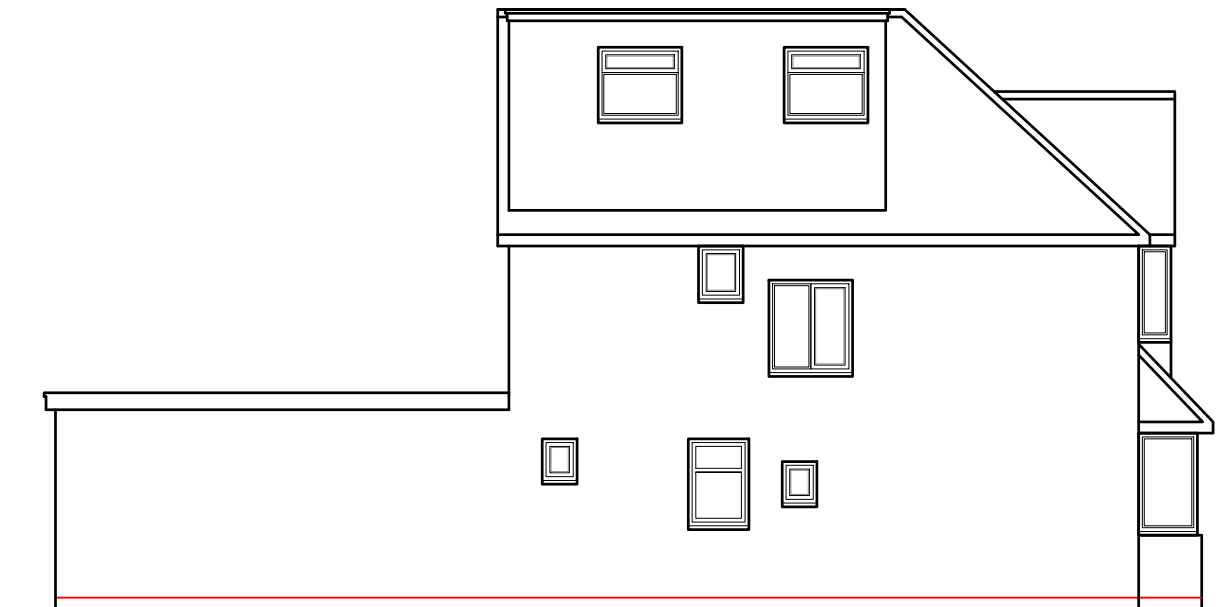

AS-BUILT
SIDE ELEVATION 1:100

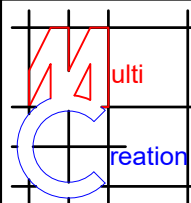

	Project:	Title:	Scale: 1:100 @ A3					
	86 Copthall Road West	As-Built Elevations	Date: Dec 2020					
	Ickenham		Drawing No.:					
	Uxbridge		3469/ALL-14/SP					
	UB10 8HT		Revision					
<table><tr><td></td><td></td><td></td><td></td><td></td></tr></table>								
239 Western Road, Southall, Middx, UB2 5HS Tel: 020 8571 1369 info@multicreation.co.uk								