



AS BUILT SIDE ELEVATION

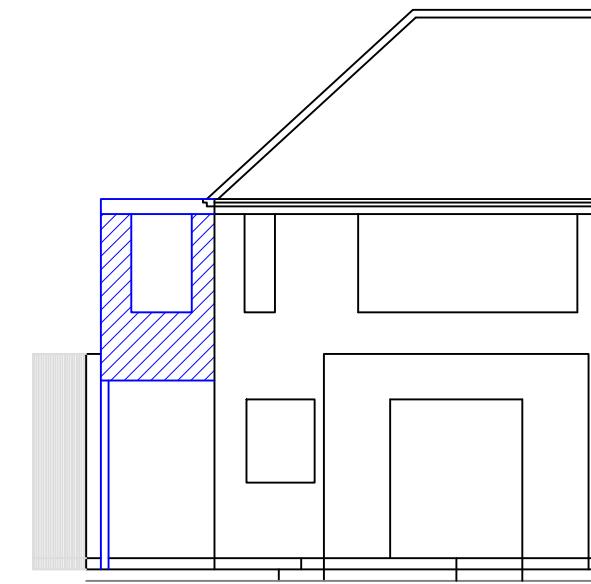

AS BUILT REAR ELEVATION

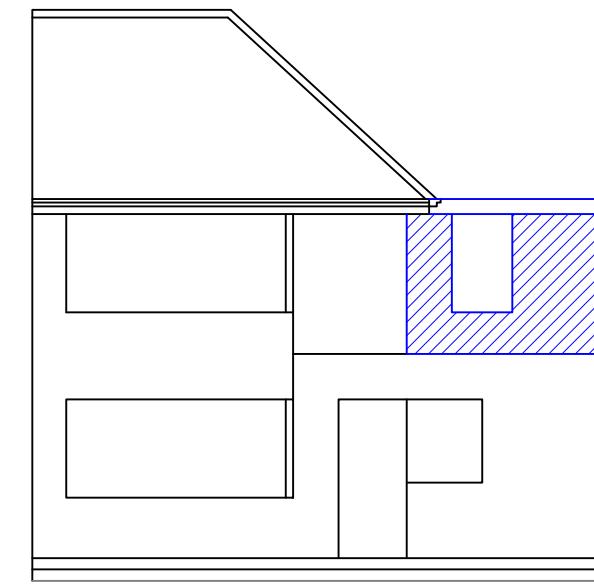

AS BUILT FRONT ELEVATION

SCALE= 1:100 @ Paper size A3  
  
0 10m

H S PLANNING LTD  
HEMEN SUTHAR  
CONSULTING ENGINEER  
07940222723  
hsplanningltd@yahoo.com



PROPOSAL:  
Single storey side extension at  
FF with structural column and  
beam for the same at GF

DATE: 15/01/2023  
REVISION:  
FOR PLANNING ONLY

SITE:  
15 LYNHURST CRESCENT

AS BUILT ELEVATION  
15/LYNH/006