


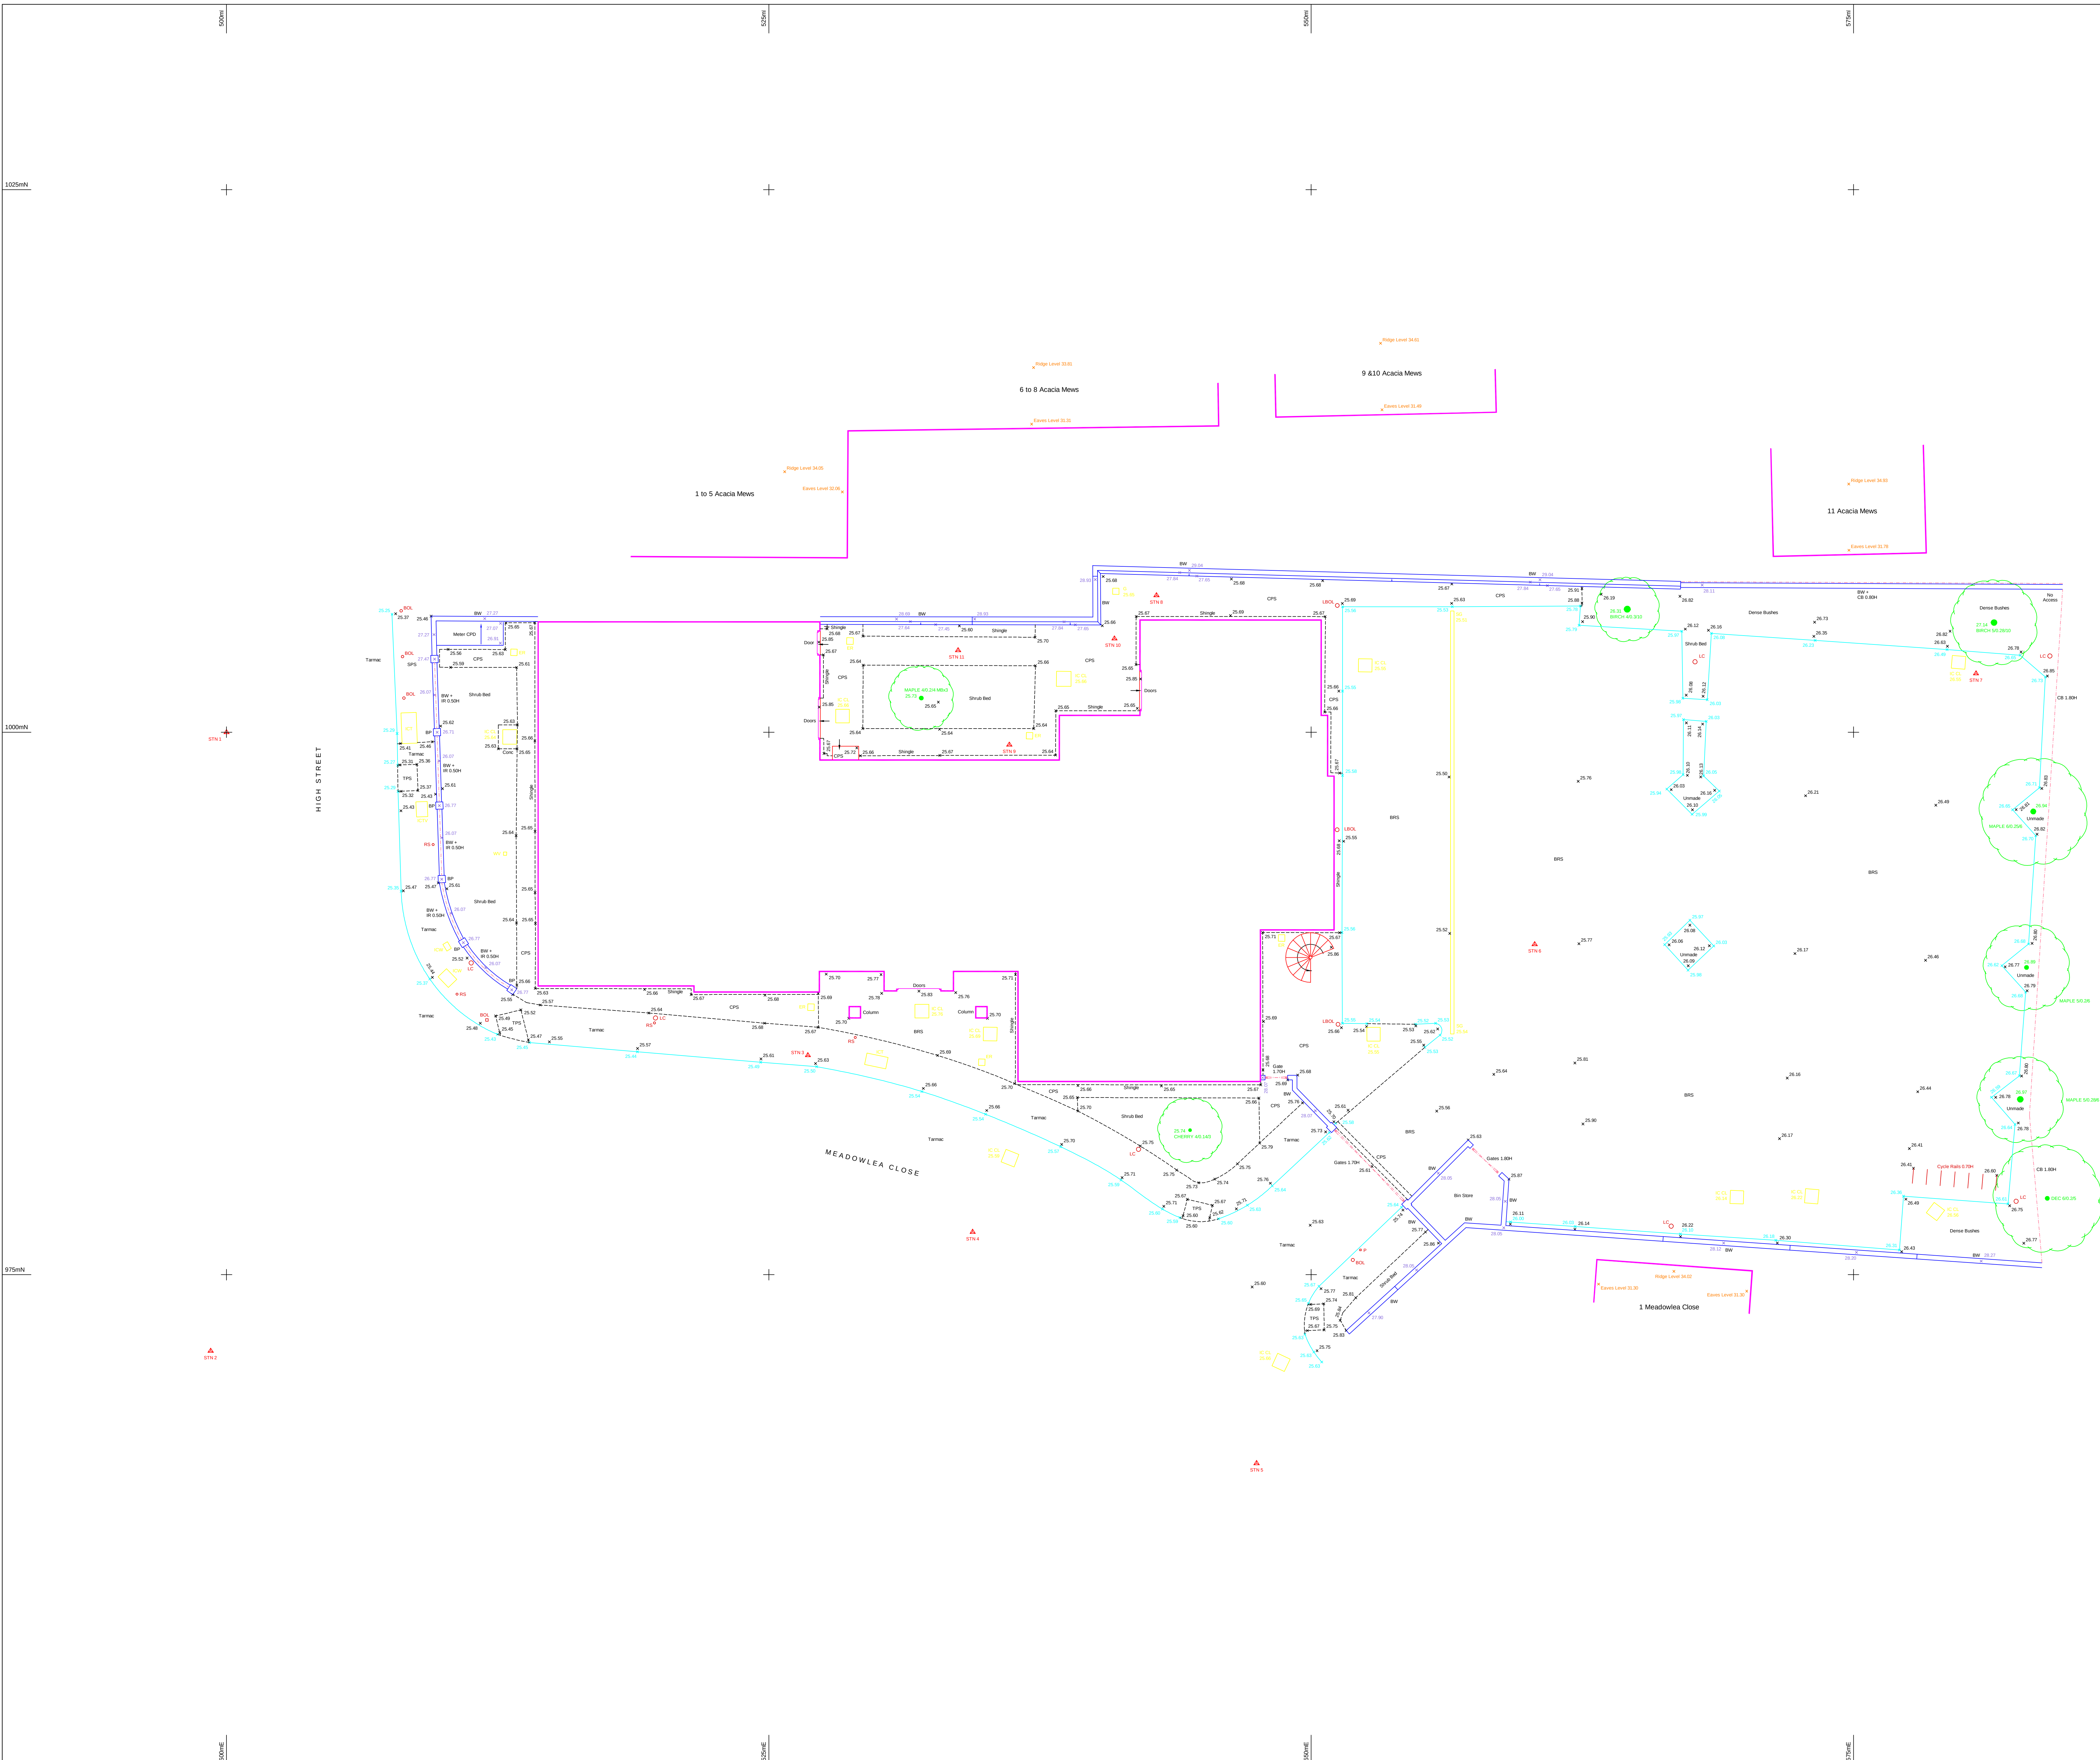

LEGEND			
BEI	Belkita Beacon	BWP	Rawwater Pipe
BOL	Bollard	SB	Shrub Bed
BRS	Brick Sinks	SG	Single Gully
BS	Brick Sinks	SH	Shrub Plant
BSH	Bus Shelter	SP	Stone Paving Slabs
CB	Canal	SR	Street Road Line
CC	Coal Chute	STN	Survey Station
CH	Chair Hatch	SV	Single Valve
CL	Clamp	SVL	Single Valve Line
CONC	Concrete	SYL	Single Yellow Line
CPS	Concrete Paving Slabs	TCB	Telephone Call Box
CY	Cyprus	TC	Telephone Cabinet
CV	Cable TV	TP	Telephone Pole
DRL	Double Red Line	TPS	Telephone Paving Slabs
DY	Double Yellow Line	TR	Telephone
DL	Double Yellow Line	UM	Urmide
EL	Excess Level	UTL	Unable To Lift
EW	Electricity	UV	Underground Valve
FB	Flow Back	VP	Vertical Pipe
FR	Fire	W	Water
FL	Flow Line	WW	Water Valve
G	Gully		
GRS	Grass Grates		
GV	Gas Valve	FENCES & WALLS:	
H	High	BAW	Barbed Wire
HC	High Capacity	BBW	Brickwork Wall
HCE	HC Electric	BP	Brick Pillar
ICE	IC Gas	BR	Brick Retaining Wall
ICF	IC Traffic Control	CB	Crack
ICF	IC Traffic Control	CB	Crack
ICTV	IC Cable TV	CB	Crack Boarded
ICW	IC Water	CC	Compacted Soil
IL	Iron Level	CLK	Chain Link
IR	Iron	CL	Chain Link
LBOL	LC Wall Lined	CRTW	Concrete Retaining Wall
LC	Literature Cabinet	CC	Concrete Wall
MG	Manhole Gully	GR	Gravel
OM	Overhead	HR	Handrail
P	Post	IR	Iron Railings
PS	Post Box	OS	Open Security
PDM	Pavement Display	OP	Open Boarded
PL	Pavedment Link	PR	Post & Rail
PM	Plaster	PS	Post & Rail
PP	Pavedment Push-point	SM	Steel Mesh
RE	Reading Sign	SW	Stone Wall
RL	Ridge	STL	Stairs
RS	Road	WM	Wire Mesh

TREES:


	Oak 10/0.4/12 Species Spread/Diameter/Height MB x 3 Multi-Bolt
---	--

NOTES :

The accuracy of this survey drawing is dependent upon the scale at which it is produced. Users should not re-scale this drawing

East Face, South East Angle, Hamondsworth Baptist Church;
Value 25.97m.

SURVEY STATIONS			
Reference	East	North	Elevation
1	500.000	1000.000	25.410
2	499.270	971.490	25.544
3	526.800	985.115	25.640
4	534.395	976.975	25.697
5	547.480	966.315	25.785
6	560.300	990.230	25.884
7	580.645	1002.710	26.570
8	547.870	1008.310	25.648
9	536.085	999.425	25.653
10	540.930	1004.320	25.644
11	533.720	1003.780	25.665

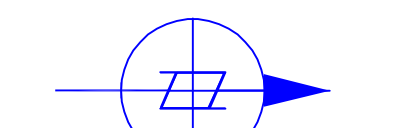

DRAWING NO : 4129-1

DATE: 12/8/19	DRAWN: SV
---------------	-----------

SHEET NO: 1 of 8 CHECKED: MAW

SCALE: 1:100 SHEET SIZE: A0

CLIENT:

TEJ Properties Ltd
PO Box 1250
St Albans
AL1 9JT
Tel: 07950 397412

PROJECT TITLE:
Topographic Survey
Duval House
Harmondsworth
London, UB7 0BT

SURVEYED BY:



ALAN RHODES ASSOCIATES
Land & Measured Building Surveyors
8 Hurlingham Studios
Ranelagh Gardens
London SW6 3PA

Tel : 020 7731 0304
Fax: 020 7731 0314
email : office@ara-survey.co.uk



