



45 DEGREE LINE OF SIGHT AS PER 6.22
HILLINGDON DESIGN AND ACCESSIBILITY
STATEMENT

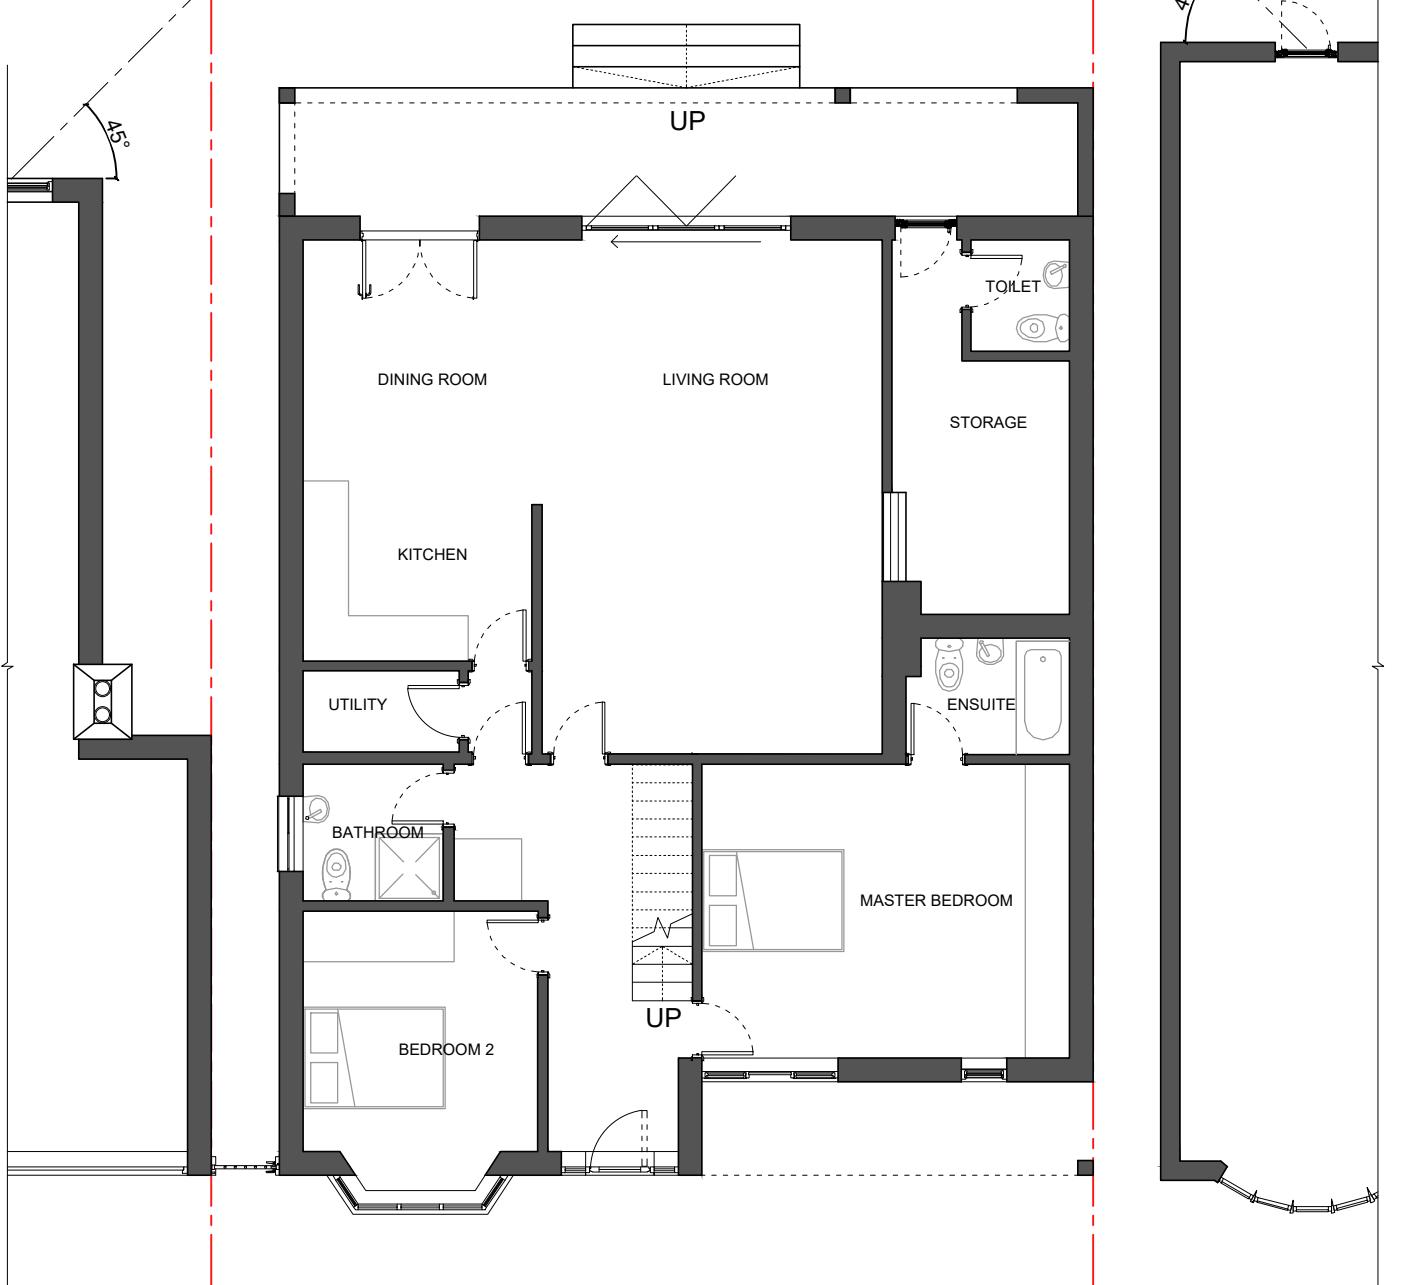

1 AS-BUILT GROUND FLOOR

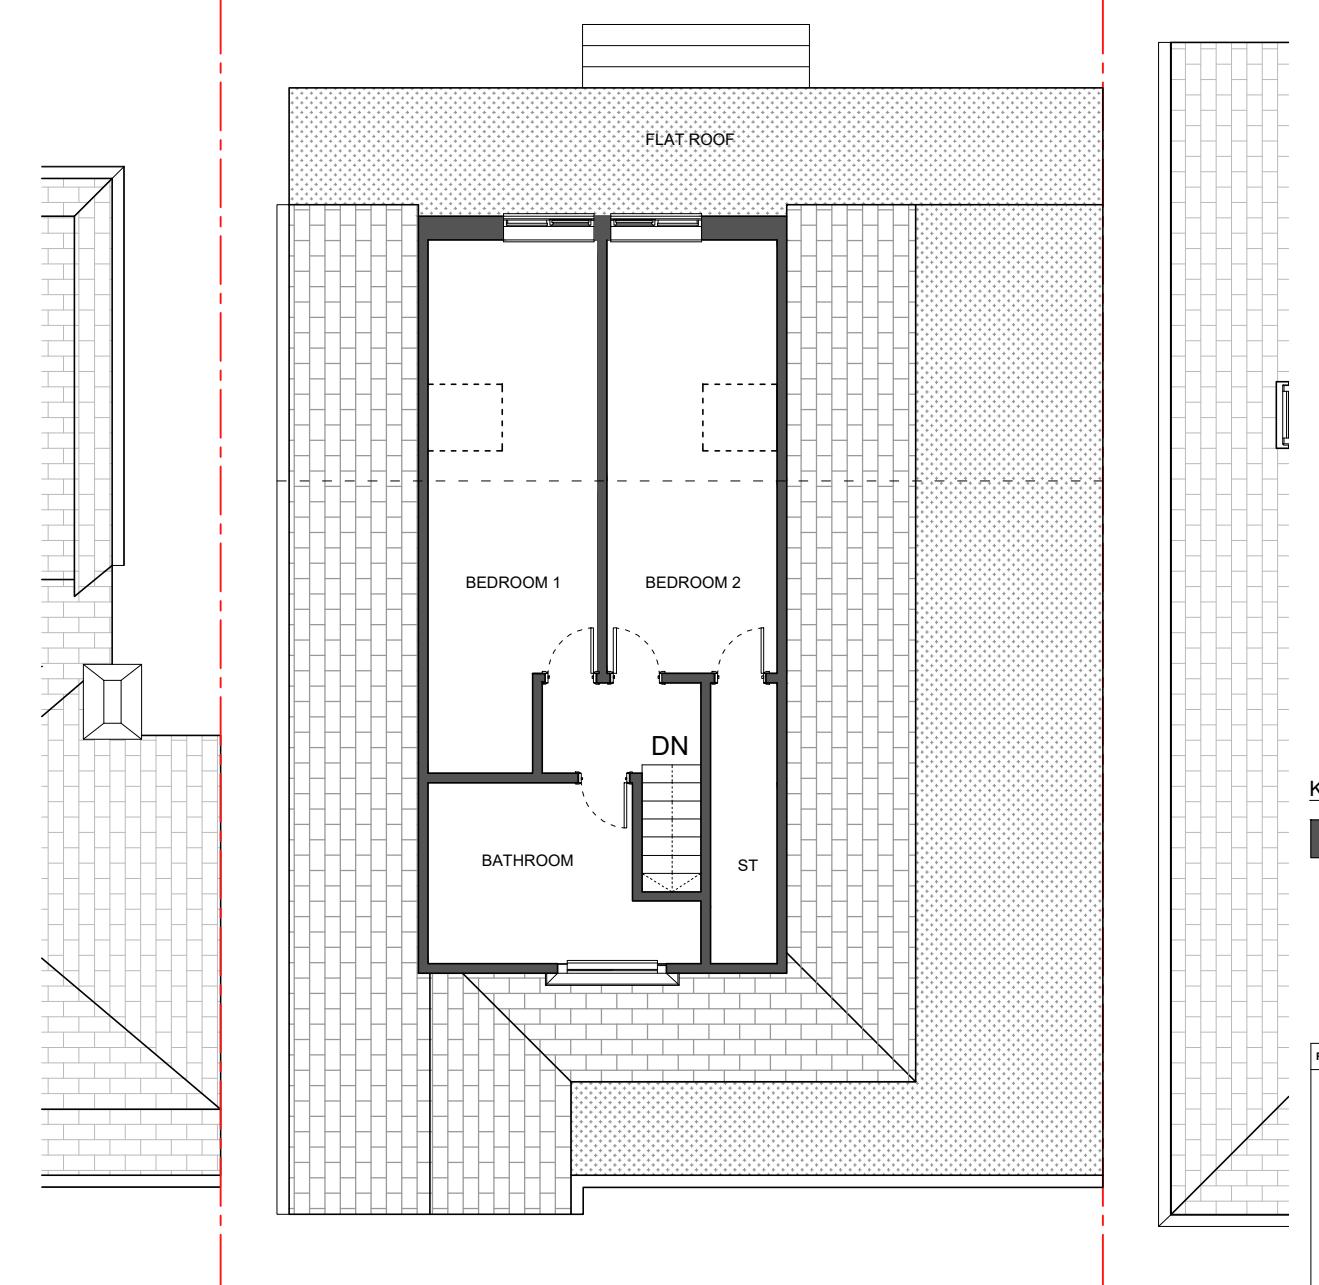

2 AS-BUILT FIRST FLOOR



All dimensions to be checked on site prior to construction.
All drawings to be read in conjunction with structural engineer's drawings.