


**NOTES.**

ALL DIMENSIONS ARE IN mm (UNO).

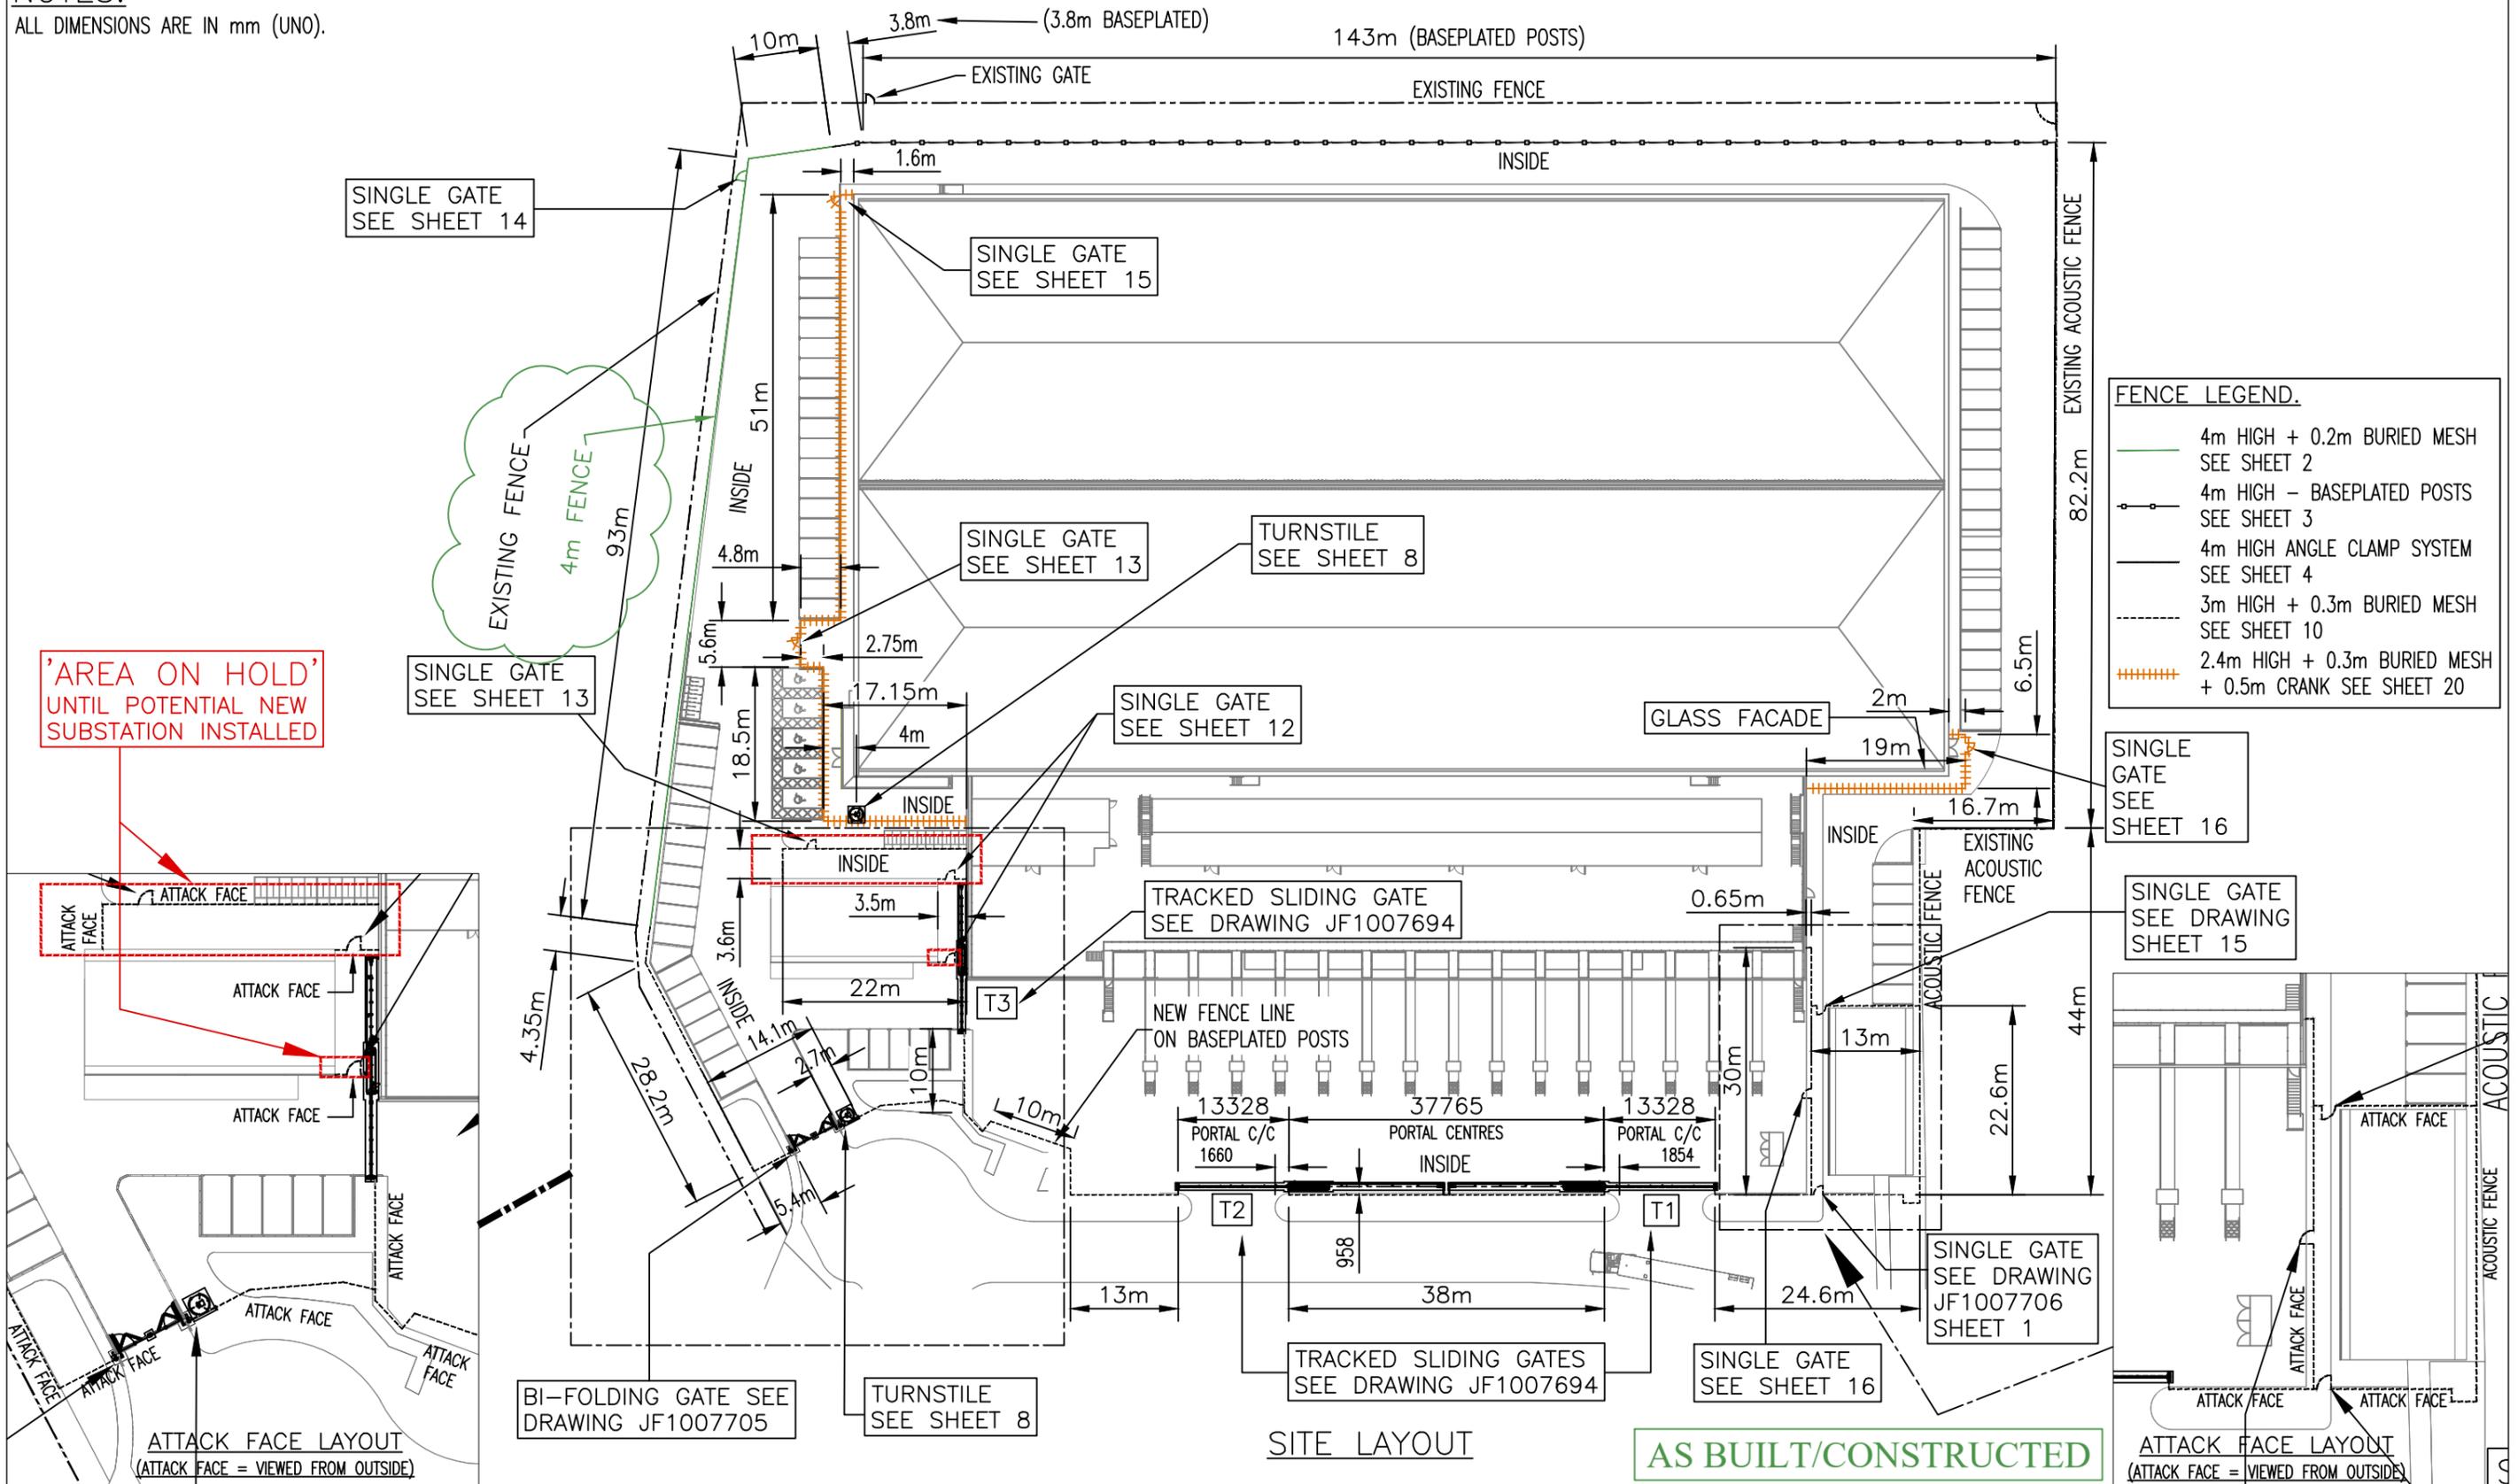

**FENCE LEGEND.**

- 4m HIGH + 0.2m BURIED MESH SEE SHEET 2
- 4m HIGH - BASEPLATED POSTS SEE SHEET 3
- 4m HIGH ANGLE CLAMP SYSTEM SEE SHEET 4
- - - 3m HIGH + 0.3m BURIED MESH SEE SHEET 10
- 2.4m HIGH + 0.3m BURIED MESH + 0.5m CRANK SEE SHEET 20

'AREA ON HOLD'  
UNTIL POTENTIAL NEW  
SUBSTATION INSTALLED

AS BUILT/CONSTRUCTED

**Jacksons Fencing**  
 Stowting Common, Near Ashford, Kent. TN25 6BN  
 Telephone: 01233 750393  
 Fax: 01233 750403  
 www.jacksons-fencing.co.uk  
 www.jacksons-security.co.uk

This Drawing Is The Property Of H.S. Jackson & Son (Fencing) Ltd, And May Not Be Copied Or Reproduced In Any Way Without Prior Written Permission.

**VIRTUS DATA CENTRES**  
**BOUYGUES ENERGIES & SERVICES**

DO NOT SCALE - IF IN DOUBT ASK

- 08 14/01/2026 4m NOTE ADDED
- 07 30/06/2025 AS BUILT
- 06 28/05/2025 RH SIDE SL NOW PUSHPADS + NOTES
- 05 16/12/2024 SHEET 15 GATE HANDING
- 04 09/12/2024 SHEET 15 GATE ADDED
- 03 09/08/2024 GLASS FACADE FENCING ADDED

Drawn	WB	TITLE	VIRTUS LON 14 SITE LAYOUT	
Date	01/09/2023	CUSTOMER	BOUYGUES UK	
Checked	WB	ACK No.	2303707, 2313664, 2312164, 2294540 (F/E)	
Size	A3	Scale	1:750 U.O.S	
			Drawing No.	JF1007686 Sheet 1