



AS BUILT AND PROPOSED FIRST FLOOR PLAN



AS BUILT AND PROPOSED ROOF PLAN

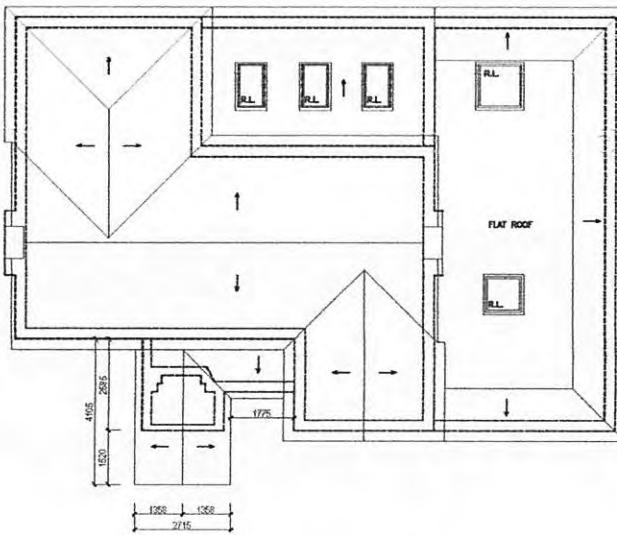

LEGEND:

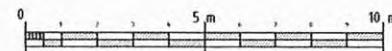

Site	Address	Drawing Title	Date
	58 Long Lane, Ickenham UB10 8SZ	As Built and Proposed First floor and Roof plans	1:100@A3 22/10/23 Drawing No. 003