





AS BUILT AND PROPOSED FRONT ELEVATION




AS BUILT AND PROPOSED SIDE ELEVATION

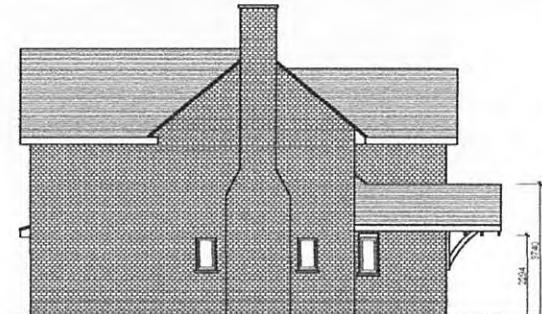

AS BUILT AND PROPOSED REAR ELEVATION

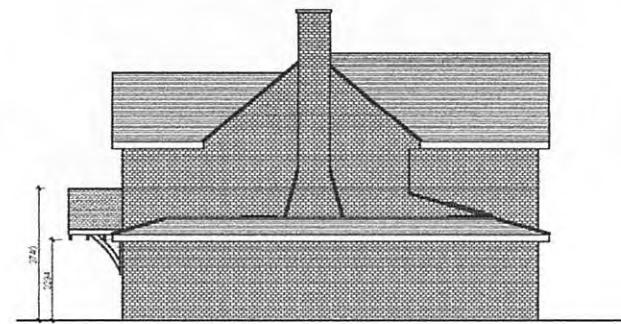

AS BUILT AND PROPOSED SIDE ELEVATION

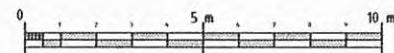

58 Long Lane, Ickenham UB10 8SZ	58 Long Lane, Ickenham UB10 8SZ	As Built and Proposed Front, Rear and Side Elevations	1:100 A3 004
			22/10/23